


T32S R34

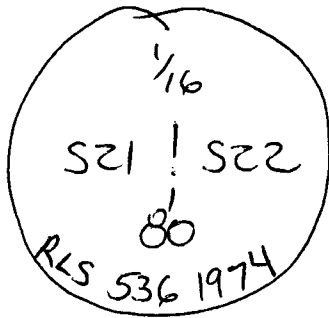

DATE: APRIL 26, 1982

- Condition Report Only
- Not Found
- Renewed
- Unrecorded
- Surveyed In
- Referenced Out

Previous Renewal #'s M 49-69

Monument(s) Found: (Condition and Source) _____

2 1/2" I.A., WITH BRASS CAP MARKED AS ABOVE, FIRMLY SET, PROJECTING 2" ABOVE GROUND, LEANING SLIGHTLY EAST. SET BY GLEN BAUGHMAN, REGISTERED LAND SURVEYOR, NO. 536, IN 1974.

Accessories Found: (Condition and Source) _____

BTS MARKED BY BAUGHMAN IN 1974:
A 20" D. FIR STUMP, N13°E, 42[±] FT. (REC. 43[±] FT.) WITH SCRIBE MARKS "1/16 80 S22 BT" AND BRASS WASHER STAMPED "RLS 536" VISIBLE ON PARTLY HEALED DOUBLE BLAZE
A ROOTHOLE, N25°W, 60[±] FT. (REC. 65[±] FT.) WITH

#2194

18" D. FIR STUMP ALONGSIDE WITH SCRIBE
MARKS "1/16 80 521" AND BRASS WASHER
VISIBLE ON PARTLY HEALED DOUBLE BLAZE.

RENEWAL

Monument Set: (Procedure and Description) _____

New Accessories: (Description) _____

I SCRIBE NEW BTS:

A 5" CHINQUAPIN, N26³/₄°E, 38⁷ FT., MARKED
"1/16 80 522 CS BT" ON DOUBLE BLAZE

A 9" CHINQUAPIN, S13³/₄°W, 45⁸ FT., MARKED
"1/16 80 521 CS BT" ON DOUBLE BLAZE.

RESET 6' STEEL FENCE POST 3 FT. SOUTH WITH USFS SIGNS
#54-2 & #54-9 ATTACHED.

Location and Comments: 21¹/₄°E Compass Declination

USFS Agency

JIM LANDRUM Party Chief

LEONARD Notekeeper

HERZSTEIN Witnesses

AD # 3240.

ok
JEM