


T32S R3W

DATE: 4-21-82

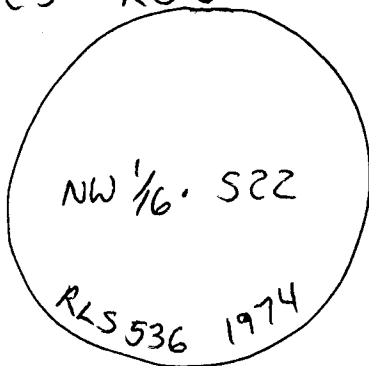

- Condition Report Only
- Not Found
- Renewed
- Unrecorded
- Surveyed In
- Referenced Out

Previous Renewal #'s M49-69

Monument(s) Found: (Condition and Source) \_\_\_\_\_

2 1/2" I.P. WITH BRASS CAP MARKED AS  
 ABOVE, FIRMLY SET, ~~PROX~~ FLUSH WITH  
 1' d, MOUND OF STONE. SET BY  
 GLEN BAUGHMAN, REGISTERED LAND  
 SURVEYOR NO. 536, IN 1974.

Accessories Found: (Condition and Source) \_\_\_\_\_

BTS MARKED BY BAUGHMAN IN 1974. :  
 A 17" D. FIR, S41°E, 245 FT. WITH HEAVED  
 DOUBLE BLAZE.

A 20" MAPLE, MOST SOUTHWESTERLY OF  
 THREE TRUNKS, S86°W, 2615 FT. WITH  
 SCRIBE MARKS "NW 1/4 S22 BT" AND BRASS

WASHER STAMPED "RLS 536" ~~NOT~~ VISIBLE ON  
PARTLY HEALED DOUBLE BLAZE. (BEARING  
IS TO SW TRUNK, NOT TO CENTER  
OF ROOTCROWN)

RENEWAL

Monument Set: (Procedure and Description) \_\_\_\_\_  
\_\_\_\_\_  
\_\_\_\_\_  
\_\_\_\_\_

New Accessories: (Description) \_\_\_\_\_  
\_\_\_\_\_  
\_\_\_\_\_  
\_\_\_\_\_

Location and Comments:	<u>19°E</u>	Compass Declination
	<u>V.S.F.S.</u>	Agency
COR. IS ABOUT	<u>LEONARD HERSTEIN</u>	Party Chief
190 FT., 505°W,	_____	Notekeeper
OF 20' X 15'	<u>JIM LANORVM</u>	Witnesses
LOG CABIN.	_____	
	_____	

OK  
JEM