


T32S R3W

DATE: JUNE 2, 1982

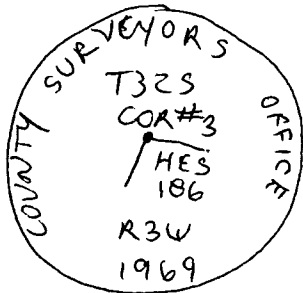

- Condition Report Only
- Not Found
- Renewed
- Unrecorded
- Surveyed In
- Referenced Out

Previous Renewal #'s 135

Monument(s) Found: (Condition and Source) \_\_\_\_\_

1 1/4" IP, WITH BRASS CAP MARKED AS ABOVE, FIRMLY SET, PROJECTING 12" ABOVE ~~BE~~ GROUND; SET BY VERNON TRACY, ~~THE~~ DOUGLAS COUNTY SURVEYOR'S OFFICE, IN 1969. ORIGINAL CORNER STONE, MARKED "+" ON SOUTHSIDE AND "3HES186" ON WEST SIDE, FOUND LYING ALONGSIDE.

Accessories Found: (Condition and Source) \_\_\_\_\_

REMAINS OF ORIGINAL BTS:

A 30" D. FIR STUMP, S56°W, 19<sup>8</sup> FT., WITH SCRIBE MARKS "3 HES 186 BT" VISIBLE ON PREVIOUSLY OPENED BLAZE.

A 40" D. FIR STUMP, N44°W, 11<sup>2</sup> FT., WITH NO MARKS VISIBLE ON PREVIOUSLY OPENED

BLAZE.

BTS MARKED BY TRACY IN 1969:

A 8" W. FIR, S13°W, 25<sup>1</sup>/<sub>2</sub> FT., WITH HEALED BLAZE.

A 8" W. FIR, N24°W, 24<sup>3</sup>/<sub>4</sub> FT., WITH HEALED BLAZE.

RENEWAL

Monument Set: (Procedure and Description) \_\_\_\_\_

New Accessories: (Description) \_\_\_\_\_

Location and Comments:	<u>19°E</u>	Compass Declination
	<u>U.S.F.S.</u>	Agency
CORNER LIES AT	<u>Jim LANDRUM</u>	Party Chief
END OF <del>THE</del> OLD		Notekeeper
FENCE LINE,	<u>Leonard Hertzstein</u>	Witnesses
BEARING EAST.		OK LEM