


T325 R3W

DATE: JUNE 10, 1982

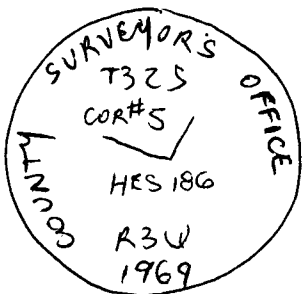

Condition Report Only
 Not Found
 Renewed
 Unrecorded
 Surveyed In
 Referenced Out

Previous Renewal #'s 137

Monument(s) Found: (Condition and Source)

1/4" I.P., WITH BRASS CAP MARKED AS
ABOVE, FIRMLY SET, PROJECTING 12"
ABOVE GROUND; SET BY VERNON
TRACY, DOUGLAS COUNTY SURVEYOR'S
OFFICE, IN 1969.

Accessories Found: (Condition and Source)

ORIGINAL BTS:

A 22" D. FIR, ~~BE~~ S54°45'W, 15[±] FT., WITH
HEALED BLAZE.

A D. FIR ~~SE~~ ROOT CROWN, SIZE INDETERMINATE,
N42°40'W, 15[±] FT., WITH NO MARKS VISIBLE.

BTS MARKED BY TRACY IN 1969:

222

C. S. File No. 61/32-22

Page 1 of 1

14" D. FIR, S15°E, 24⁵ FT., WITH HEALED BLAZE.

RENEWAL

Monument Set: (Procedure and Description) _____

ADD 2' d, MOUND OF STONE, I.P.
NOW PROJECTS 6" ABOVE MOUND
OF STONE.

New Accessories: (Description) _____

Location and Comments: _____ 19°E _____ Compass Declination

_____ U.S.F.S. _____ Agency

_____ LEONARD HERSTEIN _____ Party Chief
_____ Notekeeper

_____ JIM LANDRUM _____ Witnesses

OK
JLH