


T32S R3W

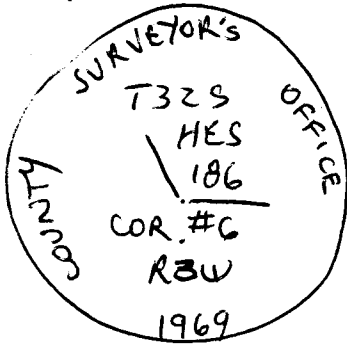

DATE: APRIL 21, 1982

- Condition Report Only
- Not Found
- Renewed
- Unrecorded
- Surveyed In
- Referenced Out

Previous Renewal #'s 138

Monument(s) Found: (Condition and Source) _____

1 1/2" I.P., WITH BRASS CAP MARKED AS ABOVE,
FIRMLY SET, PROJECTING 9" ABOVE GROUND.
SET BY VERNON TRACY, DOUGLAS COUNTY
SURVEYOR'S OFFICE, IN 1969. ORIGINAL ~~STONE~~
CORNER STONE WITH MARKS "+" ON NE
FACE AND "6HES 186" ON TOP SET ALONGSIDE.

Accessories Found: (Condition and Source) _____

BTS MARKED BY TRACY IN 1969:

A 12" O. FIR, N4°E, 12 3/4 FT., WITH HEALED BLAZE

A 13" W. FIR, N74°E, 8 1/2 FT., WITH HEALED BLAZE

REMAINING ORIGINAL BT:

A 44" O. FIR STUMP, S80 3/4°E, 57 1/4 FT. WITH SCRIBE
MARKS "186" VISIBLE ON PREVIOUSLY OPENED BLAZE.

ORIG. SW BT. NOW FALLS IN NEW ROAD.

RENEWAL

Monument Set: (Procedure and Description)

New Accessories: (Description)

Location and Comments:

CORNER IS 30 FT.

NE OF USFS

RD.# 3231-C.

U.S.F.S.

LEONARD HEZSTEN

JIM LANDRUM.

Compass Declination

Agency

Party Chief

Notekeeper

Witnesses

OK
fcm