


T32S R3W

DATE: APRIL 28, 1982

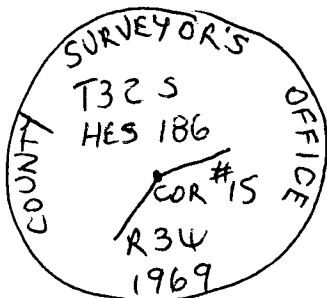

- Condition Report Only
- Not Found
- Renewed
- Unrecorded
- Surveyed In
- Referenced Out

Previous Renewal #'s 144

Monument(s) Found: (Condition and Source) _____

1" I.P., WITH BRASS CAP MARKED AS ABOVE,
LOOSELY SET, PROJECTING 16" ABOVE GROUND.

SET BY VERNON TRACY, DOUGLAS COUNTY
SURVEYOR'S OFFICE, IN 1969. ORIGINAL

CORNER STONE ALONGSIDE WITH MARKS
"15 HES 186" ON BOTTOM SIDE.

Accessories Found: (Condition and Source) _____

BT MARKED BY TRACY IN 1969:

A 10" D. FIR, S77°E, 34° FT. (REC. 34⁶ FT.) WITH
HEALED BLAZE.

~~NO~~ ORIGINAL SW BT. FALLS IN CREEK FOUND
NO EVIDENCE OF IT.

COR. #16, HES 186, BEARS N77°E, 85⁷ FT. (REC.

#217X

86± FT.)

RENEWAL

Monument Set: (Procedure and Description) _____

RESET I.P. & BRASS CAP, WHICH NOW
PROJECTS 12" ABOVE 2'd, MOUND OF STONE.
BURIED ORIGINAL CORNER STONE ALONGSIDE.

New Accessories: (Description) _____

I ~~SET~~ MARKED NEW BT.:
A 10" D. FIR, N02°E, 54[±] FT., SCRIBED "15 HES
186 CS BT" ON DOUBLE BLAZE. (THIS BT IS
ON WEST SIDE OF APPLGATE CREEK)
SET 6 FT. STEEL FENCE POST N77°E, 16 FT. WITH USFS
SIGN #54-4 ATTACHED.

Location and Comments:

COR. IS 10 FT. EAST
OF APPLGATE
CREEK AND
ABOUT 40 FT.
EAST OF USFS

18°E
U.S.F.S.
JIM CARROLL
LEONARD HERZSTEIN

Compass Declination

Agency
Party Chief
Notekeeper

Witnesses

OK
Jem

RD# 3231 @ ROCK QUARRY.