

RENEWAL

Monument Set (Procedure and Description)

Monument Detail

USING THE ORIG. BT'S FD I PLACE A 5/8" X 30" IR W/ 1/4" DIA 6" BELOW THE GROUND I DO NOT SET A BRASS CAP DUE TO LOGGING BEING IN PROGRESS. BEARING AND DISTANCES USED TO SET IR ARE AS FOLLOWS:


- 30" HEMLOCK STUMP BEARS N59E 33° (REG N63E 33°)
- 30" HEMLOCK SNAG BEARS S29E 54 1/2 (SAME AS RECORD.)
- 48" CEDAR BEARS S55°W 37° (SAME AS RECORD)
- 28" CEDAR BEARS N30W 31 1/2 (SAME AS RECORD)

DOUGLAS
SEC 30
COR
1982
SURVEYOR

New Accessories

- "W" NAIL IN BASE OF 48" CEDAR BEARS S55°W 34 3/4 FT.
- "W" NAIL IN BASE OF 28" CEDAR BEARS N30°W 29 1/2 FT.
- "W" NAIL IN BASE OF 16" HEMLOCK BEARS S60°E 7° FT.
- "W" NAIL IN BASE OF 18" HEMLOCK BEARS N44°E 13 1/2 FT.
- "PK" NAIL IN BASE OF 20" HEMLOCK BEARS N79°W 26° FT.

Sketch of Monument, Accessories, and General Area

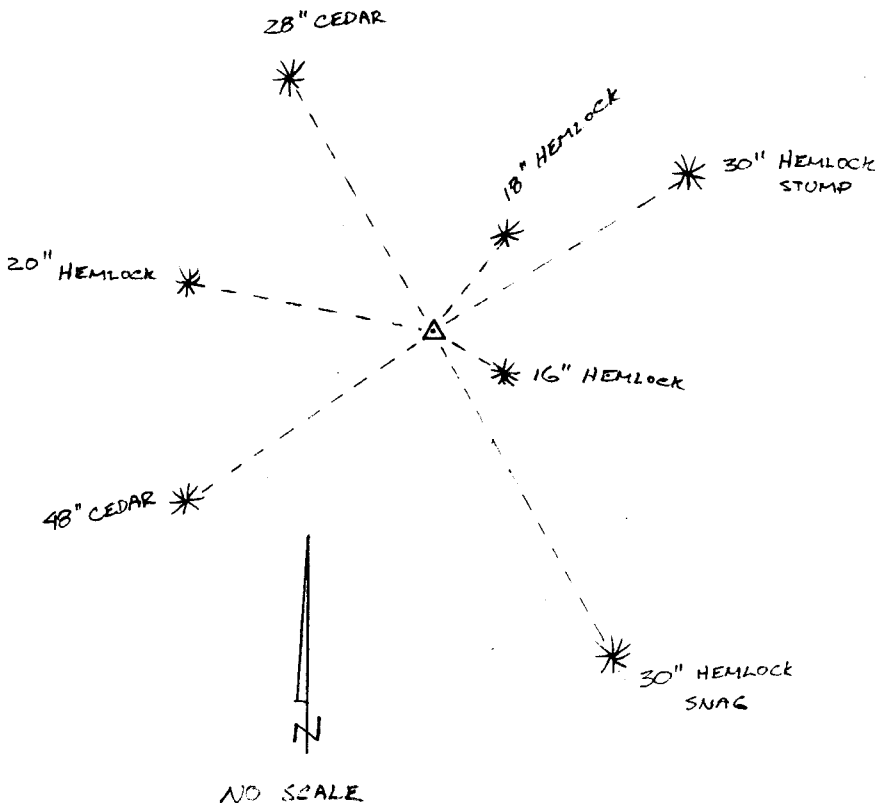

Location & Comments

Comp. Declin. 19° E
Agency DCSO
Party Chief GREGORY E. QUIBELL
Notekeeper Gregory E. Quibell
Witnesses JOHN POWELL

Surveyor's Seal

REGISTERED
PROFESSIONAL
LAND SURVEYOR

Gregory E. Quibell

OREGON
JULY 13, 1979
GREGORY E. QUIBELL
1834

OK
Jem