

GOVERNMENT CORNER RESTORATION FORM

Township 27S Range 8W Sec. 22 County DOUGLAS

State OR Date 5-4-82 No. _____

Corner Designation T27S RBW

22 | 23
27 | 26

- Condition Report Only
- Not Found
- Renewed
- Unrecorded
- Surveyed In
- Referenced Out

Previous Renewals

Monument(s) Found: (Condition and Source)

FD. UNRECORDED 3/4" IP FIRMLY SET
PROTRUDING 6" OUT OF GROUND.

ORIG. "X" ON ROCK APPEARS TO
BE BURIED BY 4'-6" OF DIRT &
SLASH FROM OLD LOGGING.

Accessories Found:

FD. ORIG. 48" FIR NOW 56" STUMP WITH GOOD SCAR. I
OPEN BLAZE AND FIND SCRIBED "S 1" ON A BURNED
OVER FACE.

THE OTHER 3 ORIG. BT'S ARE GONE.

MONUMENT DETAIL

RENEWAL

Monument Set (Procedure and Description)

Monument Detail

SINCE THE FOUND UNRECORDED 3/4" IP DOES NOT FIT THE ORIG. BT AT ALL, I SET THE SEC COR. AT REC. BEARING & DISTANCE FROM ORIG. SE BT. (N23W 50± FT.) COR. FALLS ON LARGE ROOT FROM BIG FIR STUMP & ROOT WAD BURIED BY OLD LOGGING ACTIVITY. I THEREFORE SET A 56" x 15" IR WITH ALUM. CAP IN SAID ROOT.

FD. 3/4" IP BEARS N 20°W 32± FT. FROM SET 5/8" IR.

DOUGLAS CO.
SEC
COR
1982
SURVEYOR


New Accessories

23" CEDAR SCRIBED "T 275 RBW S 27 CS BT" IN DOUBLE BLAZE BEARS S 47°W 32± FT

"PK" NAIL IN TOP OF 60" FIR STUMP BEARS N 79°W 33± TO NAIL.

Sketch of Monument, Accessories, and General Area

Location & Comments

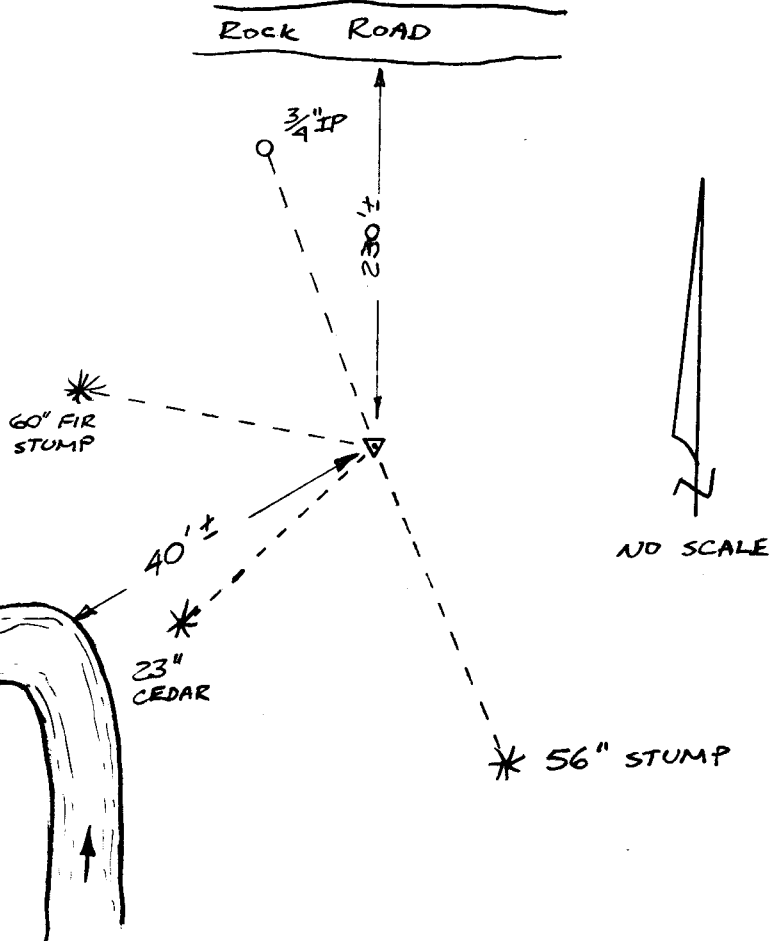

COR LIES APPROX. 200' BELOW ROAD ON A VERY STEEP ROCK SLOPE.

Comp. Declin. 19° E
Agency DCS
Party Chief GREGORY E. QUIBELL
Notekeeper Gregory E. Quibell
Witnesses JOHN POWELL

012
LEM

Surveyor's Seal

REGISTERED
PROFESSIONAL
LAND SURVEYOR

Gregory E. Quibell

OREGON
JULY 13, 1979
GREGORY E. QUIBELL
1834