

RENEWAL

Monument Set (Procedure and Description)

Monument Detail

AT REC. BEARING & DISTANCE (S22W 31²)
 FROM THE ORIG. 36" NOW 44" FIR BT
 I SET A 1" x 30" IP WITH BRASS
 CAP ATTACHED STAMPED AS PER
 DETAIL ON RT.


DOUGLAS COUNTY SURVEYORS
 T275
 1/4 S23 | S24
 R8W
 1982
 OFFICE

New Accessories

42" FIR SCRIBED "1/4 S23 CS BT" IN DOUBLE BLAZE, BEARS S34W 20³ FT.
 30" FIR SCRIBED "1/4 S24 CS BT" IN DOUBLE BLAZE, BEARS S52E 31⁴ FT.
 42" FIR WITH "W" NAIL IN FACE BEARS S84W 11² TO NAIL.

Sketch of Monument, Accessories, and General Area

Location & Comments

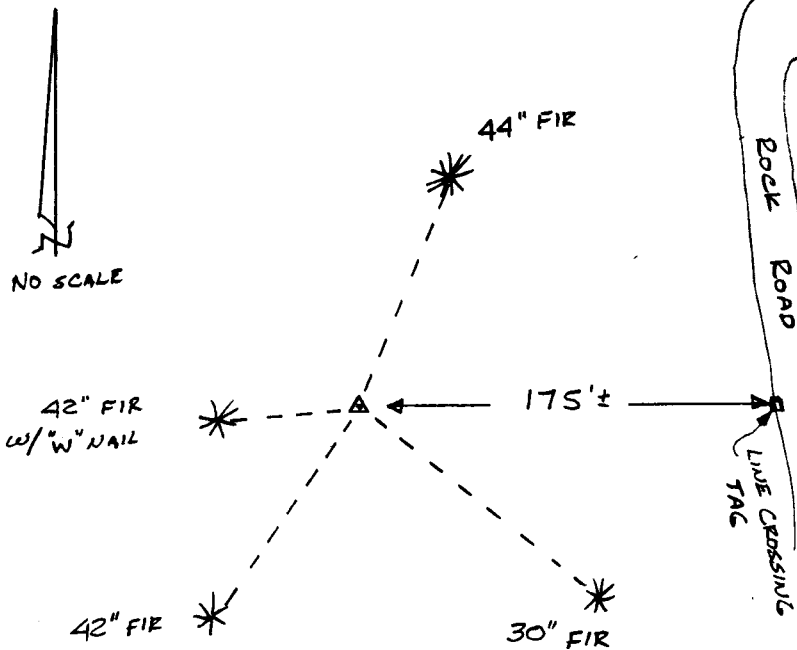

Comp. Declin. 19° E
 Agency DCSO
 Party Chief GREGORY E. QUIBELL
 Notekeeper Gregory E. Quibell
 Witnesses JOHN POWELL

Surveyor's Seal

REGISTERED
 PROFESSIONAL
 LAND SURVEYOR

Gregory E. Quibell

OREGON
 JULY 13, 1979
 GREGORY E. QUIBELL
 1834

DRM