



RENEWAL

Monument Set (Procedure and Description)

AT RECORD BEARING & DISTANCE  
 (N 28 E 5 1/2 FL) FROM ORG 18" NOW  
 23" HEMLOCK BT. I SET A 1"x30"  
 IP WITH BRASS CAP ATTACHED. DUE  
 TO LARGE ROOT I COULD ONLY  
 SET IP 8" INTO THE GROUND. I  
 THEN SURROUND THE IP WITH LOGS  
 APPROX- 15" IN DIAMETER AND THEN  
 FILLED THE CENTER IN WITH DIRT  
 MAKING A MOUND APPROX 3' SQUARE  
 AND 15" DEEP


Monument Detail

DOUGLARS 1/4  
 CO SURVEYOR  
 T 27 S  
 S 24  
 S 2 S  
 R 8 W  
 1982

New Accessories

19" HEMLOCK SCRIBED " 1/4 S 2 S C S BT " IN DOUBLE BLAZE, BEARS S 86° E 69 1/2 FT.  
 42" HEMLOCK SCRIBED " 1/4 S 24 C S BT " IN DOUBLE BLAZE, BEARS N 68° W 21 1/2 FT.  
 26" HEMLOCK WITH "W" NAIL IN FACE WHICH I SCRIBE " 1/4 S 24 C S BT " IN DOUBLE  
 BLAZE BEARS N 3 1/2° E 22 1/2 TO NAIL

Sketch of Monument, Accessories, and General Area

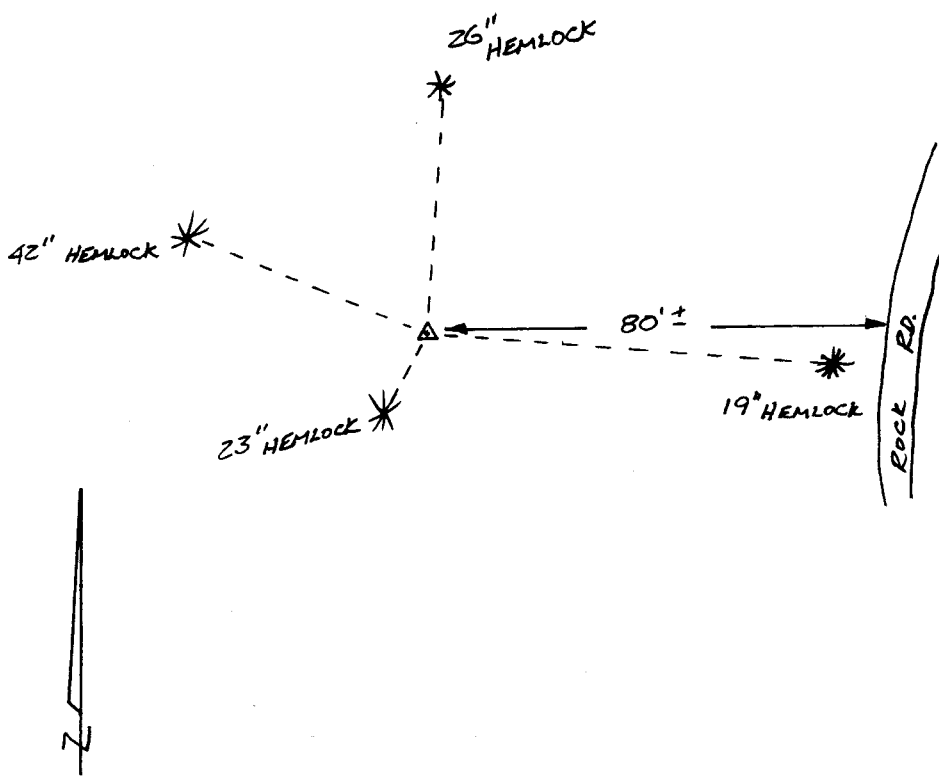

Location & Comments

Comp. Declin. 19° E  
 Agency DC SO  
 Party Chief GREGORY E. QUIBELL  
 Notekeeper Gregory E. Quibell  
 Witnesses JOHN POWELL

OK  
 2/27/79

SURVEYOR'S Seal  
**REGISTERED**  
**PROFESSIONAL**  
**LAND SURVEYOR**  
*Gregory E. Quibell*  
 OREGON  
 JULY 13, 1979  
 GREGORY E. QUIBELL  
 1834

NO SCALE