

GOVERNMENT CORNER RESTORATION FORM

Township 23S Range 6W Sec. SW2 County DOUGLAS

State OREGON Date 5-25-82 No. \_\_\_\_\_

Corner Designation

- \_\_\_\_\_ Condition Report Only
- \_\_\_\_\_ Not Found
- Renewed
- \_\_\_\_\_ Unrecorded
- \_\_\_\_\_ Surveyed In
- \_\_\_\_\_ Referenced Out

Previous Renewals 1943 RESURVEY

Monument(s) Found: (Condition and Source)

A 2 IN. DIAM. IRON PIPE WITH BRASS  
CAP MARKED U.S. GENERAL LAND  
OFFICE SURVEY "T235R6W S3 S2  
S10 S11" 1943 PROTRUDING 1.25 FT.  
ABOVE GROUND.

MONUMENT DETAIL

U S GENERAL LAND OFFICE SURVEY  
 PENALTY \$250 FOR REMOVAL  
 T235R6W  

S3	S2
S10	S11

 1943

Accessories Found:

NO ORIGINALS FOUND

A 25 IN. DIAM. CEDAR NOW 34 IN., BEARS N. 31 3/4° E., 58.1 FT. DIST.  
WITH WELL HEALED DOUBLE BLAZE.

A 50 IN. DIAM. FIR NOW 56 IN., BEARS S. 79° E., 17.8 FT. DIST.  
WITH A WELL HEALED PREVIOUSLY CHOPPED OPEN SCAR.

OTHER BTS FALL IN SLIDE AREA - FOUND NO TRACE OF  
BTS AT RECORD BEARING AND DISTANCES.

#75x

RENEWAL

Monument Set (Procedure and Description)


Monument Detail

LEFT CAP IN POSITION TO  
PERPETUATE 1943 RESURVEY

New Accessories

A 7 IN. DIAM. ASH BEARS S. 43° W., 33.4 FT. DIST. BARK SCRIBED  
" T23S R6W S10 CS BT" & HORIZONTALLY DOWN TREE TRUNK.  
A 7 IN. DIAM. FIR BEARS N. 32° W., 14.7 FT. DIST. SCRIBED " T23S R6W  
S3 CS BT" IN A DOUBLE BLAZE.

Sketch of Monument, Accessories, and General Area

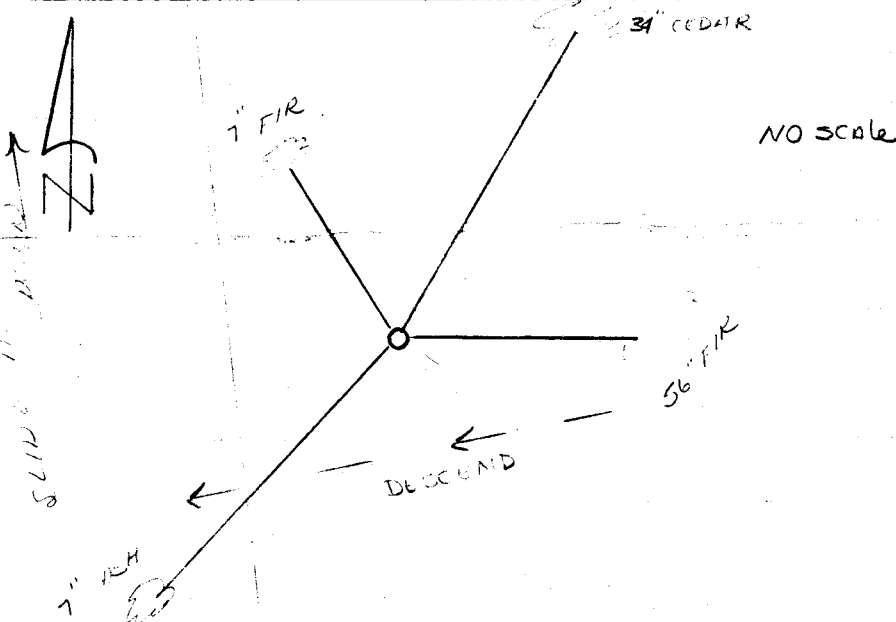

Location & Comments

APPROX: 200± FT. SOUTHERLY  
OF ANDREW CRK.

Comp. Declin. 19° EAST  
Agency DCSO  
Party Chief KAREN REED  
Notekeeper KAREN REED  
Witnesses TERRIE R. PLOUFF

Surveyor's Seal

REGISTERED  
PROFESSIONAL  
LAND SURVEYOR

*Larry E. Monrean*

OREGON  
JULY 13, 1979  
LARRY E. MONREAN  
#1830

5-6-82

Karen -

Jake Jelly called me last night re. a corner I had asked about - so relayed info. about corners you had asked about -

T. 23-6

$\frac{3}{10} / \frac{2}{11}$

ORIG 1879 3 maple  
1 Hemlock

RESURVEY 1943  
FD. OLD STAKE (ORIG.)  
NO ORIG. B.T.S

\* THE FD. 50" FIR 580'E 33' L.S.  
JAKE FEELS THE 1943 CREW  
TIED IN THIS TREE & IT HAD NOT  
BEEN OF RECORD - THE OLD  
STAKE WAS THE EVIDENCE  
ACCEPTED AS CORNER -

SCAR AT THAT TIME (1943) WAS  
CONSIDERED LESS THAN 60 YRS.

$\frac{1}{4}$  COR  $\frac{1}{12}$

JAKE KNOWS NOTHING - HAS NOT BEEN  
TO IT.

G & E No. 61/36-14 ✓