

RENEWAL

Monument Set (Procedure and Description)

AT THE LOCATION OF THE FD. 3/4" IP
I SET A 1"x30" IP WITH BRASS CAP
ATTACHED PROTRUDING 9" OUT OF GROUND
I PLACE FD IP ALONG NORTH
EDGE OF BRASS CAP.


Monument Detail

DOUGLAS CO SURVEYOR
T275
1/4 S15/S14
RBW
1982

New Accessories

SPIKE STAMPED "BO1" SET IN TOP OF 76" FIR STUMP BEARS N54W 31 1/2.
SPIKE STAMPED "BO2" SET IN TOP OF 35" HEMLOCK STUMP BEARS S10E 34 1/2
"W" NAIL FD IN FACE OF 20" HEMLOCK STUMP BEARS N76 1/2 W 30.

Sketch of Monument, Accessories, and General Area

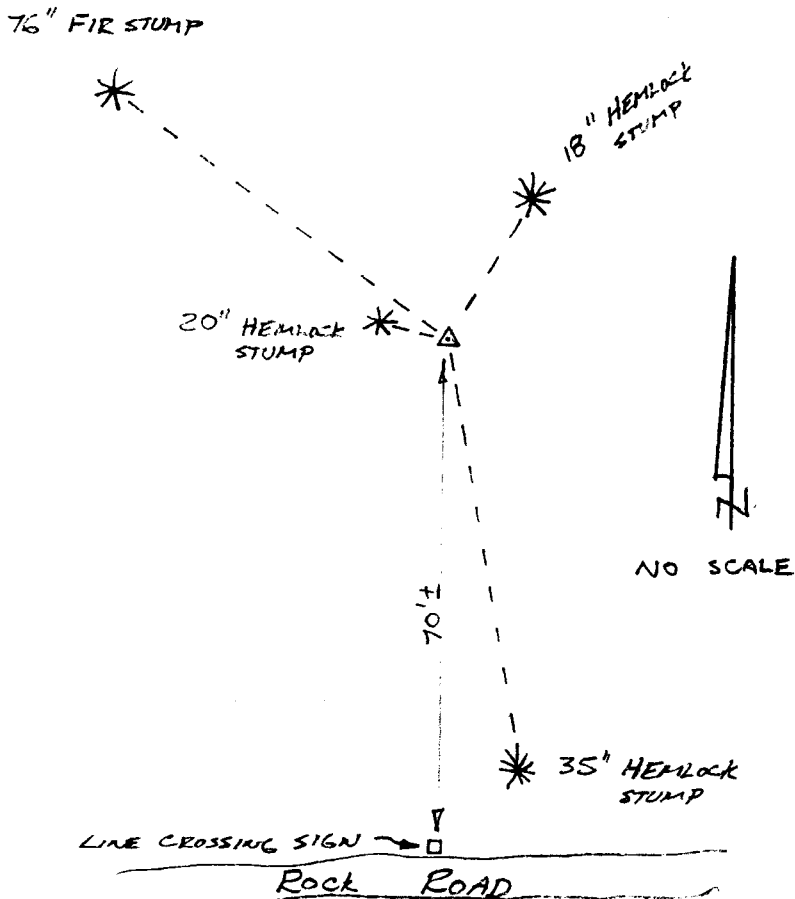

Location & Comments

DCSO BT TAG'S PUT
ON ALL STUMPS.

Comp. Declin. 19° E
Agency DCSO
Party Chief GREGORY E. QUIBELL
Notekeeper Gregory E. Quibell
Witnesses JOHN POWELL

Surveyor's Seal

OK JEM

REGISTERED
PROFESSIONAL
LAND SURVEYOR

Gregory E. Quibell

OREGON
JULY 13, 1979
GREGORY E. QUIBELL
1834