

GOVERNMENT CORNER RESTORATION FORM

Township 29 S Range 7 W Sec. 2 County DOUGLAS
 State OR. Date 6-14-82 No. _____

Corner Designation T 28 S
 R S34 | S35
 7 S3 | S2
 W
 T 29 S

- Condition Report Only
- Not Found
- Renewed
- Unrecorded
- Surveyed In
- Referenced Out

Previous Renewals #102, #211 ^{T29-7} #171 ^{T28-7}

MONUMENT DETAIL

Monument(s) Found: (Condition and Source)

FD UNRECORDED BLM BRASS CAP
 FIRMLY SET FLUSH WITH GROUND.
 BRASS CAP IS IN N-S FENCE
 LINE ON WESTERLY SIDE OF
 GRAVEL ROAD.

T 28 S R 7 W
 S 34 | S 35
 S 3 | S 2
 T 29 S
 1981

Accessories Found:

- ① FD. ORIG. 30" W. OAK NOW 40", DOWN, & ROTTING. THIS TREE HAD BEEN PREVIOUSLY OPENED TO EXPOSE SCRIBING, HOWEVER NO SCRIBING IS VISIBLE AT THIS TIME. TREE BEARS N73E 133 1/2 FT. AS PER REN. #211. T29-7
- ② FD. 34" NOW 36" W. OAK WITH GOOD DOUBLE BLAZE (WELL HEALED) BEARS N26°W 410 1/2 (REG. PER REN. #102 N24 1/2 W 410.0 AND REG. PER REN. #211 N24 1/2 W 408 1/2)
- ③ FD. DEPRESSION, POSSIBLE STUMP HOLE OF ORIG. 30" B. OAK BEARS S59°E 104 1/2 (REG. PER REN. #102 S59E 102 1/2)
- ④ FD. BLM BRASS CAP REF. MARK STAMPED "RM S35 55 1/2 TO COR T28S R7W 1981" BEARS N44E 55 1/2.
- ⑤ FD. BLM BRASS CAP REF. MARK STAMPED "RM S2 69 1/2 TO COR T29S R7W 1981" BEARS S37°E 69 1/2.
- ⑥ FD. BLM BRASS CAP REF. MARK STAMPED "RM S34 6 1/2 TO COR T28S R7W 1981" BEARS N34W 6 1/2.
- ⑦ FD. BLM BRASS CAP REF. MARK STAMPED "RM S3 6 1/2 TO COR T29S R7W 1981" BEARS S46W 6 1/2.

#273 T29-7 X
 #244 T28-7 X

CONT.

G & B No. 1/36-23

Marvin
For J
July
C.S.

8" W. Fir bears N.68¹/₂°W. 29 lks. dist., mks. ¹/₄ S27 RS404 BT.
18" D. Fir bears N.57°W. 30 lks. dist., mks. ¹/₄ S22 RS404 BT.

98

James W. Byron, Deputy
Milo Godfrey
Clete Putnam
Nov. 2, 1960
C.S. File No. 49/139

West ¹/₄ Corner to Section 7.
Found - Brass Cap at Corner & W. P. N.82°43'W. 1.93 chs. (1924)
B. T's. gone, renewed BT's., now stumps.
New BT's: 4" Laurel bears S.22°E. 74.0 ft. scribed ¹/₄ S 7 CS BT.
15" B.Oak bears N.13°E. 40.0 ft. scribed ¹/₄ S7 CS BT.

W. P. N.82°43'W. 1.93 ch. from W. ¹/₄ corner Section 7.
Found - Brass Cap at Corner & BT's. as recorded by Mensch, 1924.
All are now stumps. I open NE BT. & find good scribing "B".
New BT's: 7" R.Fir bears S.42°W. 31.0 ft. scribed W.P. CS BT.
10" R.Fir bears S.29°E. 40.4 ft. scribed W.P. CS BT.

98A

James W. Byron, Deputy
Milo Godfrey
Clete Putnam
April 1961
C.S. File No. 49/50

¹/₄ Corner to Sec. 5, T29-7W. & Sec. 32, T28-7W.
Found - 2" x 2" Stake at Corner & 27" B.Oak N.44°W. 36.0 ft., shows
good scribing "¹/₄ S32 BT". REN. NO. 21
26" Fir Stump bears S.79°W. 52.0 ft. We open near base &
find good scribing "T".

99

Stump Section of 30" B.Oak, shows old scar N.39°W. 28.0 ft.
Set - Brass Cap alongside Corner Stake & Mark County Surveyor's
¹/₄ S32 T28S R7W Office, 1961
S 5 T29S
New BT: 6" R.Fir bears S.51°W. 25.4 ft. scribed ¹/₄ S 5 CSBT.

202

See renewal of this corner by Irving, Cor. No. 21. Refer also to
Corner No. 49. Not the same corner.

Renew Sec. 6, T29-7W. & Sec. 31, T28-7W.
Found - Both Fir BT's. Recorded by Mensch, each is now down.
We open & find good scribing.
Brass Cap (1924) not found.

100

Set Brass Cap Mkd: ¹/₄ S31 T28 R7W County Surveyor's
~~Office, 1961~~
New BT's: 6" Cedar bears N.31¹/₂°E. 82.7 ft. scribed S31 T28SR7W 6S BT.
12" R.Fir bears S.28¹/₂°E. 99.7 ft. scribed S 6 T29S R7W CS BT.

¹/₄ Corner to Sec. 6, T29-7W. & Sec. 31, T28-7W.
Found - Brass Cap at Corner & Stump of S.E. BT., REN. NO. 1
Rotted Remains of N. W. BT. found.
New BT's: 5" W.Oak bears S.70°W. scribed ¹/₄ S 6 CS BT.
12" Ash bears N.9°W. 11.6 ft. scribed ¹/₄ S31 CS BT.

101

Section Corner to Sections 2 & 3, T29-7W. & Secs. 34 & 35, T28-7W.
Found - Geared Axle at Corner. Orig. 30", now 36" W.Oak N.73°E. 132 ft., shows good scar. I do not open.
Orig. 30", now 40" down Oak. We open & find good reverse
scribing, "B" (Record S.73°E. 159.7 ft.) We find should be
S.59°E. 102.0 ft.

102

See also # 211

If we use record dist. & bear. to locate Sec. Cor. from SE BT. it
wouldn't check with Real old Stump Section in NW. Quad.
New BT: 34" W.Oak bears N.24¹/₂°W. 410.0 ft. This BT. scribed within
36" the last few years but not of record, See M 12 - 72. # 211

May 19, 1961

159/2
158

C.S. 58/41 6/75

Clell Goodwin
Gary Langlitz
Vic Cangie
Lenora Ladig
10/21/75
CS 57/36

Sec. Corner to Sec. 34 and 35 T28-7 and Sec. 2 & 3 T29-7
Found: Geared axle at fence which has been generally accepted as the corner
From which: An orig. 30" now 40" white oak cut out to reveal reverse scribe
"BT" bears N 73°E 133.4 ft (call: N 73°E., 132.0 ft)
A 37", was 34" white oak bears N 24 1/2°W., 408.6 ft (call by renewal #171:
N 24 1/2°W., 410.0 ft)

211

A 40" down oak in the S E Quadrant with visible scribe marks does not fit call

Center West 1/16 of Sec. 21
Found: U.S.B.L.M. cadastral survey brass cap properly marked 1966)
BT's- A Fir snag 8 (now 9) inch diameter bears N 15°E 10 ft. (rec N 13°E)
scribed "CW 1/16 S21 BT"

210

An oak stump, 18" dia., bears S 8°E., 26.2 ft. (Rec. S11°E, 27.4 ft.) Scribed

36-23
CLELL GOODWIN

N. 0° 57' E. 5257.7'

2667.7

(4)

(33)

(34)

Olath Creek

180° X 236.14s.

Orig. B.T. 30' W.O. Acre marks as shown on in this Eugene Oilwell Freshford 30's Survey Orig. B.T.

2570s.

5140'

(34)

2654'

1144'

2788'

1144'

180°

Can Sec. 3, T29S, R7W, 2432'

2432'

2570s.

2649.6

Surface Logging Road

(2)

Clearing Area

Orig. B.T.

30' W.O. Survey 534' 2' 1/2" B.T. 7285; R7W; S.B.T. is recorded

Locality of original monument on line bet NE & SE Cor. 3.

C.S. 1111 7/1/36-780

BOYER MAY 1957

M 12-72


Se
w
7
on
b
2
o
R
13
14
15
16
17
18
19
20
21
22
23
24

✓ WITH JIM MERRITT
BOB KISCHEL
BOB PALMER

DOUGLAS COUNTY FOREST APPRAISAL DEPARTMENT
REPORT OF SURVEY CORNERS LOCATED

Tp. 29 S. RGE. 7 W., W.M. Corner Found NW Sec. 2 Date Oct. 1949
Photo Location. HL 18-27

Evidence of Cor. Iron axle 2" above ground level. NE BT.

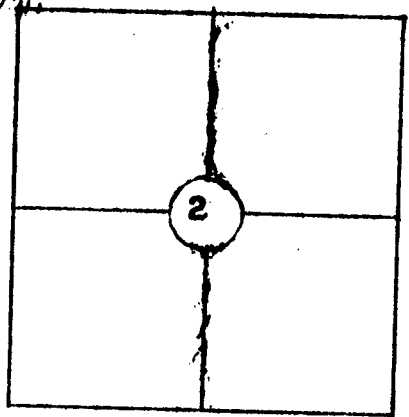

Cor. Location In Reference to Terrain and Cover SW open slope - Gentle, few oaks.

Bearing Trees Found

DESCR'T, ETC.	Dist. & Brg. From Cor.		
Species & Size	NE	24" Oak	
Condition of Scribe		Grown over	
Age or Resurvey BT		Orig.	
Condition of BT		Good	
Other Marks, etc. on BT		None	

OTHER INFORMATION

Stakes or Tags left at Cor or nearby: _____

Point of lines leading to Cor: _____

How Corner Be Best Reached: By aid of photo # HL 18-27.

Notes, etc.: _____

NAME E. E. Givens