

GOVERNMENT CORNER RESTORATION FORM

Township 23 S Range 4 W Sec. 8 County DOUGLAS

State OR. Date 8-5-82 No. _____

Corner Designation T23S R4W

S ¹/₁₆ | S8 | S9

- Condition Report Only
- Not Found
- Renewed
- Unrecorded
- Surveyed In
- Referenced Out

Previous Renewals CS 30/52

MONUMENT DETAIL

Monument(s) Found: (Condition and Source)

FD. OLD FORD TOP BOW FRAME
 SET BY BOYER PER CS. 30/52
 FIRMLY SET FLUSH WITH THE
 GROUND.

Accessories Found:

18" FIR PER CS 30/52 IN N+S FEAKE, NOW 21" STUMP
 WITH GOOD SCAR ALSO SCRIBED "SB" VISIBLE IN SMALL UNHEALED
 BLAZE, BEARS N 74° E 18 1/2 FT. (REC. 17 1/2 FT.)

FD. NO TRACE OF BLAZED 12" TREE 3 FT. SOUTH & 1 FT. WEST
 HOWEVER I DID FIND BADLY ROTTED 14" FIR STUMP N18° E 4° FT.
 NO AXE MARKS EVIDENT.

#172 ✓

G.L. File No. 62/1-5 C

RENEWAL

Monument Set (Procedure and Description)

AT THE LOCATION OF FD. BOW FRAME
I SET 1"x30" IP. WITH BRASS CAP
ATTACHED PROTRUDING 10" OUT OF GROUND.
BOW FRAME FLUSH WITH GROUND AT
NORTH EDGE OF BRASS CAP


Monument Detail

DOUGLAS
S 1/16
CO
T 235
SURVEYOR
S 8 | S 9
RAW
1982

New Accessories

14" FIR SCRIBED "S 1/16 S 8 CS BT" IN DOUBLE BLAZE BEARS S 37 1/2° W 44 1/4 FT.
13" FIR SCRIBED "S 1/16 S 8 CS BT" IN DOUBLE BLAZE BEARS N 44° W 12° FT.
9" FIR SCRIBED "S 1/16 S 9 CS BT" IN DOUBLE BLAZE BEARS N 1° E 22° FT.
8" FIR SCRIBED "S 1/16 S 9 CS BT" IN DOUBLE BLAZE BEARS S 38° E 9 1/2 FT.
OLD FENCE COR. WITH FENCES RUNNING N-S-E & W BEARS EAST 17 1/2 FT.
NOTE FENCES RUNNING NORTH & WEST EXTEND ONLY A SHORT DIST.

Sketch of Monument, Accessories, and General Area

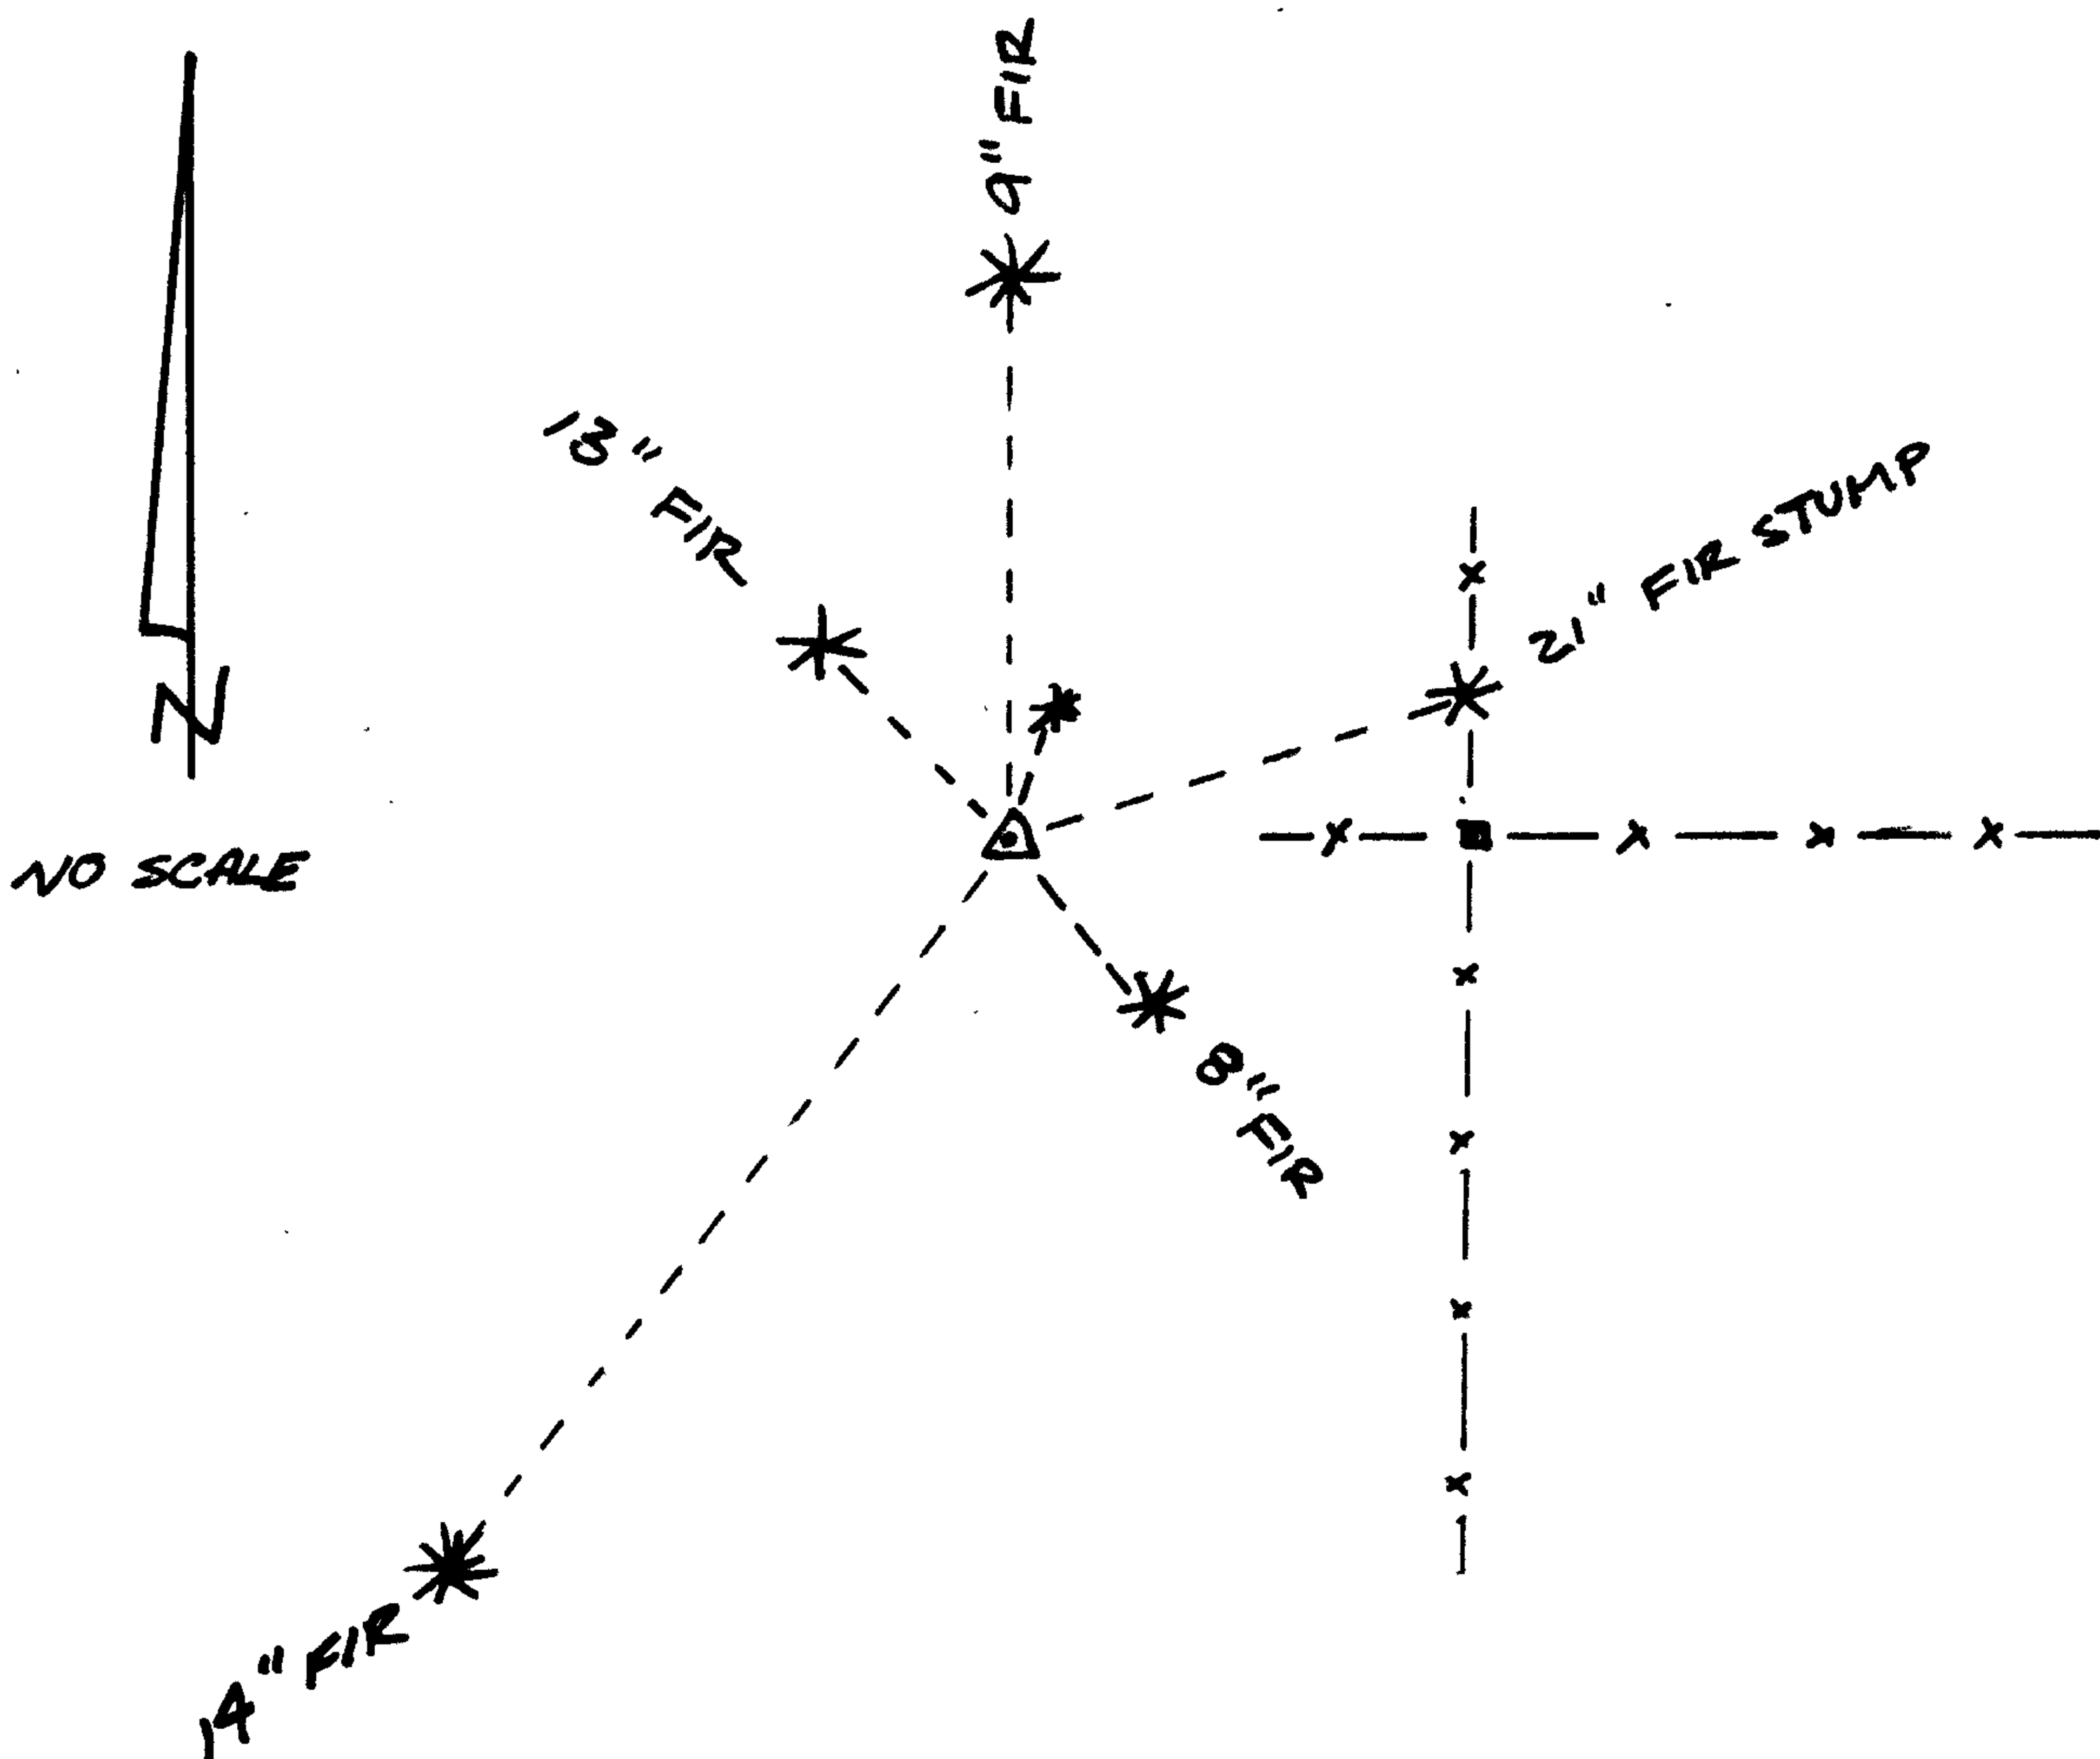

Location & Comments

NEW BT TAGS ON ALL TREES

Comp. Declin. 19° E
Agency DCSD
Party Chief GREGORY E. QUIBELL
Notekeeper Gregory E. Quibell
Witnesses KAREN REED
JOHN POWELL

Surveyor's Seal
REGISTERED
PROFESSIONAL
LAND SURVEYOR

Gregory E. Quibell

OREGON
JULY 13, 1979
GREGORY E. QUIBELL
1834