

GOVERNMENT CORNER RESTORATION FORM

Township 215 Range 10W Sec. 3 County DOUGLAS

State OREGON Date 8-17-82 No. \_\_\_\_\_

Corner Designation

54 | 53  
59 | 510

- \_\_\_\_\_ Condition Report Only
- \_\_\_\_\_ Not Found
- Renewed
- \_\_\_\_\_ Unrecorded
- \_\_\_\_\_ Surveyed In
- \_\_\_\_\_ Referenced Out

Previous Renewals 1919 RESURVEY

MONUMENT DETAIL

Monument(s) Found: (Condition and Source)

A 1" DIAM CONCRETE FILLED  
IRON PIPE BADLY RUSTED  
PROTRUDING .9 FT ABOVE  
GROUND, NO EVIDENCE OF BRASS  
CAP

Accessories Found:

KR 10-25-82

AN ~~ORIG.~~ 36 IN. DIAM. FIR, NOW 60 IN. BEARS N. 10° E., 9.9 FT.  
DIST. WITH A WELL HEALED SINGLE BLAZE. (1919 RESURVEY)

KR 10-25-82

AN ~~ORIG.~~ 7 IN. DIAM. HEMLOCK NOW 26 IN. BEARS S. 45° W.,  
45.5 FT DIST. (REC. S. 42° W.) WITH A WELL HEALED SINGLE  
BLAZE. (1919 RESURVEY)

KR 10-25-82

AN ~~ORIG.~~ 60 IN. DIAM. FIR, NOW 62 IN. BEARS N. 40° W., 31.2 FT  
DIST. (REC 30.4 FT) WITH A WELL HEALED SINGLE BLAZE. (1919  
RESURVEY)

#66 4


62/1-9 c

RENEWAL

Monument Set (Procedure and Description)

I REFERENCE OUT IRON PIPE AND  
 REPLACE SAID PIPE WITH A 1" X 30"  
 IRON PIPE WITH BRASS CAP MARKED  
 " DOUGLAS CO. SURVEYOR OFFICE  
 T215 R10W  
 S4 S3  
 S9 S10  
 1982  
 PROTRUDING 6 IN. ABOVE GROUND  
 IN A 1.5 FT. DIAM MOUND OF STONE.  
 I LAY RUSTED PIPE ALONG EAST SIDE  
 OF BRASS CAP


Monument Detail

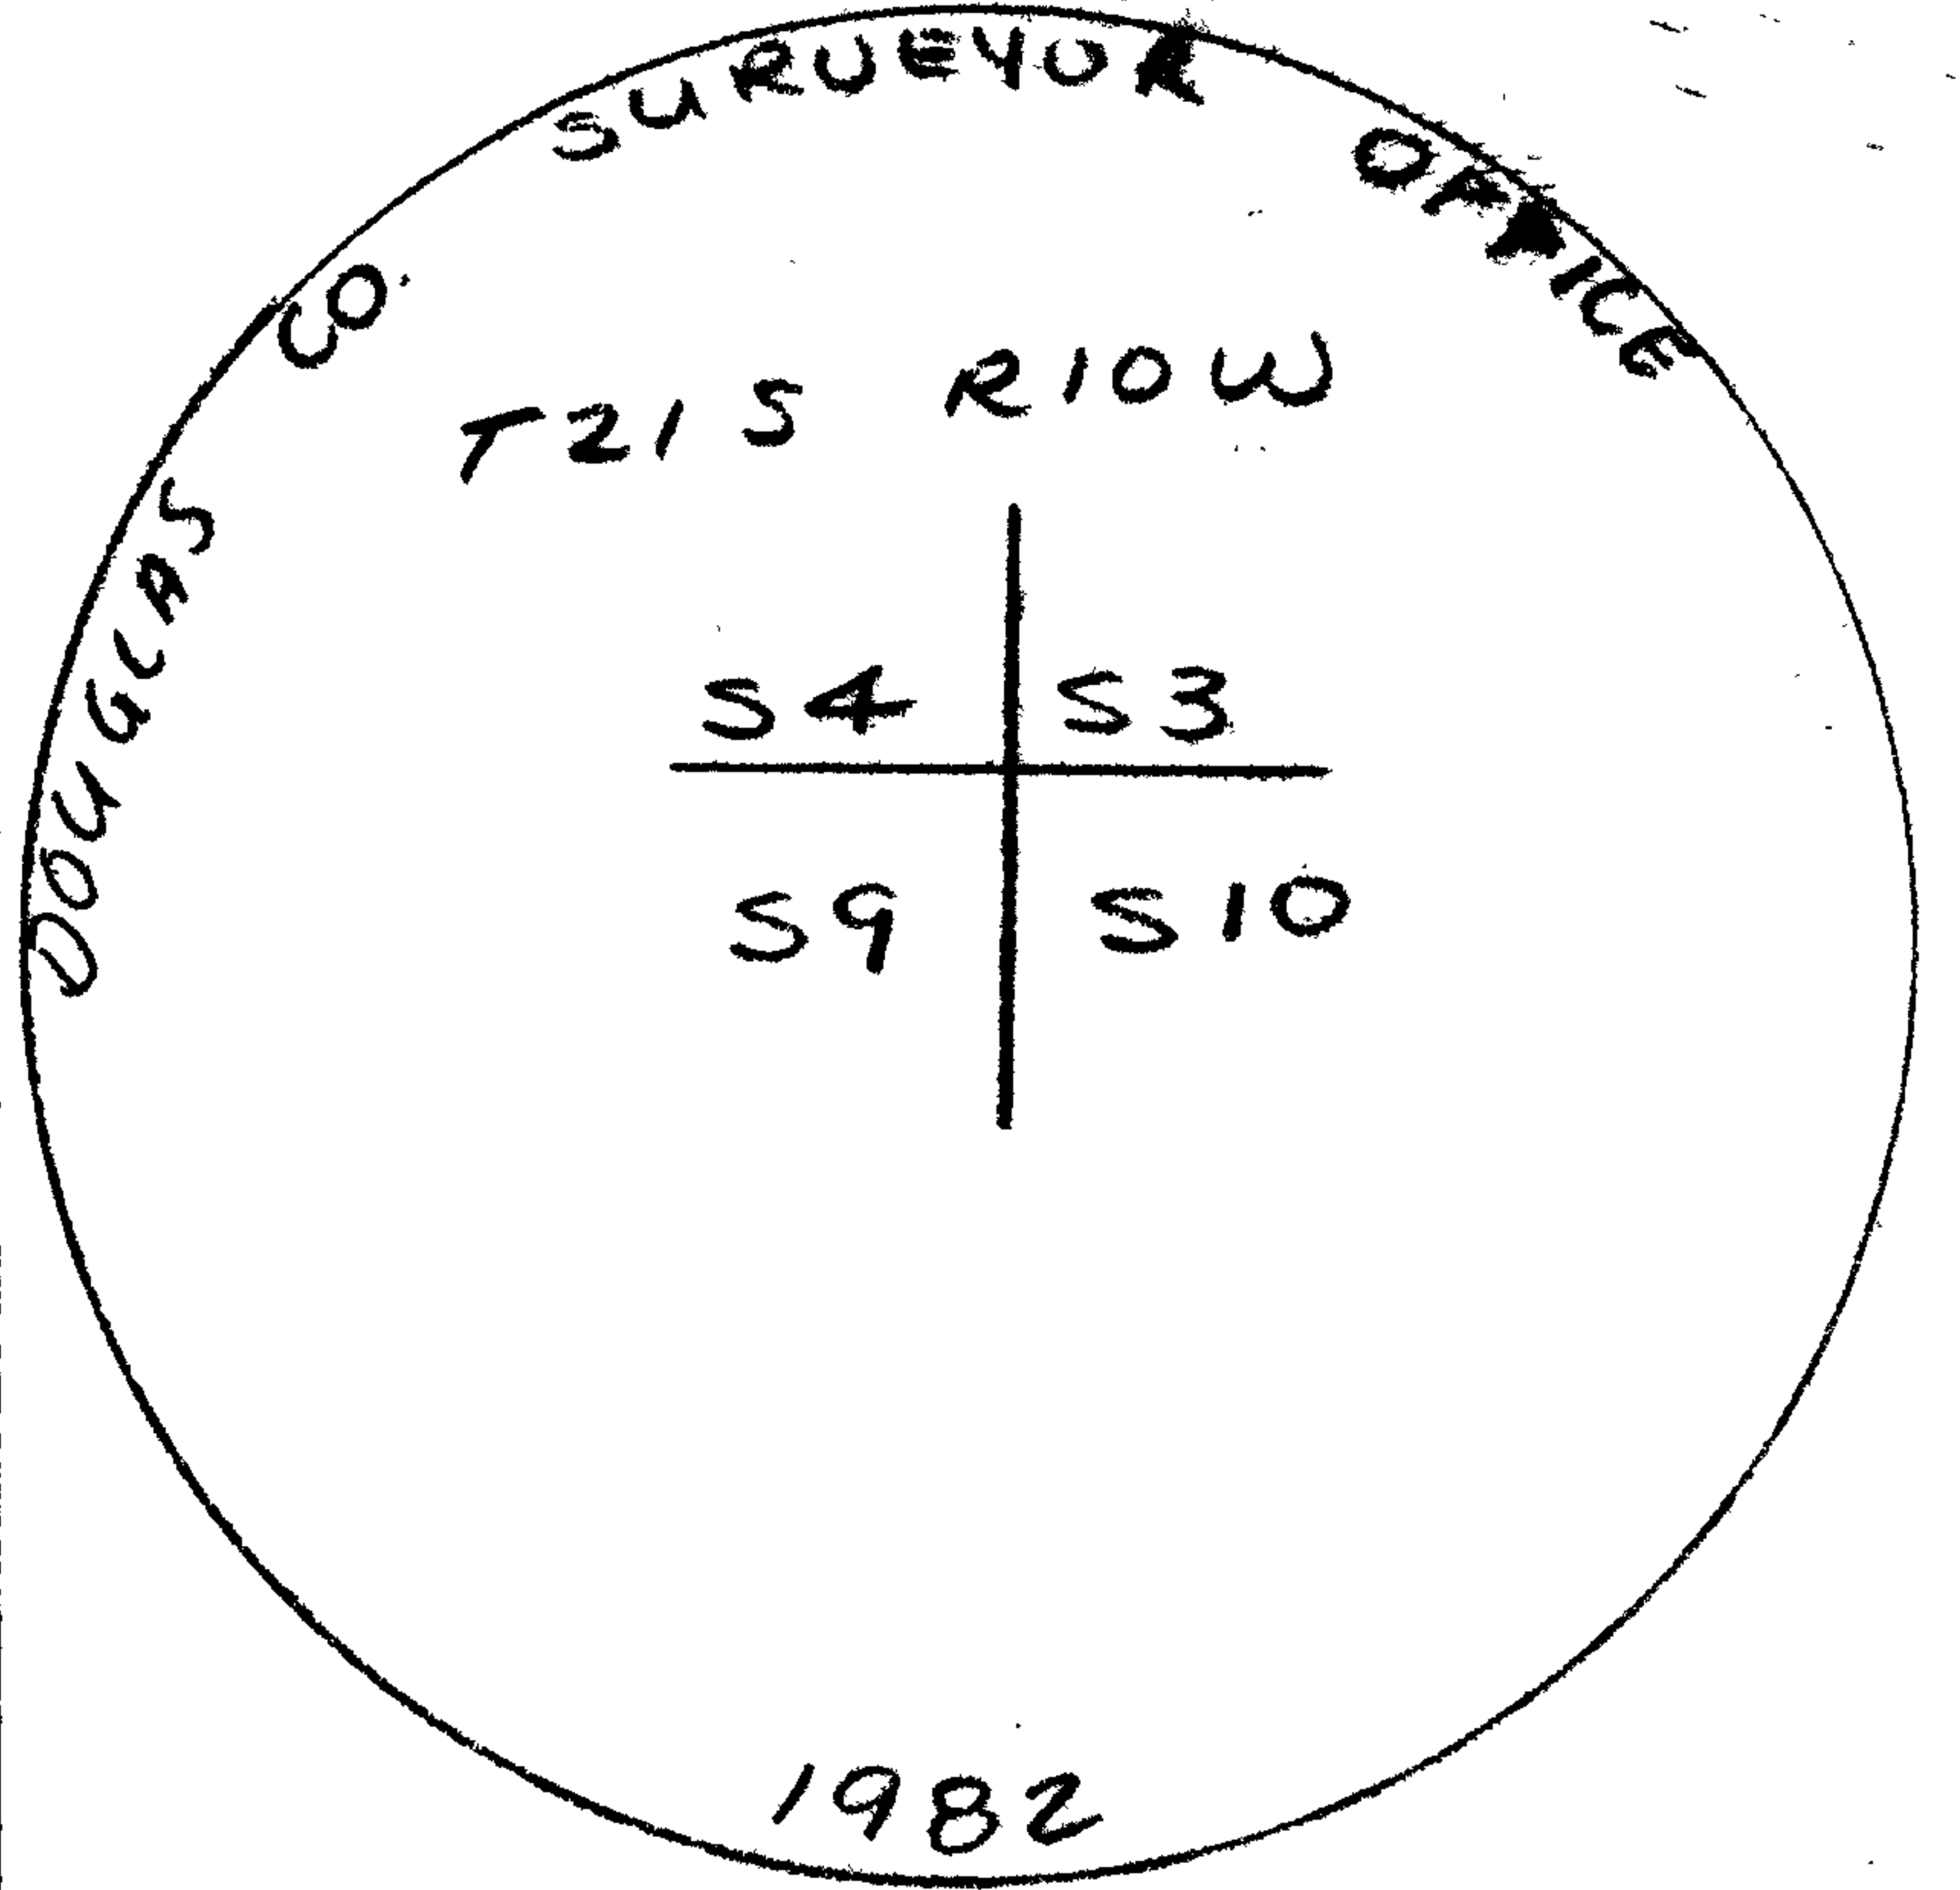

New Accessories

A 17 IN. DIAM. MAPLE THE CENTER<sup>TRUNK</sup> OF A TRIPLE TRUNK TREE  
 SCRIBED " T215 R10W S10 CS BT " IN A DOUBLE BLAZE  
 BEARS S. 27° E, 18.9 FT. DIST. BRG AND DIST TAKEN TO CENTER  
 OF ROOT CROWN

Sketch of Monument, Accessories, and General Area

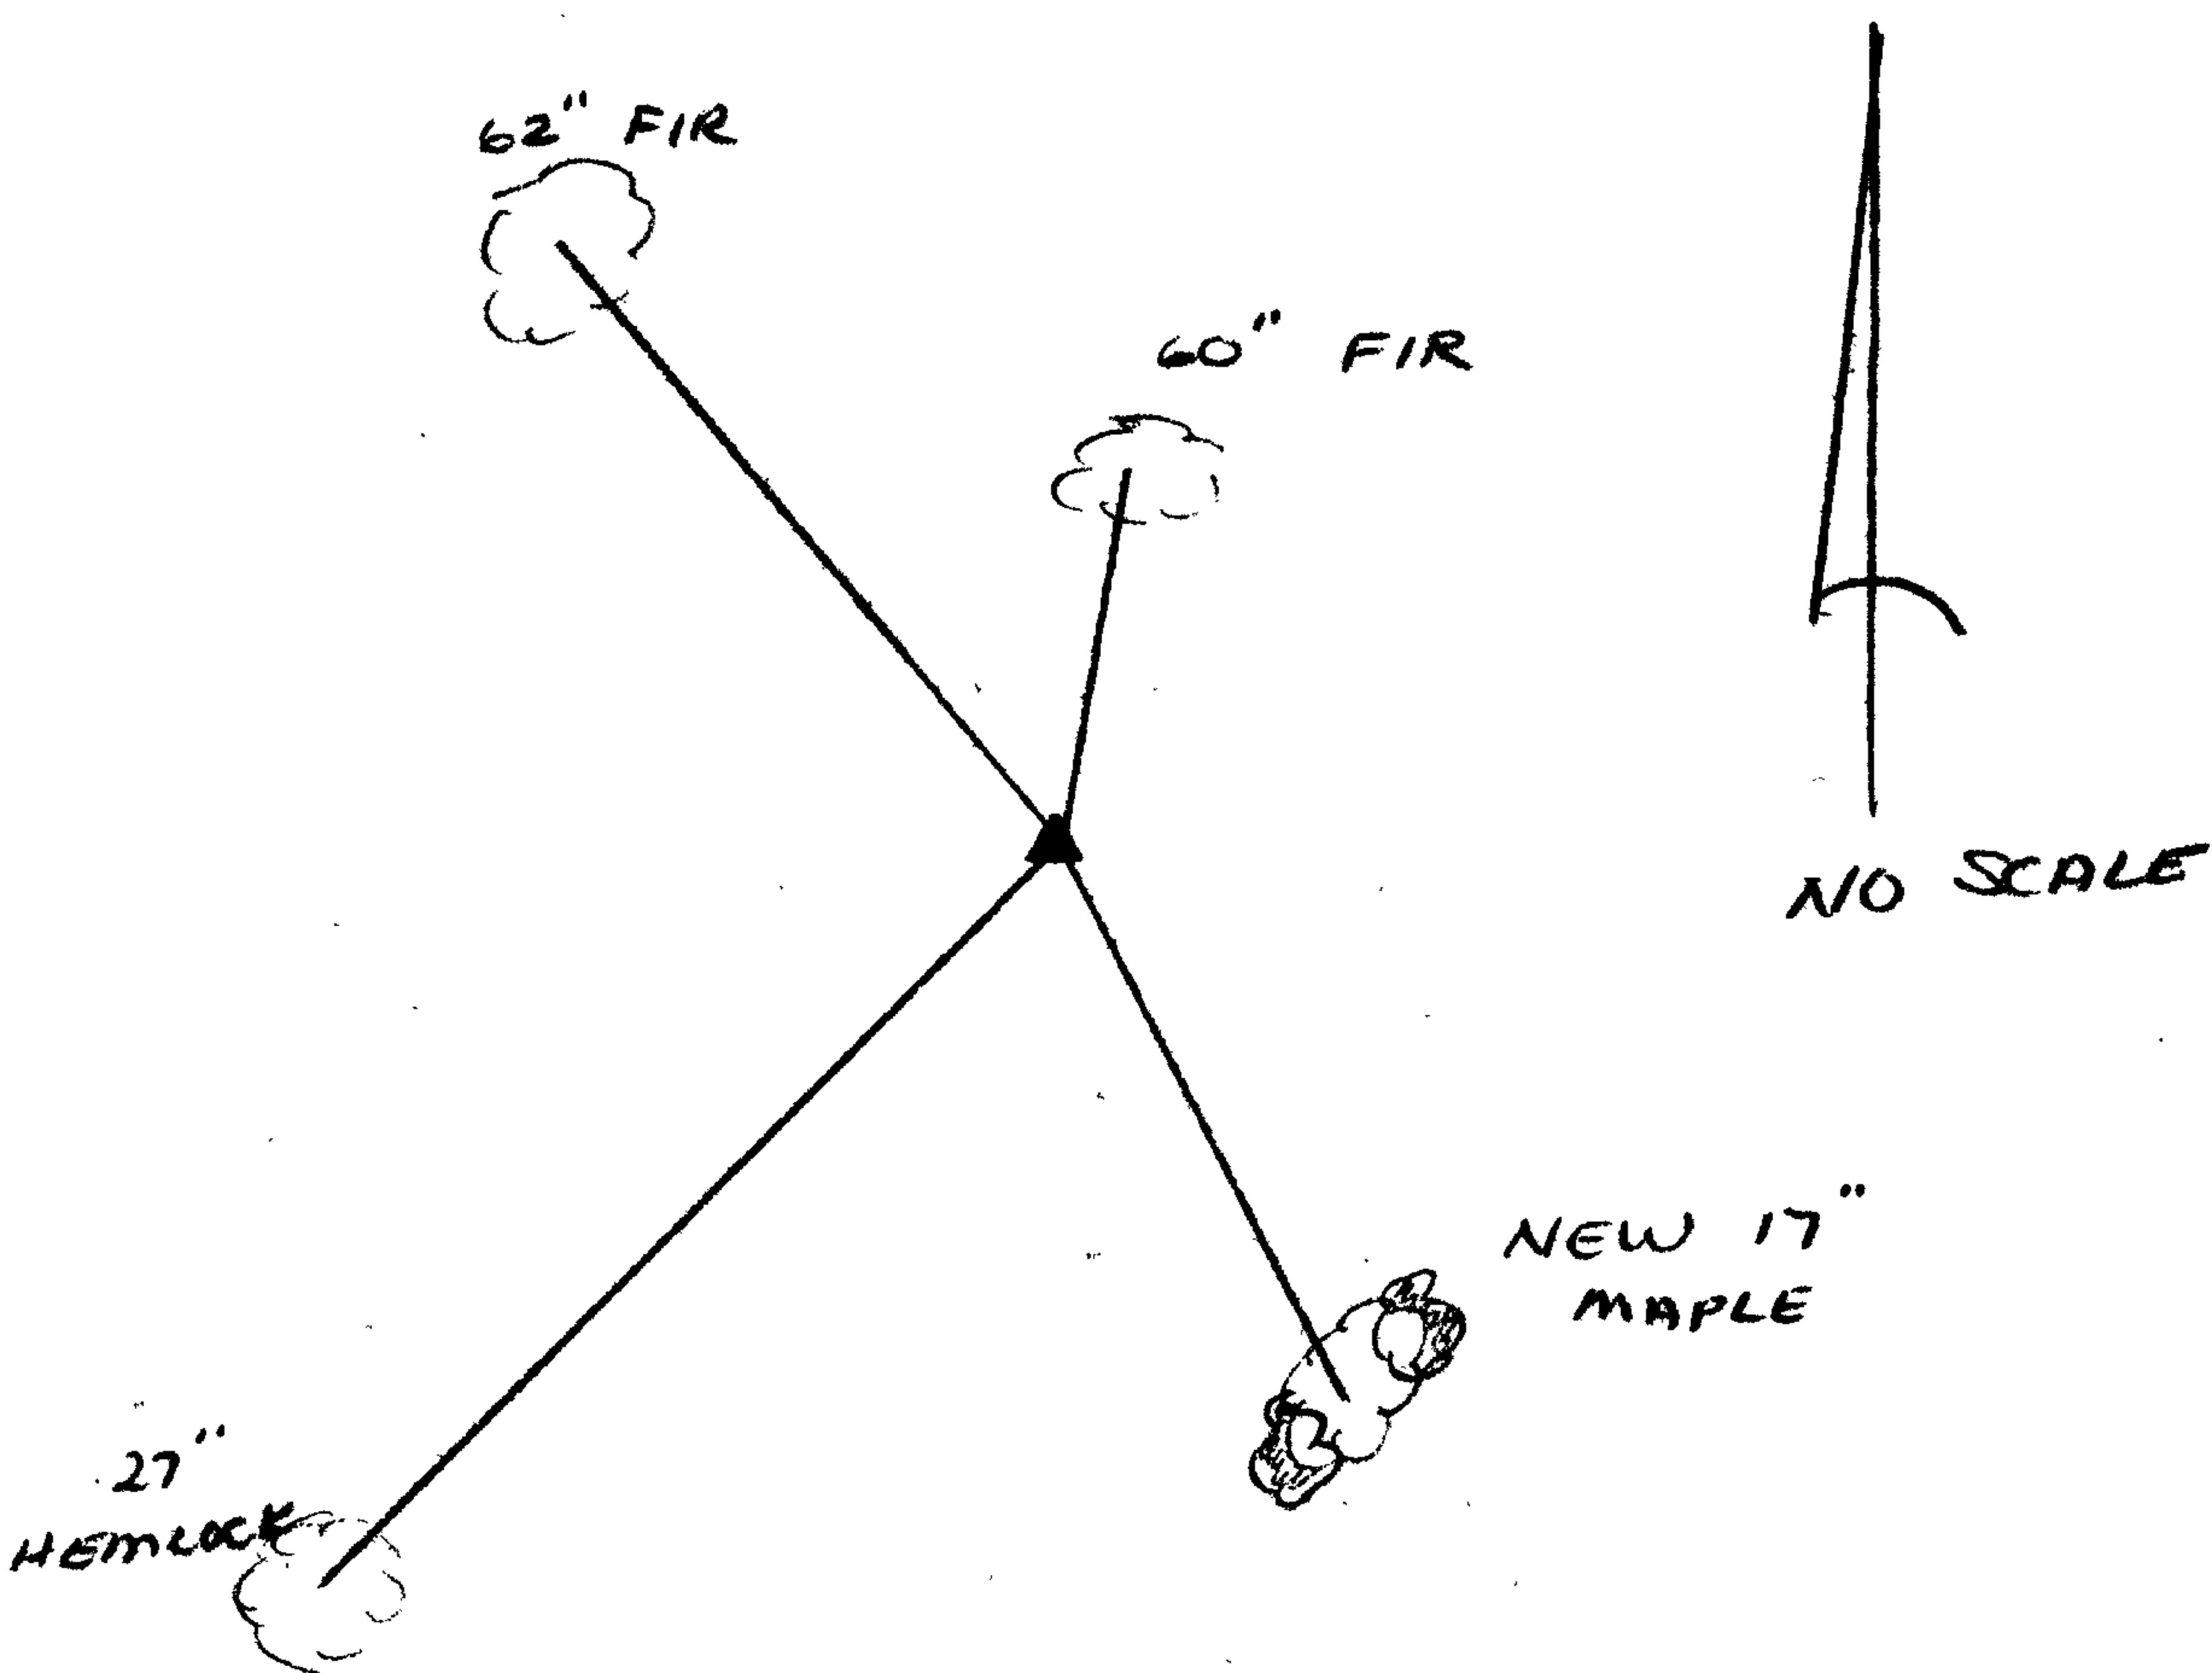

Location & Comments

COR. FALLS ON A  
 MODERATELY STEEP WEST  
 SLOPE

Comp. Declin. 20° EAST  
 Agency DCSO  
 Party Chief KAREN REED  
 Notekeeper KAREN REED  
 Witnesses JOHN POWELL

Surveyor's Seal

REGISTERED  
 PROFESSIONAL  
 LAND SURVEYOR

*Larry E. Monrean*  
 OREGON  
 JULY 13, 1979  
 LARRY E. MONREAN  
 #1830