

GOVERNMENT CORNER RESTORATION FORM

Township 215 Range 10W Sec. 4 County DOUGLAS

State OR Date 8-18-82 No. _____

Corner Designation

T 215
1/4 S 4
S 9
R 10W

- Condition Report Only
- Not Found
- Renewed
- Unrecorded
- Surveyed In
- Referenced Out

Previous Renewals 1919 RESURVEY

MONUMENT DETAIL

Monument(s) Found: (Condition and Source)

FD. 1919 IR. WITH BRASS CAP
RUSTED OFF. IR IS FIRMLY SET
WITH BRASS CAP LYING ALONGSIDE.

(NOTES CALL FOR DATE ON CAP TO
BE 1919 BUT I FIND 1918.)

1/4 S 4
S 9
1918

Accessories Found:

FD. ORIG. 30" FIR NOW 42" WITH GOOD SCAR BEARS
S 20°E 12 1/2 FT. (REC. S 25°E 8 1/2 FT.)

FD. ORIG. 18" FIR NOW 26" ROTTED SNAG 10' TALL NO SCRIING
OR FACE VISIBLE, BEARS N 48W 12 1/2 FT. (REC. N 42°W 13 1/2)

#634

C. E. H. 12/1-12

RENEWAL

Monument Set (Procedure and Description)

Monument Detail


AT THE LOCATION OF THE FOUND IR, I SET A 1" x 30" IR WITH BRASS CAP ATTACHED. I PLACE REMAINS OF OLD PIPE ALONG WEST SIDE OF NEW PIPE AND BURY OLD BRASS CAP ALONG EAST SIDE.

DOUGLAS CO SURVEYOR
 T 21 S
 R 10 W
 1982
 1/4 54 59

New Accessories

15" FIR SCRIBED "1/4 S 9 CS BT" IN DOUBLE BLAZE BEARS S 3° W 11 1/2 FT.
 5" HEMLOCK SCRIBED "1/4 S 4 CS BT" IN DOUBLE BLAZE BEARS N 30° W 25 1/2 FT.

Sketch of Monument, Accessories, and General Area

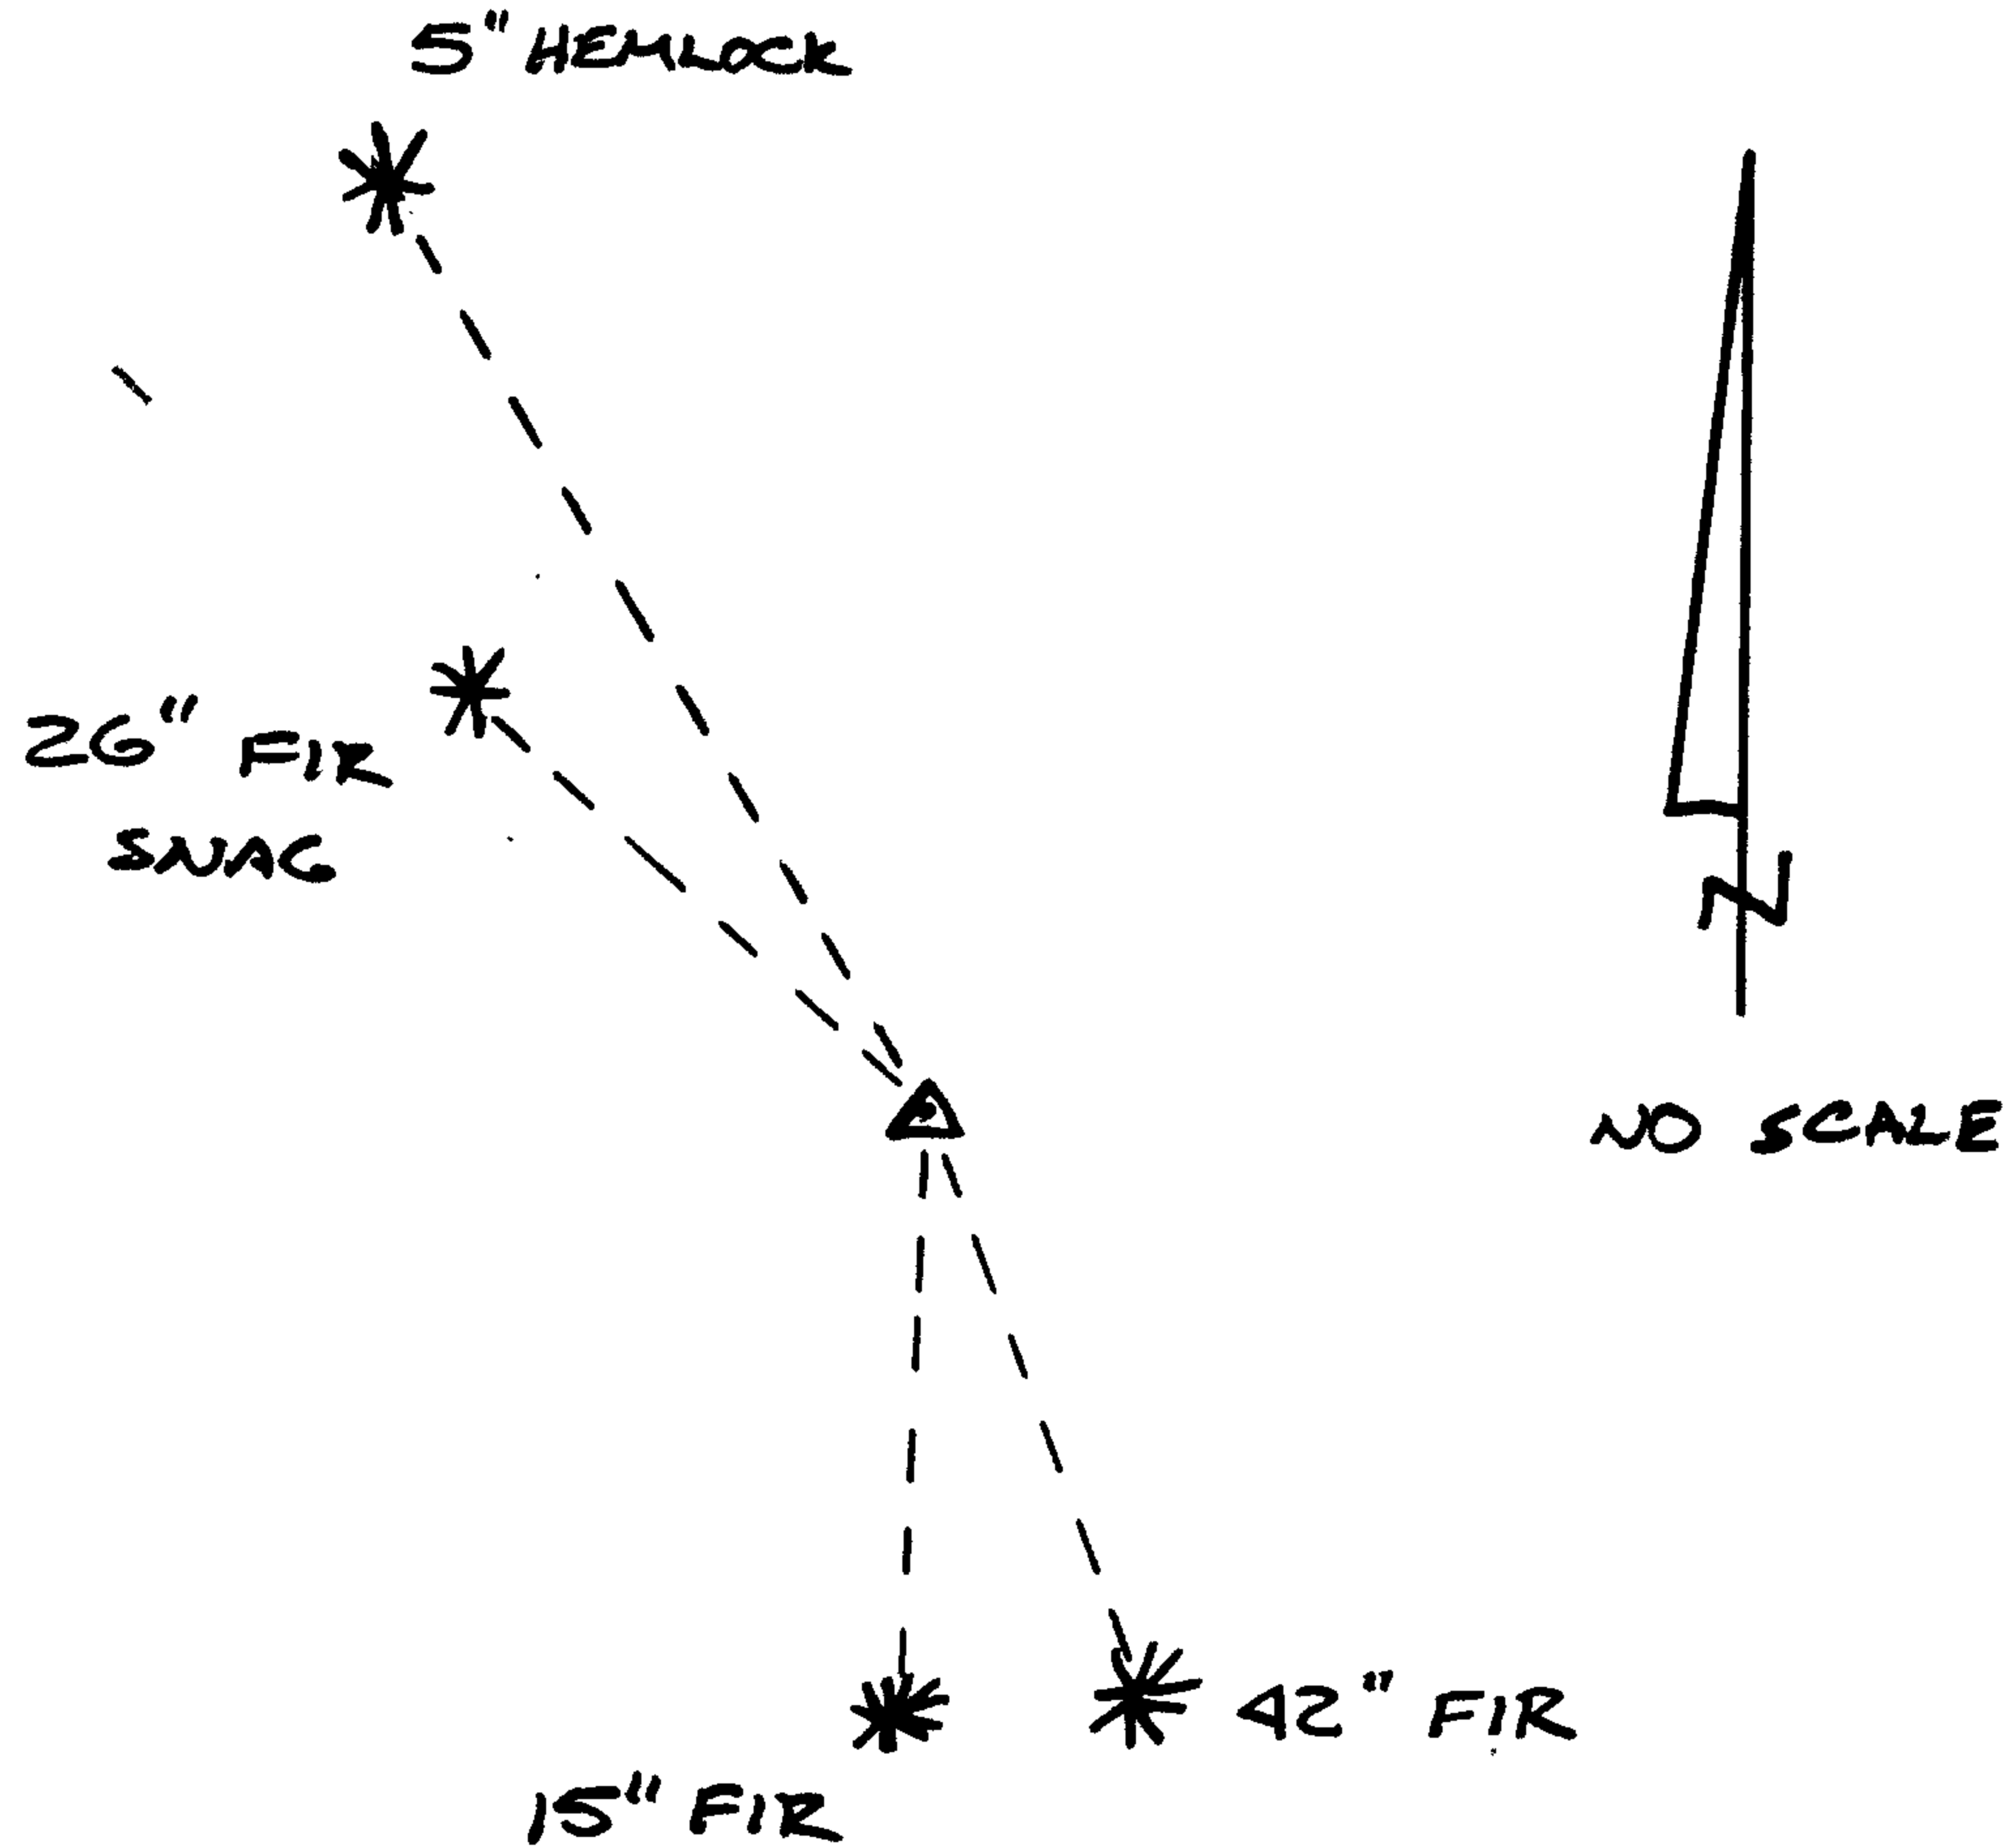

Location & Comments

Comp. Declin. 19° E
 Agency DCSD
 Party Chief GREGORY E. QUIBELL
 Notekeeper Gregory E. Quibell
 Witnesses TERRIE PLOUFFE

Surveyor's Seal
 REGISTERED PROFESSIONAL LAND SURVEYOR
 Gregory E. Quibell
 OREGON
 JULY 13, 1979
 GREGORY E. QUIBELL
 1834

C