

GOVERNMENT CORNER RESTORATION FORM

Township 21S Range 10W Sec. 10 County DOUGLAS

State OREGON Date 8-18-82 No. \_\_\_\_\_

Corner Designation

N 1/4 S10

Previous Renewals M 62-78

Monument(s) Found: (Condition and Source)

A 1 IN. DIAM. CONCRETE FILLED  
IRON PIPE WITH BRASS CAP  
MARKED " GENERAL LAND OFFICE "  
T21S R10W  
1/4 S10  
1919  
TOP 1 FOOT OF PIPE BROKEN OFF  
REMAINING PORTION FIRMLY SET IN  
GROUND.  
CONDITION OF PIPE IS BADLY RUSTED

Accessories Found:


AN ORIB. 12 IN. DIAM. ALDER, NOW 17 IN. BEARS S 28° W,  
9.2 FT. DIST. (REG. S 15° W) WITH WELL HEALED SINGLE  
BLAZE. (THIS TREE IS LEANING IN A NW DIRECTION.)

A 12" HEMLOCK, NOW 15 IN. DIAM., BEARS S. 83° E, 22.8 FT.  
DIST. SCRIBED " S10 1/4 " IN A SINGLE BLAZE, PER  
SURVEY M 62-78. DCSC SURVEY RECORDS

A 10 IN. DIAM. HEMLOCK, NOW 13 IN. BEARS N. 36° E,  
16.3 FT. DIST. SCRIBED " 1/4 S'10 " IN A SINGLE BLAZE,  
PER SURVEY M 62-78. DCSC SURVEY RECORDS

- \_\_\_\_\_ Condition Report Only
- \_\_\_\_\_ Not Found
- Renewed
- \_\_\_\_\_ Unrecorded
- \_\_\_\_\_ Surveyed In
- \_\_\_\_\_ Referenced Out

MONUMENT DETAIL

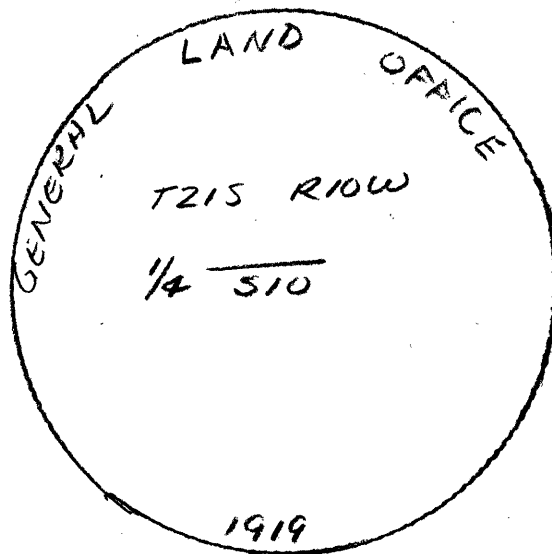

#624


CLM No. 62/1-13 C

RENEWAL

Monument Set (Procedure and Description)

ALTHOUGH THE ORIG. BT WAS  
 OFF BEARING THE IRON PIPE  
 WAS FIRMLY SET AND APPEARED  
 UN DISTURBED.  
 THEREFORE I DRIVE A 1 1/2" X 30"  
 IRON PIPE WITH BRASS CAP STAMPED  
 " DOUGLAS CO. SURVEYORS OFFICE "  
 T 21 S R 10 W  
 1/4 S 10  
 1982  
 IN THE POSITION OF THE PIPE.  
 I DRIVE ORIG. PIPE ALONG THE  
 WEST SIDE OF BRASS CAP AND  
 BURY THE TOP 1 FT OF ORIG PIPE  
 WITH CAP ALONG SOUTHERLY SIDE OF  
 NEW BRASS CAP.


Monument Detail

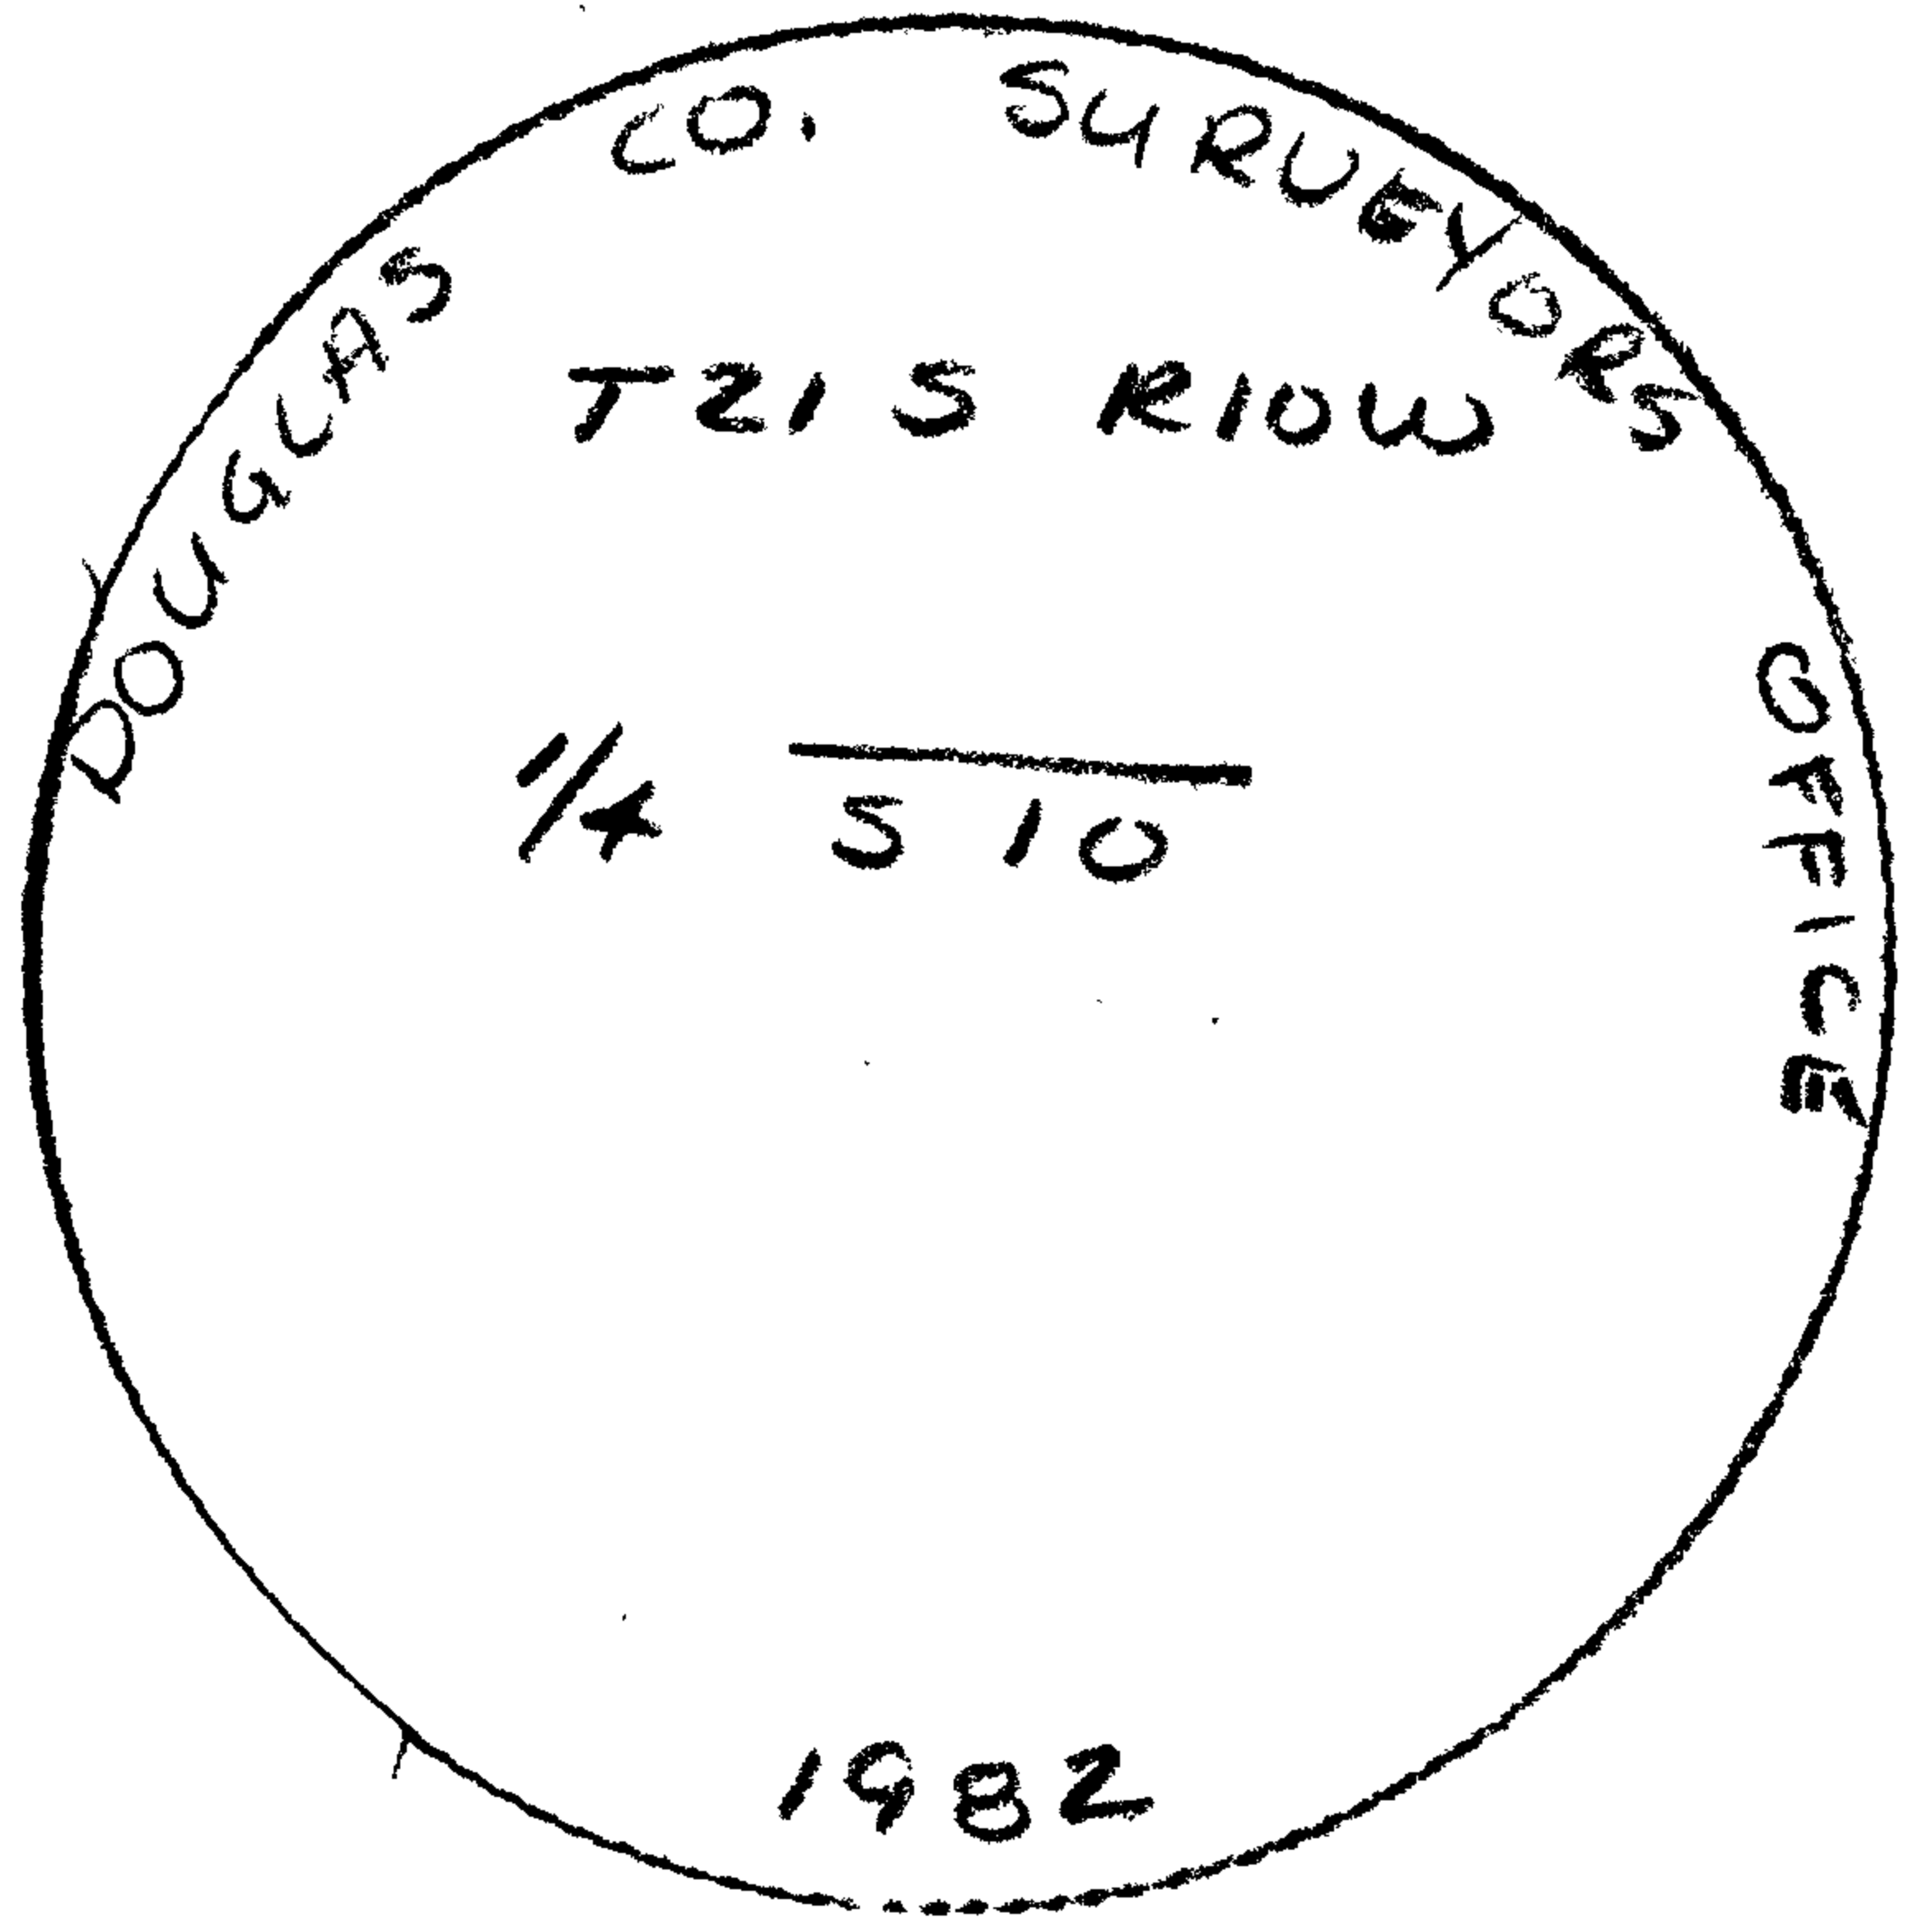

New Accessories

NO NEW BTS

Sketch of Monument, Accessories, and General Area

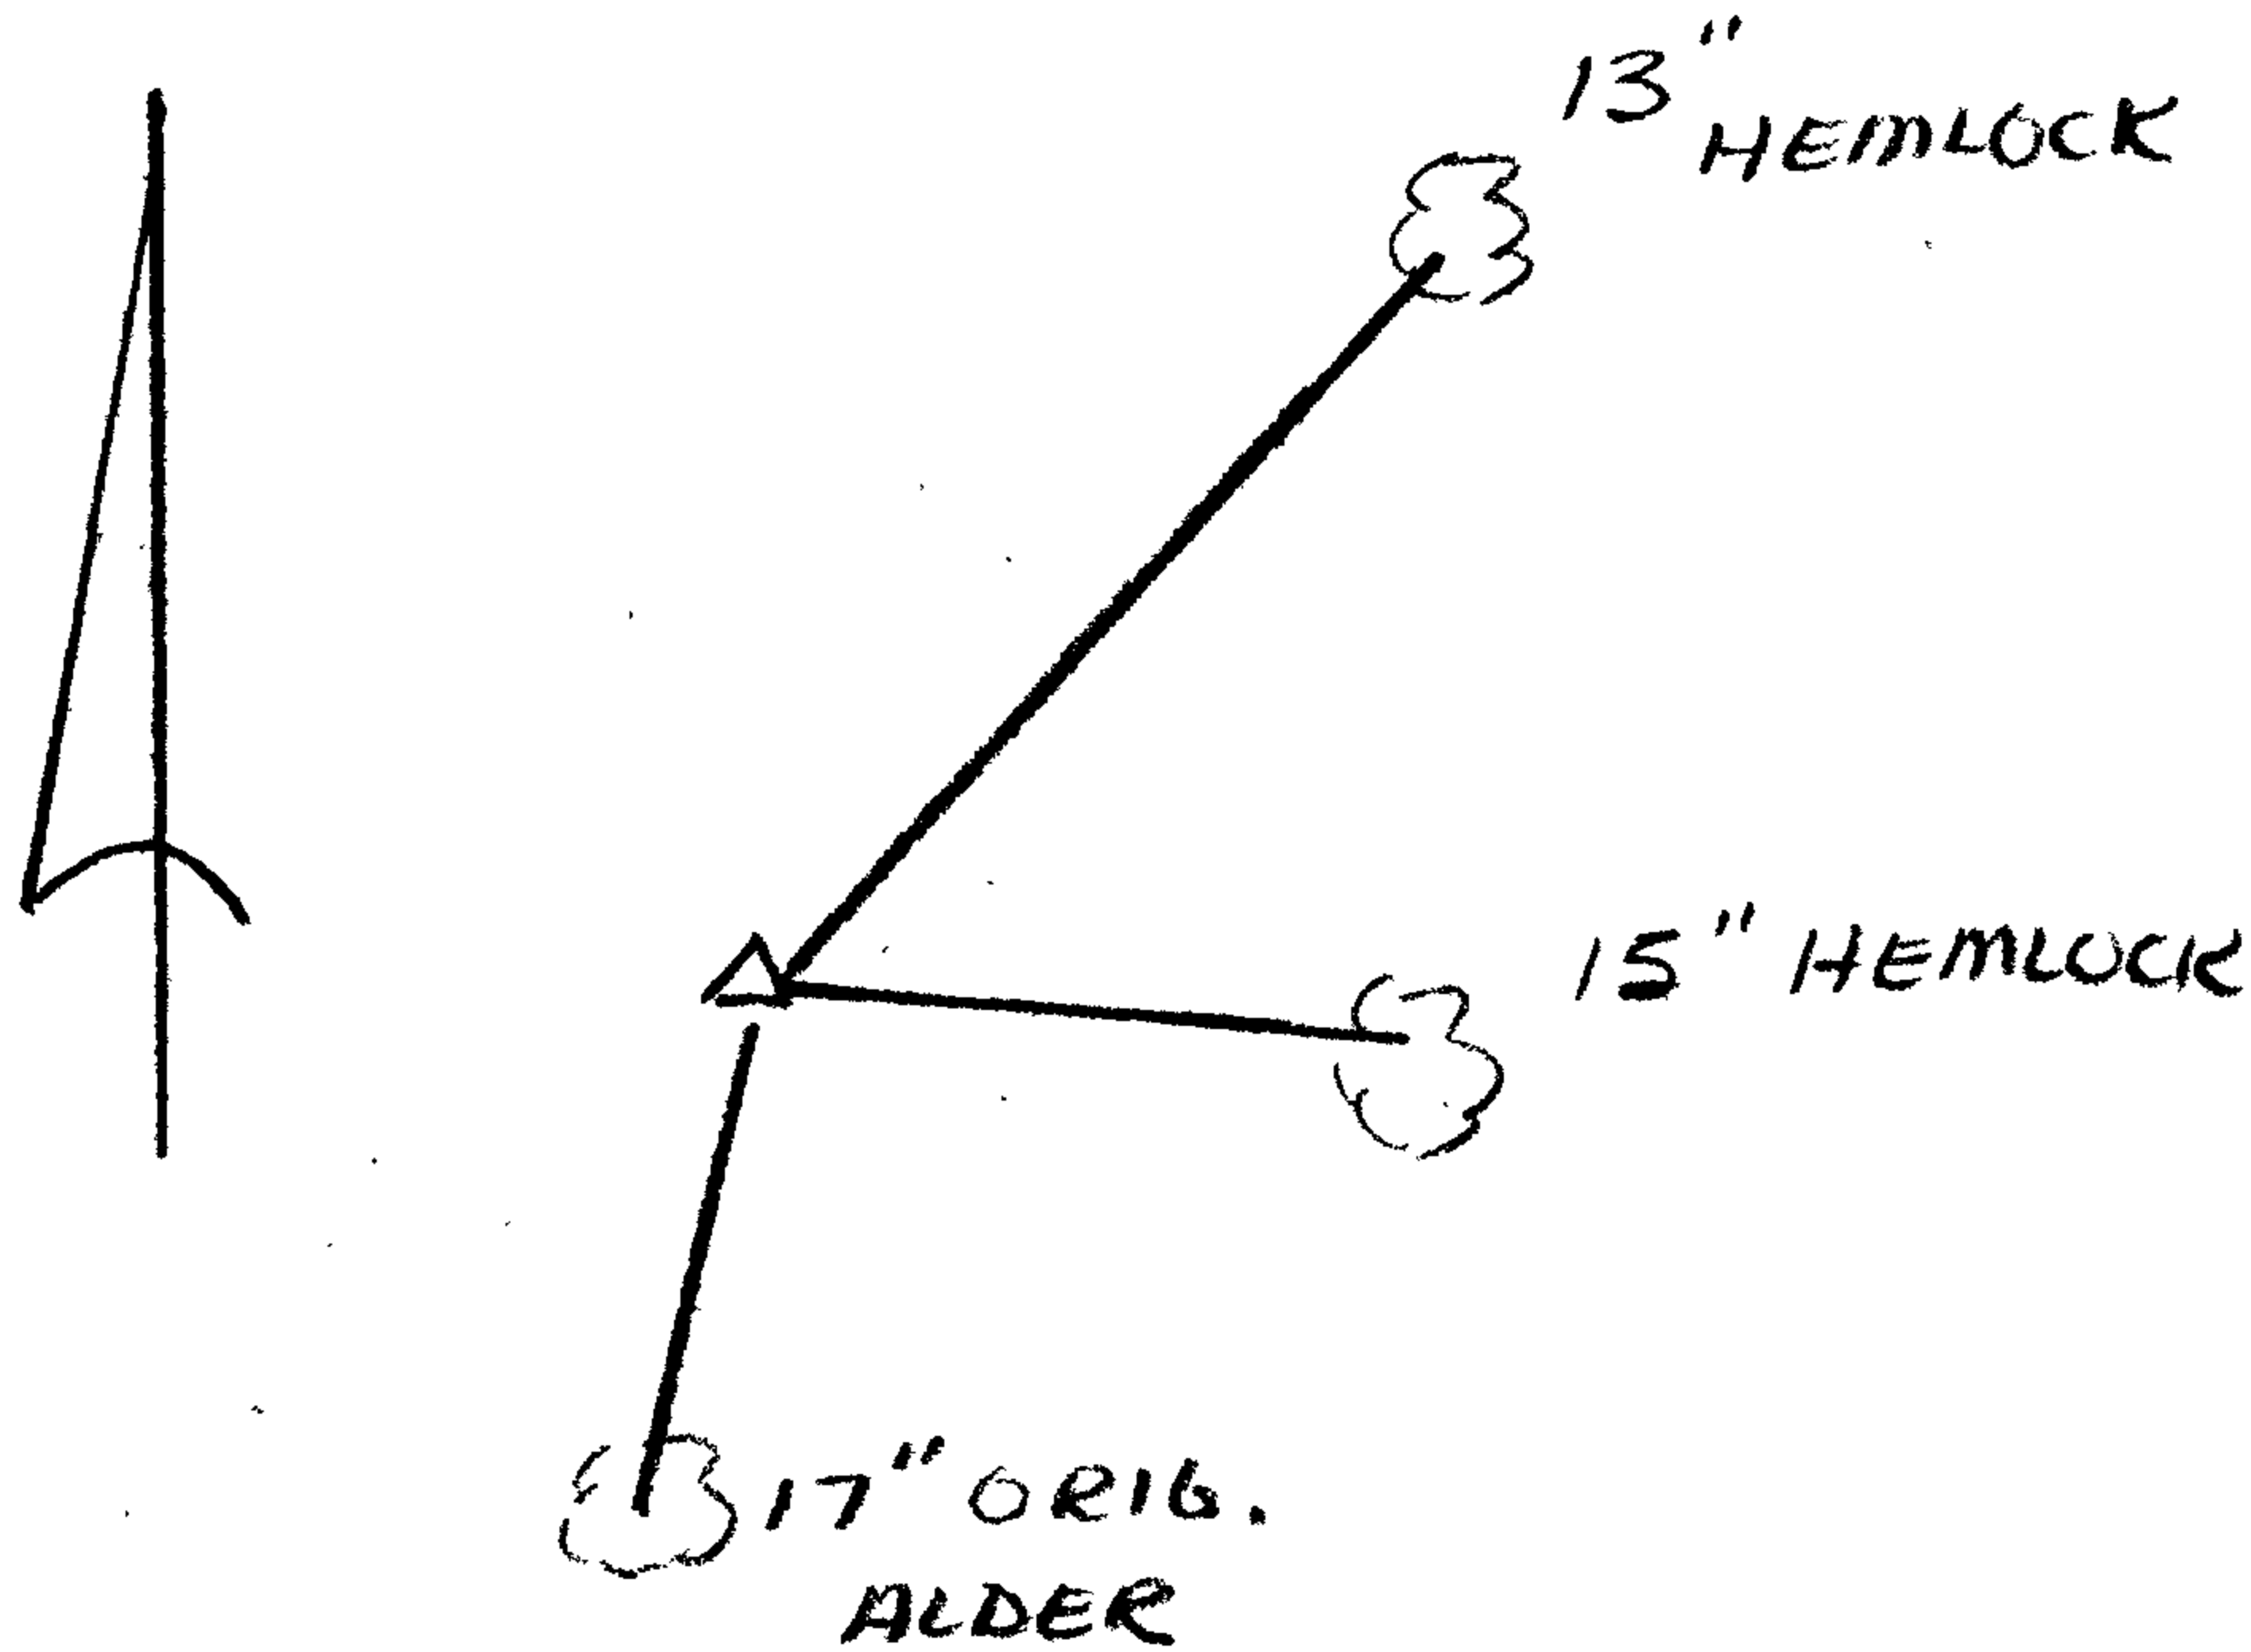

NO SCALE

Location & Comments

CORNER FALLS ON STEEP  
 NORTH SLOPE  
 LAND SOUTH OF CORNER  
 TO BE LOGGED

Comp. Declin. 20° EAST  
 Agency DCSO  
 Party Chief KAREN REED  
 Notekeeper Karen Reed  
 Witnesses JOHN POWELL

Surveyor's Seal

REGISTERED  
 PROFESSIONAL  
 LAND SURVEYOR

*Larry E. Monrean*

OREGON  
 JULY 13, 1979  
 LARRY E. MONREAN  
 #1839