

GOVERNMENT CORNER RESTORATION FORM

Township 26 S Range 1 W Sec. 17 County DOUGLAS

State OR Date 8-30-82 No. _____

Corner Designation T 26 S R 1 W

18 | 17
19 | 20

- Condition Report Only
- Not Found
- Renewed
- Unrecorded
- Surveyed In
- Referenced Out

Previous Renewals _____

Monument(s) Found: (Condition and Source)

ORIG. STONE NOT FOUND.

COR. LIES ON VERY STEEP HILLSIDE WHICH HAS HAD THE SOIL DISRUPTED BY AT LEAST 4 UPROOTED TREES.

Accessories Found:

FD. ORIG 30" FIR NOW 35" WITH GOOD SCAR. I OPEN AND FIND SCRIBED "20".

I FOUND NO TRACE OF OTHER 3 BT'S.

MONUMENT DETAIL

#108 X

G.L.B. No. 62/1-16 C

RENEWAL

Monument Set (Procedure and Description)

Monument Detail

USING RECORD BEARING & DIST. FROM
 FD. ORIG. BT (N82½W 66° FT)
 I SET A 1" x 30" IP WITH BRASS
 CAP ATTACHED 8" INTO THE GROUND
 ALONG WITH AN 18" HIGH MOUND
 OF STONE 2 FT WIDE AT THE BASE.

CO
 T26S
 S18: S17
 S19: S20
 RIW
 1982

SURVEYOR


New Accessories

26" FIR SCRIBED "BT CS T26S RIW S17" (READING FROM BOTTOM
 TO TOP FROM UPHILL SIDE OF TREE) BEARS N5°E 27² FT. ^{IN DOUBLE BLAZE}

8" FIR SCRIBED "T26S RIW S19 CS BT" IN DOUBLE BLAZE BEARS S33W 58¹

10" MAPLE SCRIBED "T26S RIW S19 CS BT" IN DOUBLE BLAZE BEARS S70W 32³

Sketch of Monument, Accessories, and General Area

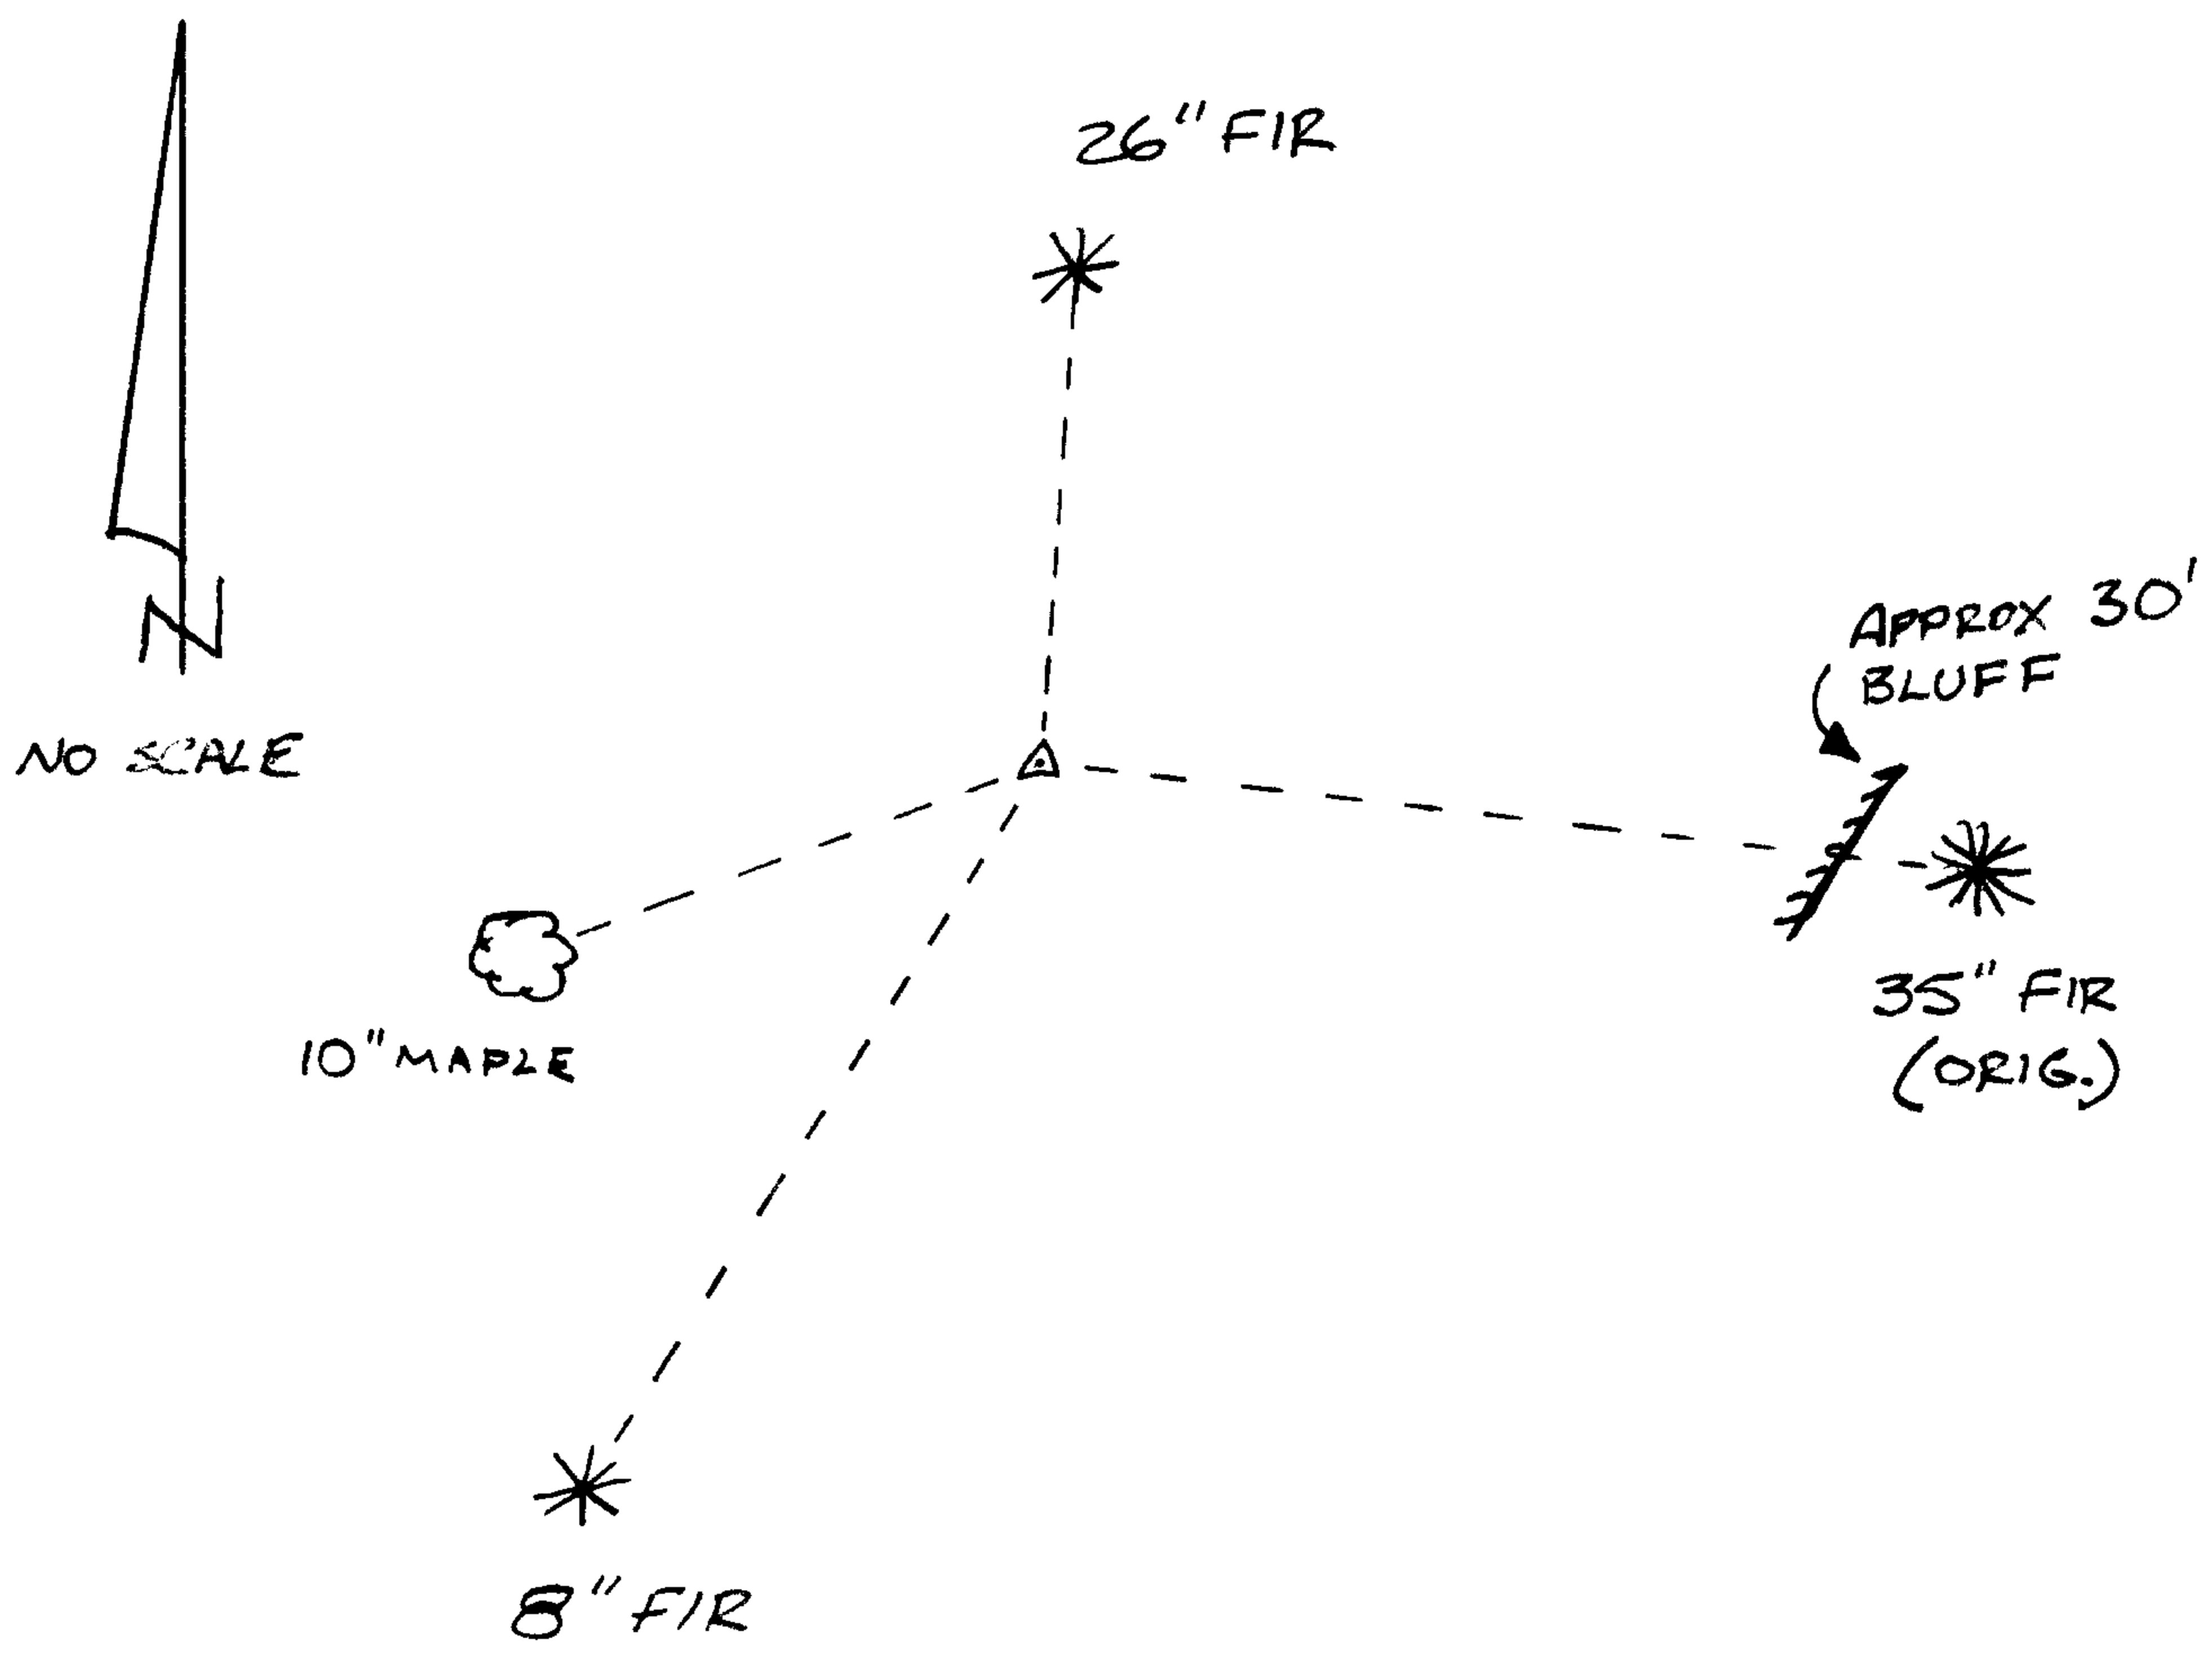

Location & Comments

Comp. Declin. 19° E
 Agency DCSO
 Party Chief GREGORY E. QUIBELL
 Notekeeper Gregory E. Quibell
 Witnesses KAREN REED

Surveyor's Seal

REGISTERED
 PROFESSIONAL
 LAND SURVEYOR

Gregory E. Quibell

OREGON
 JULY 13, 1979
 GREGORY E. QUIBELL
 1834