

GOVERNMENT CORNER RESTORATION FORM

Township 31S Range 9W Sec. 35 County DOUGLAS

State OR Date 9-16-82 No. _____

Corner Designation T31S R9W

1/4 S35 (ONLY)

- Condition Report Only
- Not Found
- Renewed
- Unrecorded
- Surveyed In
- Referenced Out

Previous Renewals 1917 RESURVEY #12 T32-9
#120 T31-9

MONUMENT DETAIL

Monument(s) Found: (Condition and Source)

FD. ORIG. 18x12x6 BASALT STONE WITH 1/4 ON THE NORTH FACE, NOW 18"x11"x6" WITH 1/4 ON A FACE, LYING AT THE APPROX. COR. LOCATION. THE STONE WAS FOUND EARLIER BY A B.L.M. CREW SOMEWHERE IN A SLIDE AREA BELOW THE COR. LOCATION AND MOVED TO THE APPROX. CORRECT LOCATION. 1917 BRASS CAP APPEARS TO HAVE BEEN BURIED BY SLIDE.

Accessories Found:

FD. ORIG. 36" FIR NOW 42" WITH GOOD SCAR.

FD. 11" FIR PER REN. #120 NOW 11" SNAG APPROX. 30' TALL WITH SCRIBED "1/4 S35CS BT" VISIBLE IN UNHEALED BLAZE

#167 T31-9 ✓
#74 T32-9 ✓

GLE No. 62/1-18 C

RENEWAL

Monument Set (Procedure and Description)

AT RECORD BEARING & DISTANCE FROM
 BOTH REMAINING BT'S I SET A
 1" x 30" IP WITH BRASS CAP ATTACHED

ORIG. 36" NOW 42" FIR BEARS S60E 27.1 FT.
 11" FIR NOW 11" SNAG BEARS N80W 78.1 FT

COR. IS SET IN A STEEP BANK
 AND ORIG. STONE WAS PLACED
 ON EAST SIDE OF NEW MONUMENT

Monument Detail


CO SURVEY OF
 T 31 S R 9 W
 S 35
 1982

New Accessories

10" MAPLE SCRIBED "YAS 35CS BT" IN DOUBLE BLAZE BEARS N22E 73.5 FT.

21" FIR SCRIBED "YAS CS BT" IN SINGLE BLAZE BEARS S88W 52.8 FT.

Sketch of Monument, Accessories, and General Area

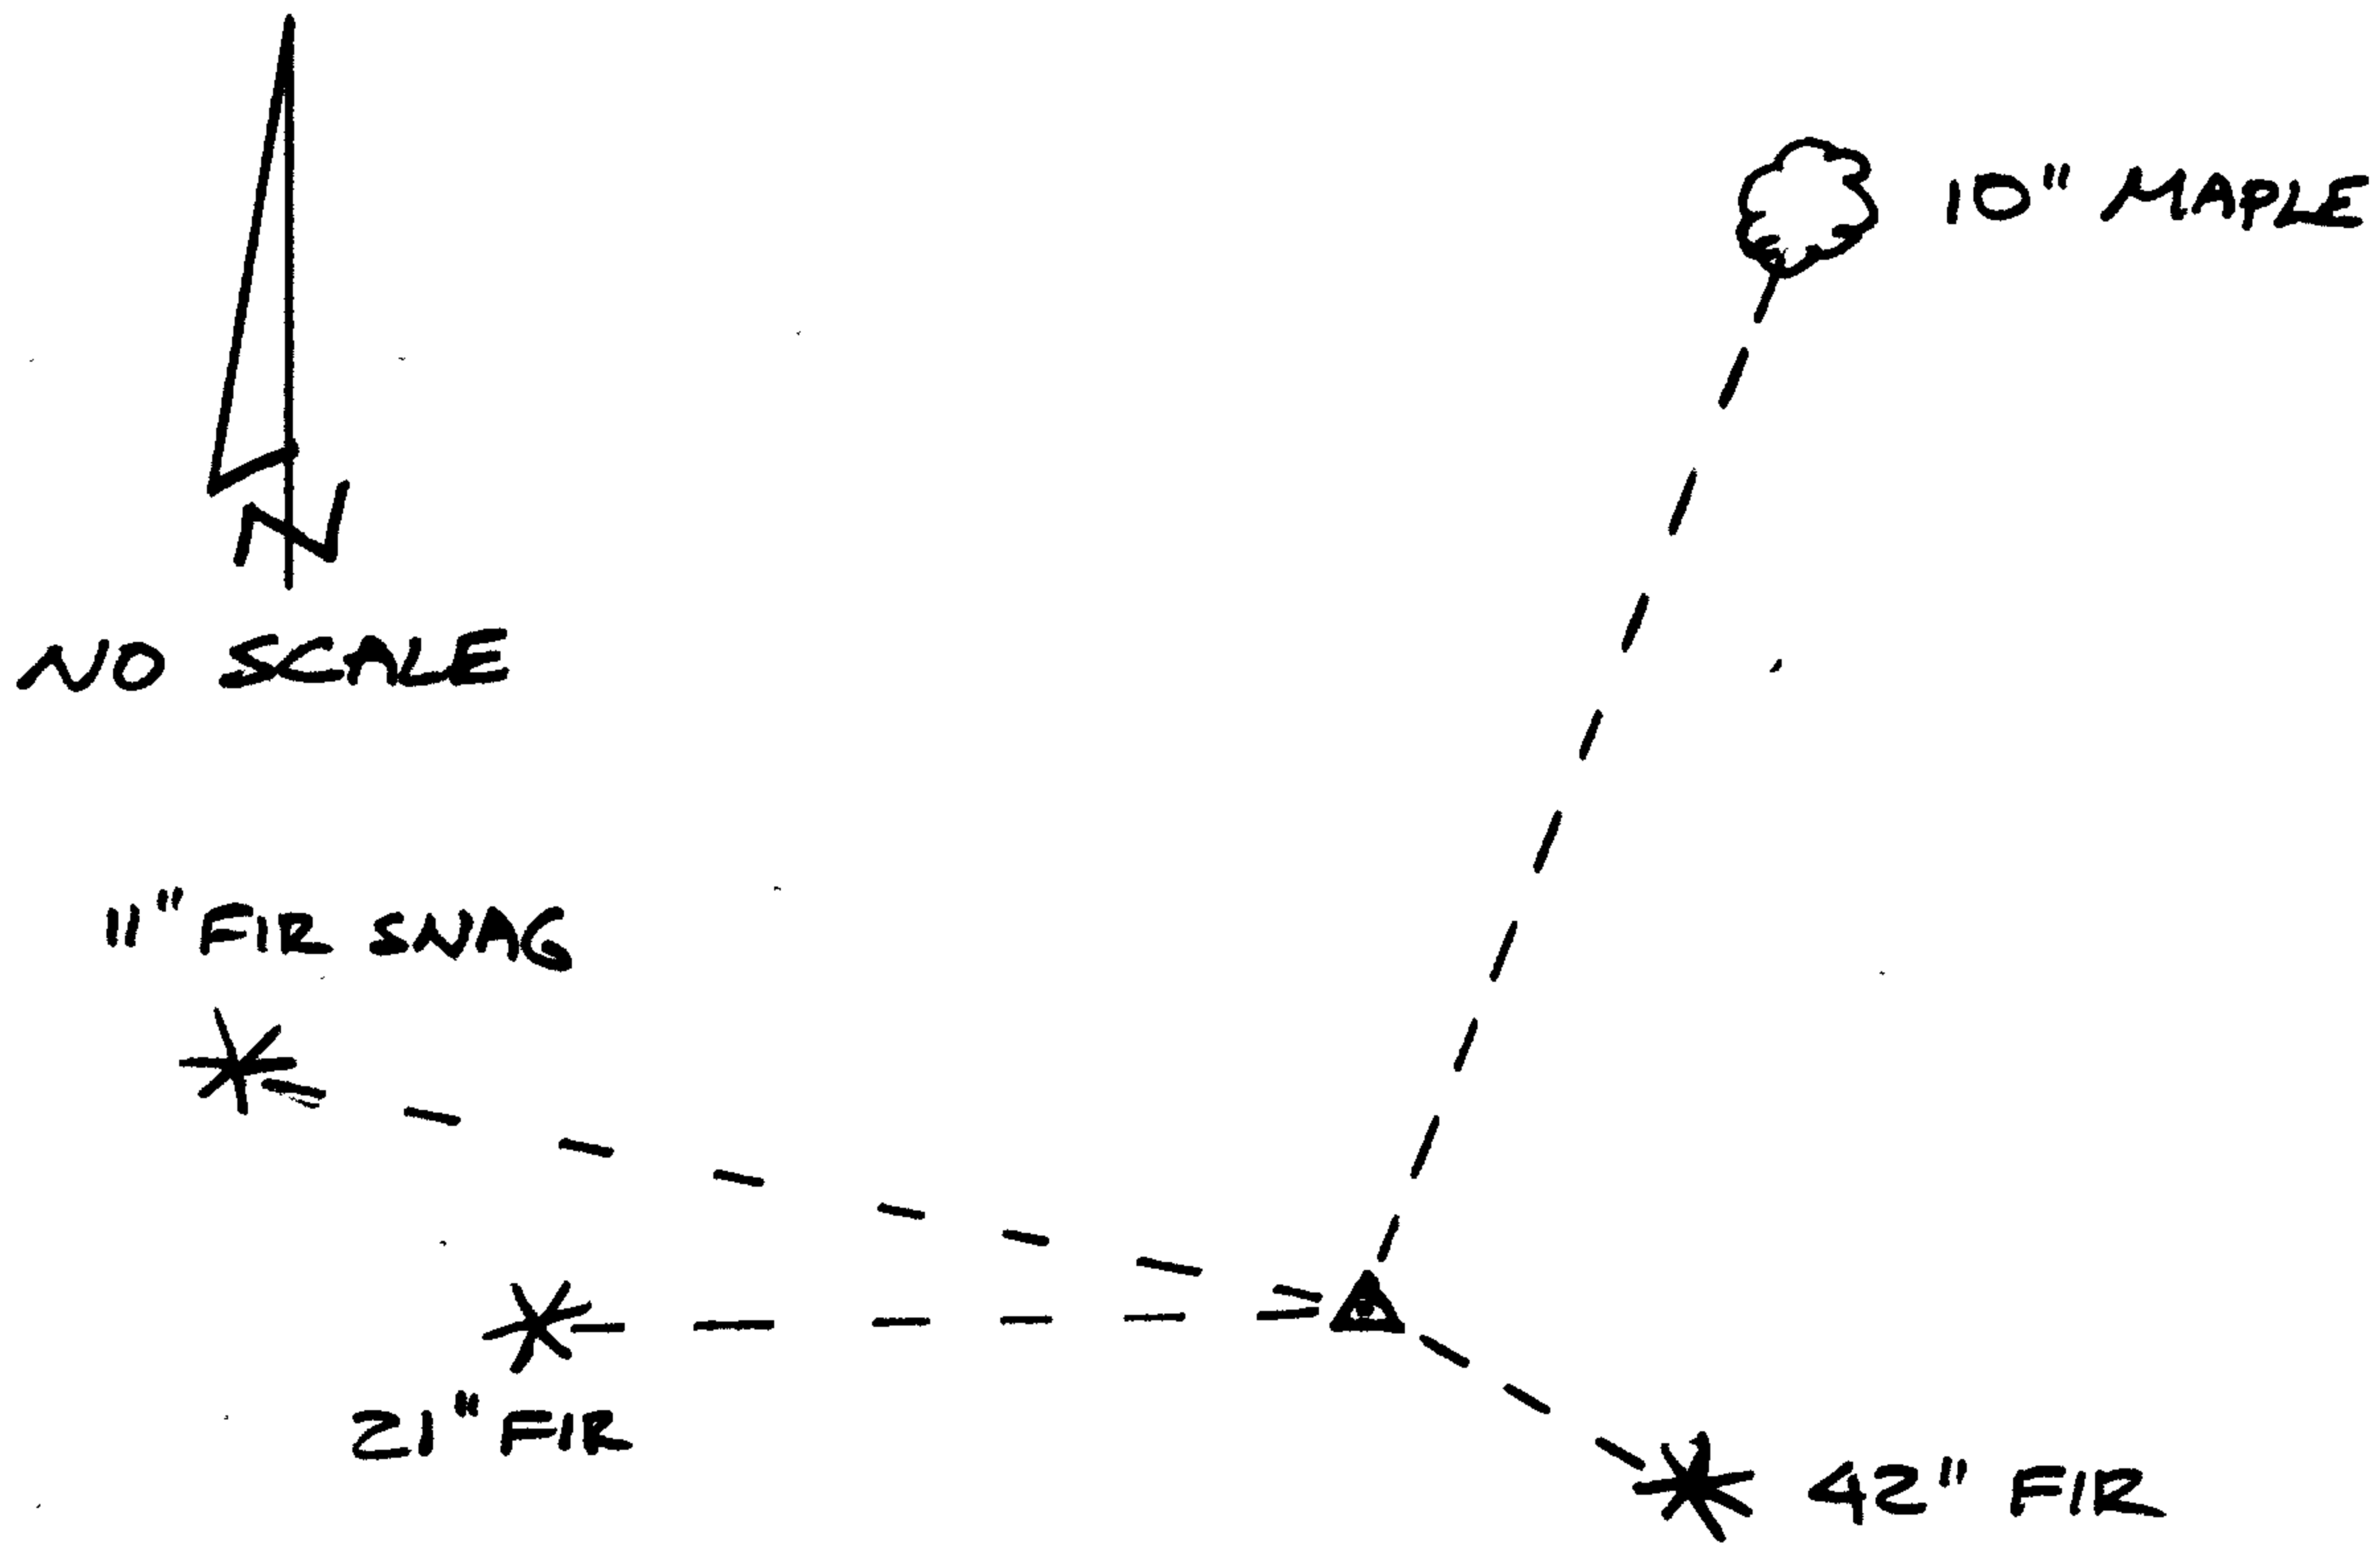

Location & Comments

DCSO BT TAGS ON ALL TREES

Comp. Declin. 19° E
 Agency DCSO
 Party Chief GREGORY E. QUIBELL
 Notekeeper *Gregory E. Quibell*
 Witnesses KAREN REED
 JOHN POWELL

Surveyor's Seal

REGISTERED
 PROFESSIONAL
 LAND SURVEYOR

Gregory E. Quibell

OREGON
 JULY 13, 1979
 GREGORY E. QUIBELL
 1834