

GOVERNMENT CORNER RESTORATION FORM

Township 253 Range 6 W Sec. 16 County DOUGLAS

State OR Date 9-23-82 No. \_\_\_\_\_

Corner Designation


- \_\_\_\_\_ Condition Report Only
- Not Found
- \_\_\_\_\_ Renewed
- \_\_\_\_\_ Unrecorded
- \_\_\_\_\_ Surveyed In
- \_\_\_\_\_ Referenced Out

Previous Renewals M2-6 CS RECORDS : CS 47/123

Monument(s) Found: (Condition and Source)

*ONE PART.  
LARGE AS -  
NOT FOUND  
(1962)*

MONUMENT DETAIL

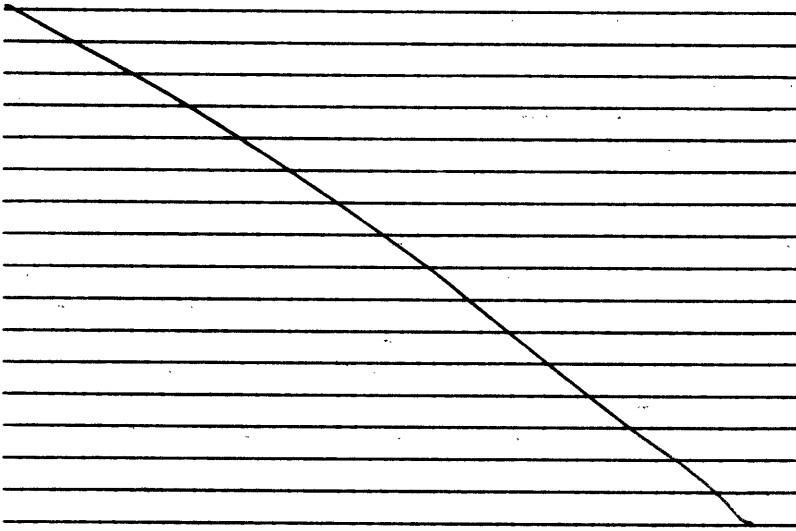

Accessories Found:

FD. PART OF A SHELL OF A 24" OAK STUMP, WITH THE SECTION WHERE A BLAZE WOULD HAVE BEEN COMPLETELY GONE

FD. FENCE COR WITH FENCE RUNNING NORTH & MORE OR LESS EASTERLY (NOT STRAIGHT) I FIND OLD WIRE FENCING IN A PILE OF OLD ROTTEN OAK LIMBS AND CAN NOT DETERMINE IF NEW FENCE WAS BUILT AT EXACT LOCATION OF OLD FENCE

A NEW CAT BUILT FIRE TRAIL ALONG FENCE LINES WOULD HAVE REMOVED ANY OTHER EVIDENCE SHOWN ON M2-6.

RENEWAL


Monument Set (Procedure and Description)

Monument Detail

SINCE NOTHING DEFINATE WAS FOUND I DO NOT SET A MONUMENT.

New Accessories

Sketch of Monument, Aecessories, and General Area

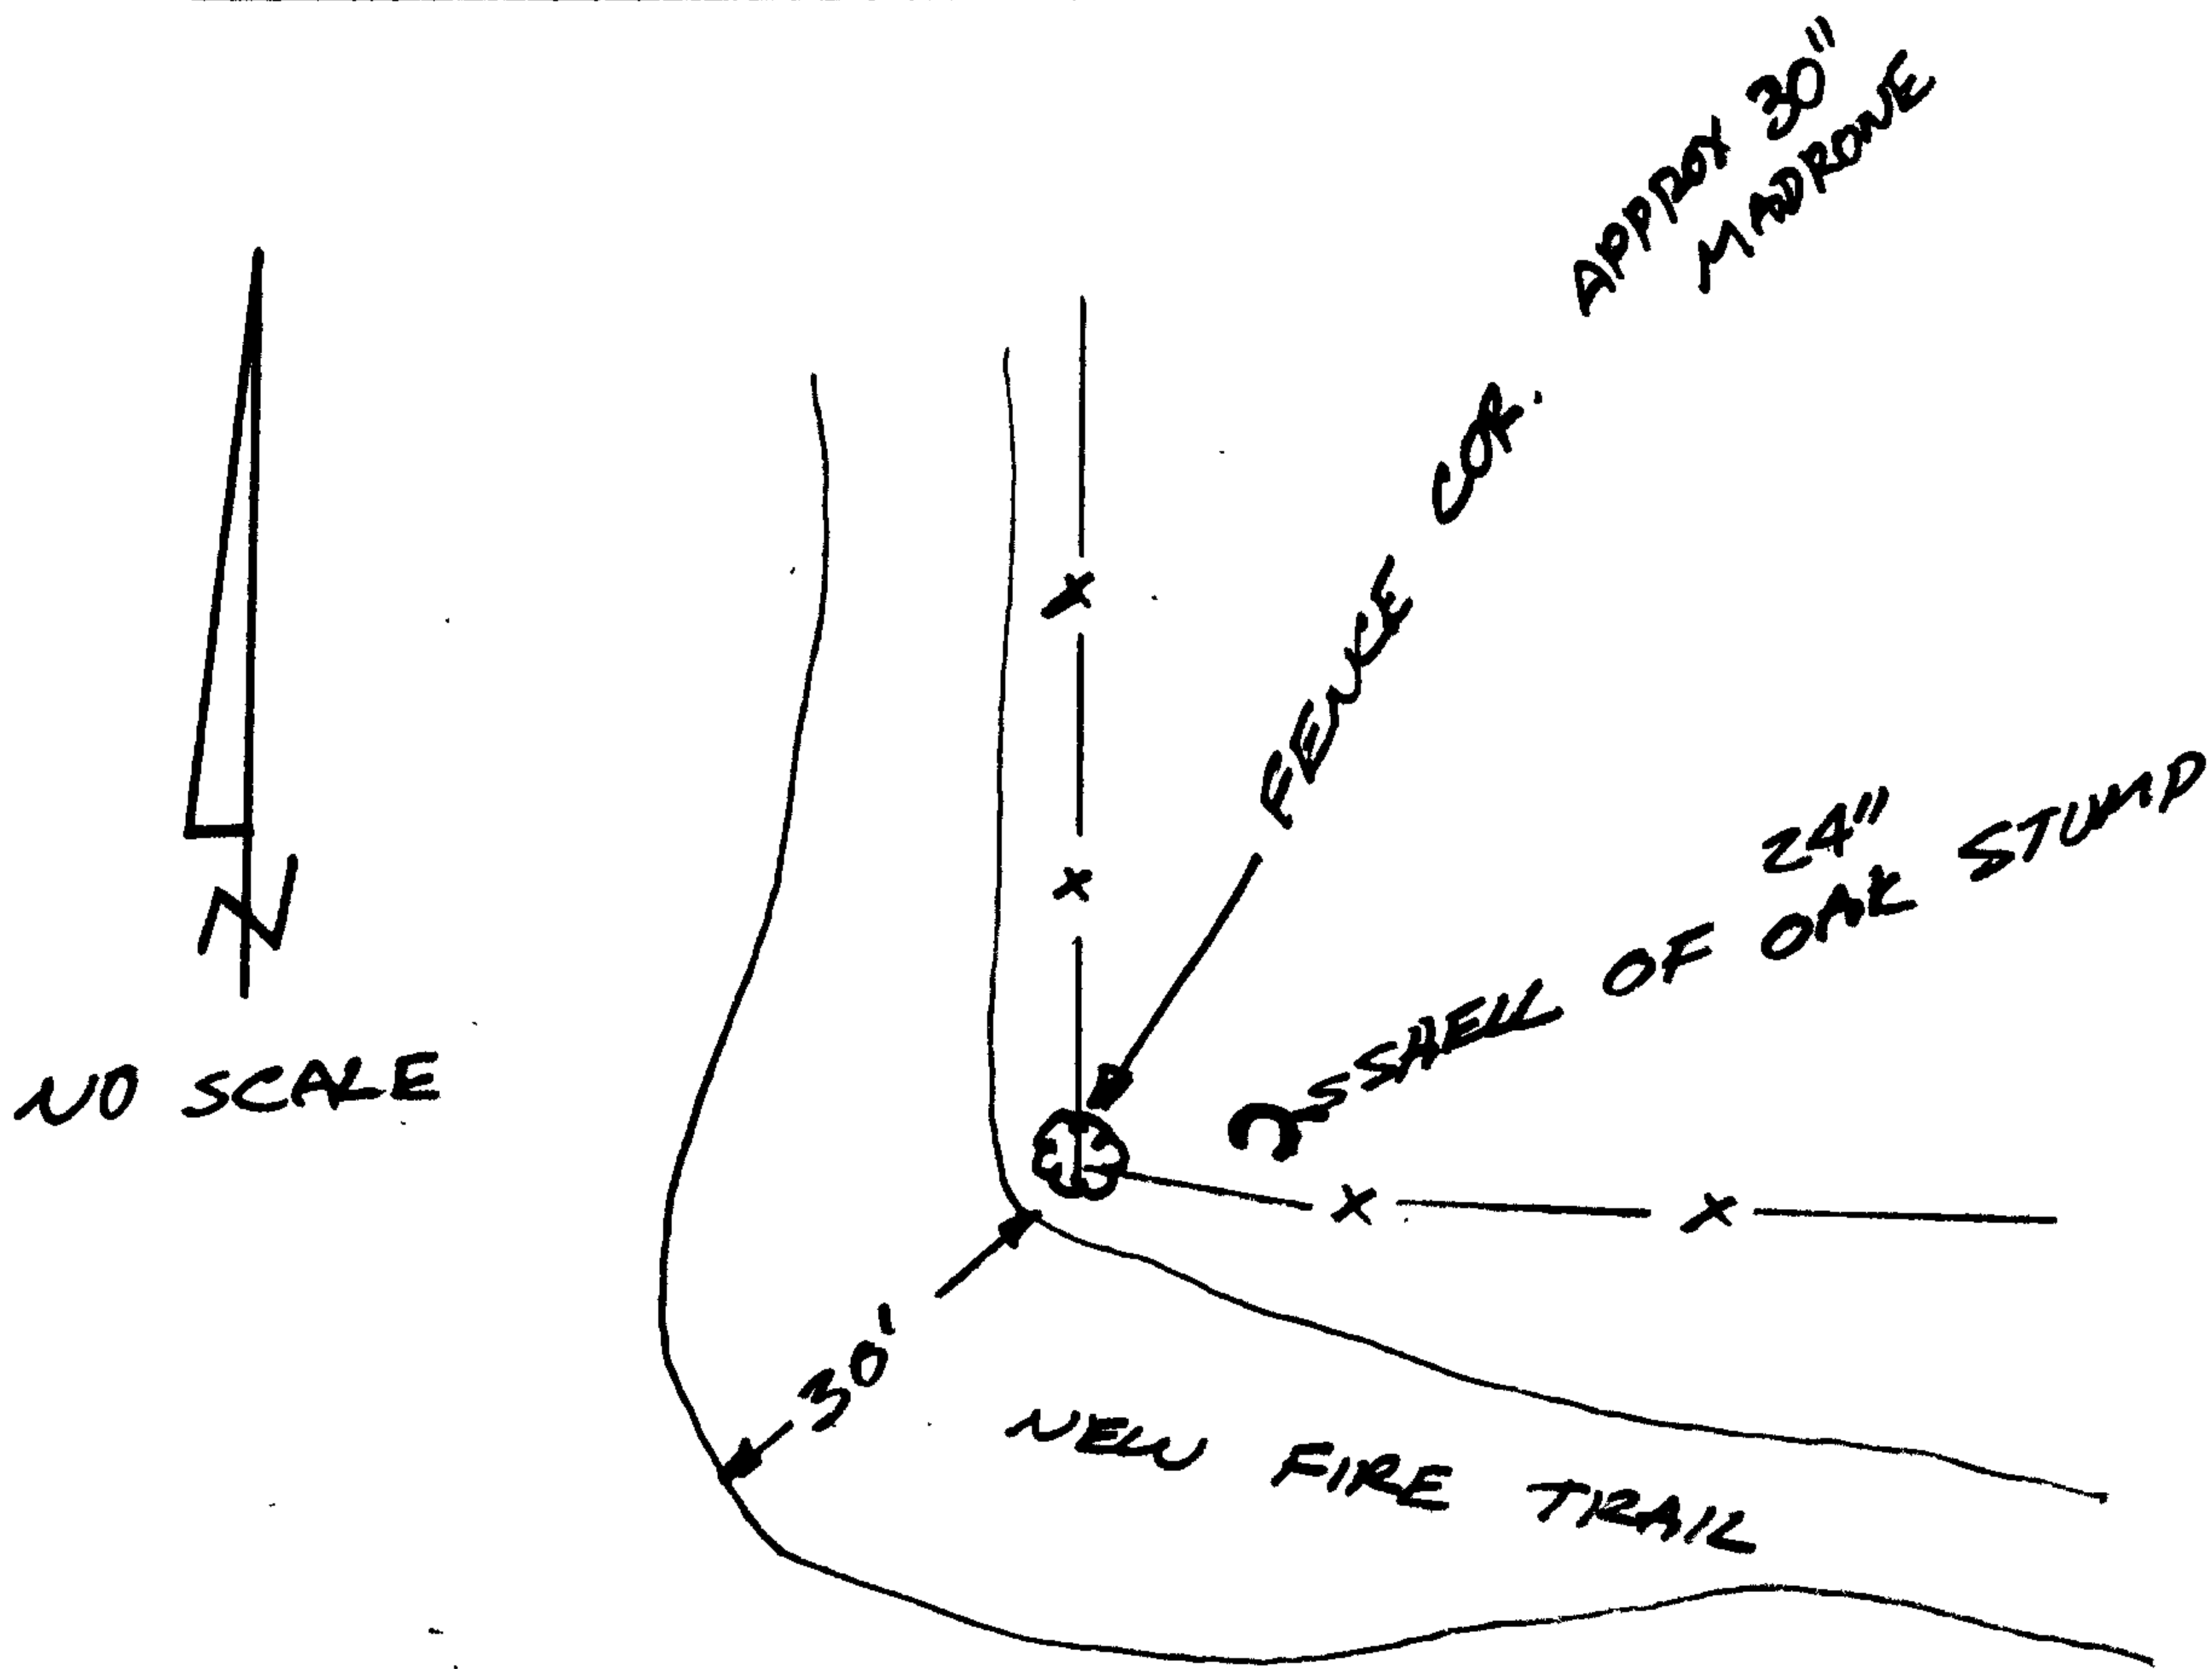

Location & Comments

Comp. Declin. \_\_\_\_\_  
 Agency DCSO  
 Party Chief GREGORY E. DUBELL  
 Notekeeper Gregory E. Dubell  
 Witnesses KAREN REED  
JOHN POWELL

Surveyor's Seal

REGISTERED  
 PROFESSIONAL  
 LAND SURVEYOR

*Gregory E. Dubell*

OREGON  
 JULY 13, 1979  
 GREGORY E. DUBELL  
 1834

OK JRM