

GOVERNMENT CORNER RESTORATION FORM

Township 30S Range 4W Sec. 7 County DOUGLAS

State OR Date 10-14-82 No. _____

Corner Designation

T30S RAW
NW COR.
D.L.C. #39

- Condition Report Only
- Not Found
- Renewed
- Unrecorded
- Surveyed In
- Referenced Out

Previous Renewals #111 & #165

MONUMENT DETAIL

Monument(s) Found: (Condition and Source)

FD. 3/4" IRON ROD (UNKNOWN ORIGIN)
SHOWN ON MAP M90-27.

SEARCH WITH METAL DETECTOR DID NOT
FIND EITHER MONUMENT FROM PRIOR
RENEWALS.

Accessories Found:

FD. 14" FIR PER REV. #165, NOW 18" (ALIVE) BEARS N43°E
76² FT. (REC. N43 1/2 E 77 1/2 FT.)

FD. 11" CEDAR PER REV. #111, WHICH HAS BEEN KNOCKED DOWN
THE HILLSIDE AND BURIED PARTIALLY BY 4'x5' BOULDER.
UNABLE TO DETERMINE POINT OF ORIGIN.

FD. POSSIBLE REMAINS OF ORIG. 26" FIR, NOW 38" STUMP
WHICH WAS BROKEN UP DURING LOGGING, THUS DESTROYING
THE PORTION OF THE STUMP THE FACE WOULD HAVE
BEEN ON. STUMP BEARS S 17°E 63³ (REC.
S 18°E 59³)

#283 X

G.S. File No. 12/1-24

C

RENEWAL

Monument Set (Procedure and Description)

Monument Detail

SINCE THE FD. 3/4" IR OF UNKNOWN ORIGIN DOES NOT FIT THE BT PER REN. #165 I SET A 1"x30" IR WITH BRASS CAP ATTACHED AT RECORD BEARING & DIST FROM SAID BT. AS FOLLOWS: S 48 1/2 W 77 1/2 FT.

FD. 3/4" IR WHICH I DO NOT REMOVE BEARS N 63 E 17 FT FROM NEW COR.

POSSIBLE ORIG. 26" FIR NOW 38" STUMP BEARS S 18 1/2 E 62 1/2 (REK SIDE 59 1/2).


DOUGLAS
W
A
R
CO.
T 30 S
S
C
R
I
P
E
T
O
R
NW. COR.
D.L.C.
39
1982

New Accessories

10" FIR SCRIBED "NW DLC 39 CS BT" IN DOUBLE BLAZE BEARS S 22° E 50 1/2 FT.

Sketch of Monument, Accessories, and General Area

Location & Comments

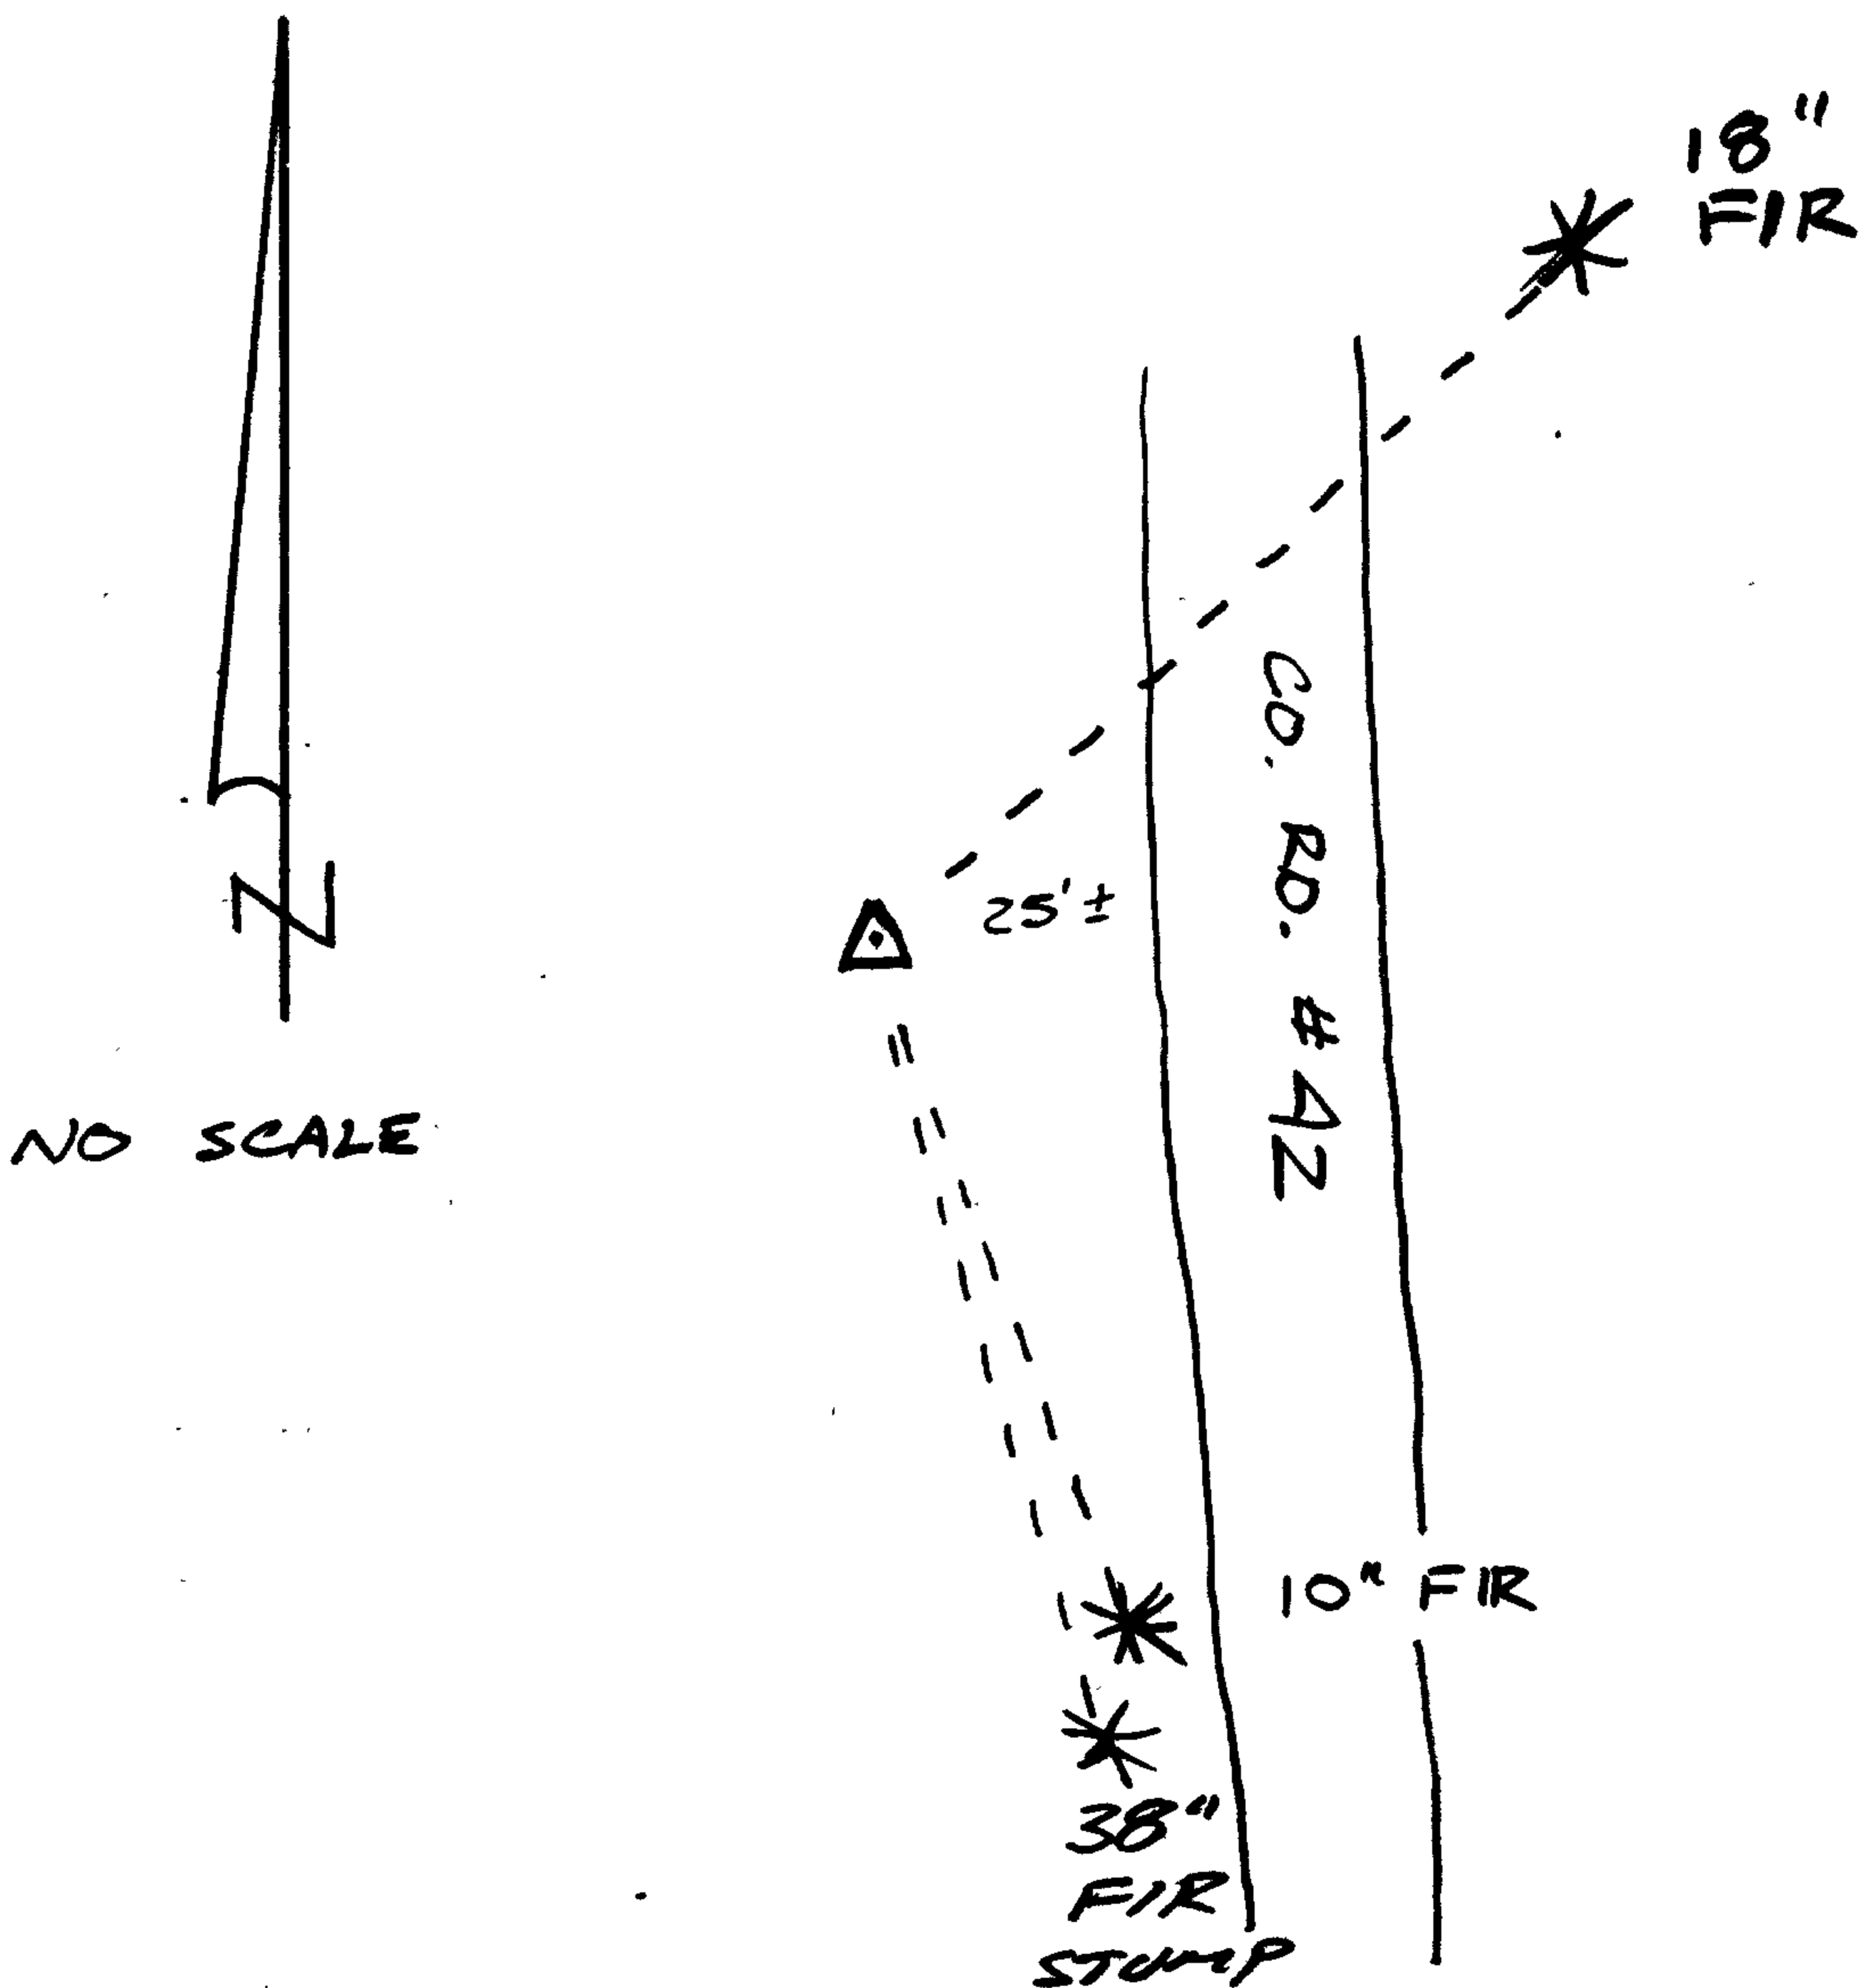

Comp. Declin. 19° E
 Agency DCSO
 Party Chief GREGORY E. QUIBELL
 Notekeeper Gregory E. Quibell
 Witnesses JOHN POWELL

OK
JEM

Surveyor's Seal

REGISTERED
PROFESSIONAL
LAND SURVEYOR

Gregory E. Quibell

OREGON
JULY 13, 1979
GREGORY E. QUIBELL
1834