

GOVERNMENT CORNER RESTORATION FORM

Township 245 Range 6W Sec. 2 County DOUGLAS

State OR Date 10-27-82 No. _____

Corner Designation T 245 R 6W
C 1/4 SEC. 2

- Condition Report Only
- Not Found
- Renewed
- Unrecorded
- Surveyed In
- Referenced Out

Previous Renewals # 34

MONUMENT DETAIL

Monument(s) Found: (Condition and Source)

FD. BED ROCK MARKED AS
PER DETAIL ON RT (REN. 34)

X
C 1/4

Accessories Found:

FD. CARVED "B*O" IN BEDROCK BEARS N35W 17E
TO MARKS, AS PER REN. # 34

FD. 30" FIR WITH BARK SCRIBED "C. YASZ BT"
BEARS N 61°E B 1/3 AS PER REN. # 34.

#131 ✓


G. & E. No. 62/1-27

RENEWAL

Monument Set (Procedure and Description)

Monument Detail

I DRIVE "PK" NAIL 1/2" INTO CENTER OF CARVED "X" IN BEDROCK.

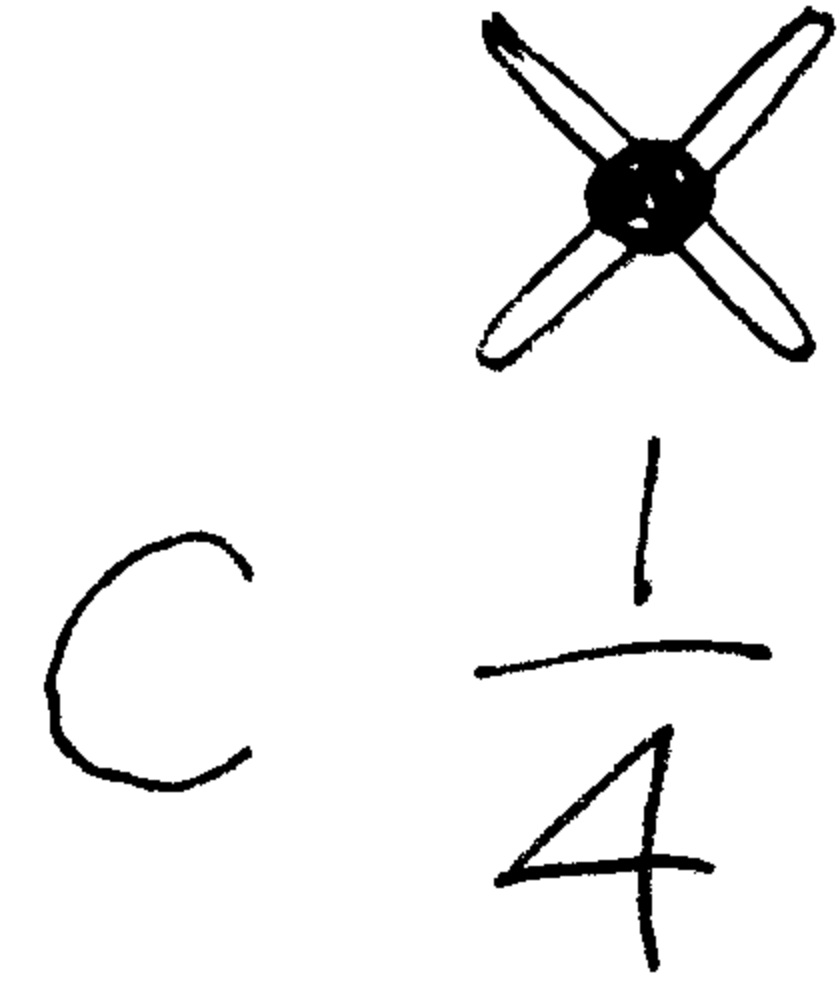


New Accessories

9" FIR SCRIBED "C X 4 S Z C S BT" IN DOUBLE BLAZE BEARS S13W 79.
 8" FIR SCRIBED "X CS BT" IN DOUBLE BLAZE BEARS S 68W 26E

Sketch of Monument, Accessories, and General Area

Location & Comments

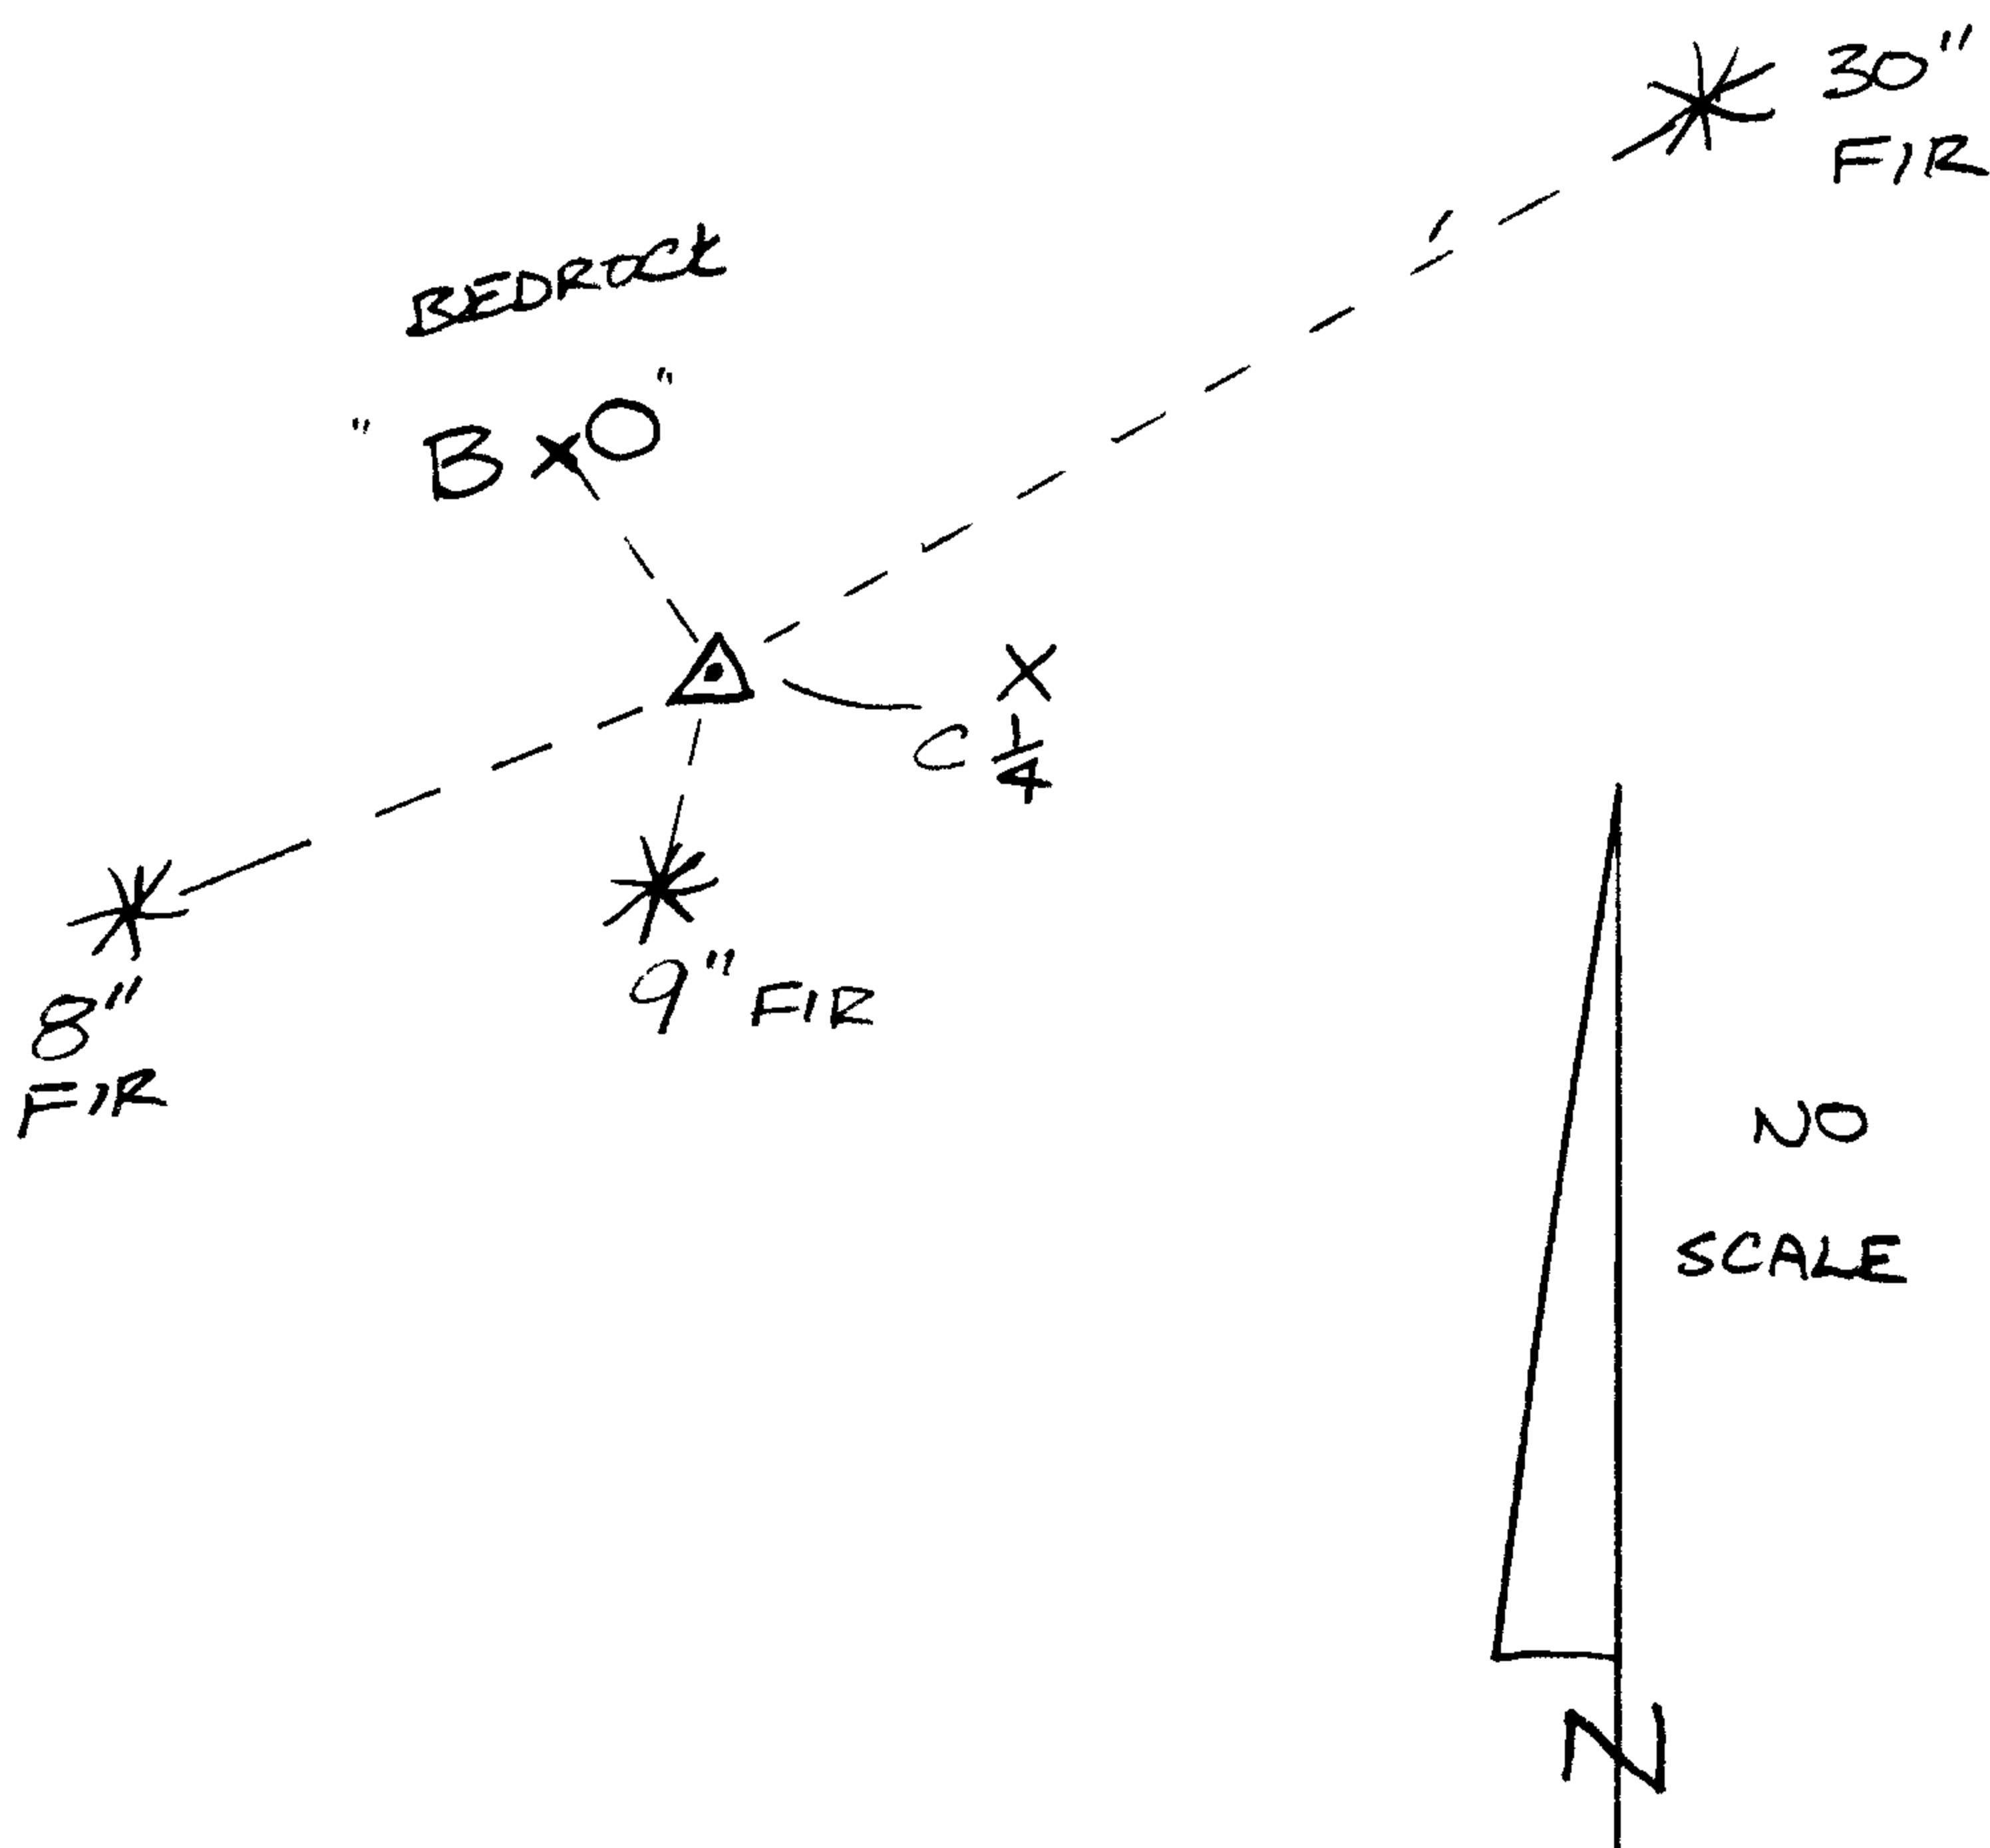

DCSO BT TAGS ON ALL TREES

Comp. Declin. 19° E
 Agency DCSO
 Party Chief GREGORY E. QUIBELL
 Notekeeper Gregory E. Quibell
 Witnesses KAREN REED
 TERRIE PLOUFFE

Surveyor's Seal

REGISTERED PROFESSIONAL LAND SURVEYOR

Gregory E. Quibell

OREGON
 JULY 13, 1979
 GREGORY E. QUIBELL
 1834