

GOVERNMENT CORNER RESTORATION FORM

Township 19S Range 10W Sec. 37 County DOUGLAS

State OR Date 11-16-82 No. _____

Corner Designation T19S R10W

WC TO

28	27
33	34

- _____ Condition Report Only
- _____ Not Found
- Renewed
- _____ Unrecorded
- _____ Surveyed In
- _____ Referenced Out

Previous Renewals #10 M 92-29

MONUMENT DETAIL

Monument(s) Found: (Condition and Source)

FD. 1" IP WITH BRASS CAP ATTACHED
FIRMLY SET PER REN. #10.

FD. ORIG. COR TREE, NOW 16" ROTTED
STUB WITH SCRIBING VISIBLE.

FD. IP BEARS N58°29'W 1 1/2 FT
FROM CENTER OF COR. STUMP.
(REC. PER REN. #10 WEST 12)

SURVEYORS
T19S
S28 | S27
S33 | S34
R10W
1968
COUNTY OFFICE

Accessories Found: FROM SEC COR.

FD. ORIG. 7" FIR NOW 12" SNAG WITH SCRIBING VISIBLE IN PREVIOUSLY
OPENED BLAZE BEARS N 30 E 11 1/2 FT.

FD. ORIG. 12" NOW 39" FIR WITH GOOD SCAR BEARS S 51 W 12 1/2 FT

FD. ORIG. 12" NOW 20" FIR SNAG, SHOWING PREVIOUS AXE WORK
BEARS N 39° W 10 1/2 FT

FD. 20" FIR PER REN #10 NOW 23" WITH GOOD SCAR BEARS
N 71 W 12 1/2.

FD. 22" FIR PER REN #10 NOW 37" WITH GOOD SCAR BEARS
S 65 E 47 1/2 (REC 48 1/2)

FD. 16" FIR PER REN #10 NOW 18" WITH GOOD SCAR BEARS
N 89° E 27 1/2 (REC 28 1/2)

#31 ✓

G.S. File No. 62/1-29

RENEWAL

Monument Set (Procedure and Description)

Monument Detail


I ADD MARKS "W.C. TO"
 "S 58 29 E 1.3 FT."
 TO FD. BRASS CAP

SURVEYORS
 COUNTY TIAS
 W.C. TO
 S 28 S 27
 S 33 S 34
 S 58 29 E 1.3 FT
 R 10 W
 1968
 OFFICE

New Accessories

(This section is crossed out with a diagonal line.)

Sketch of Monument, Accessories, and General Area

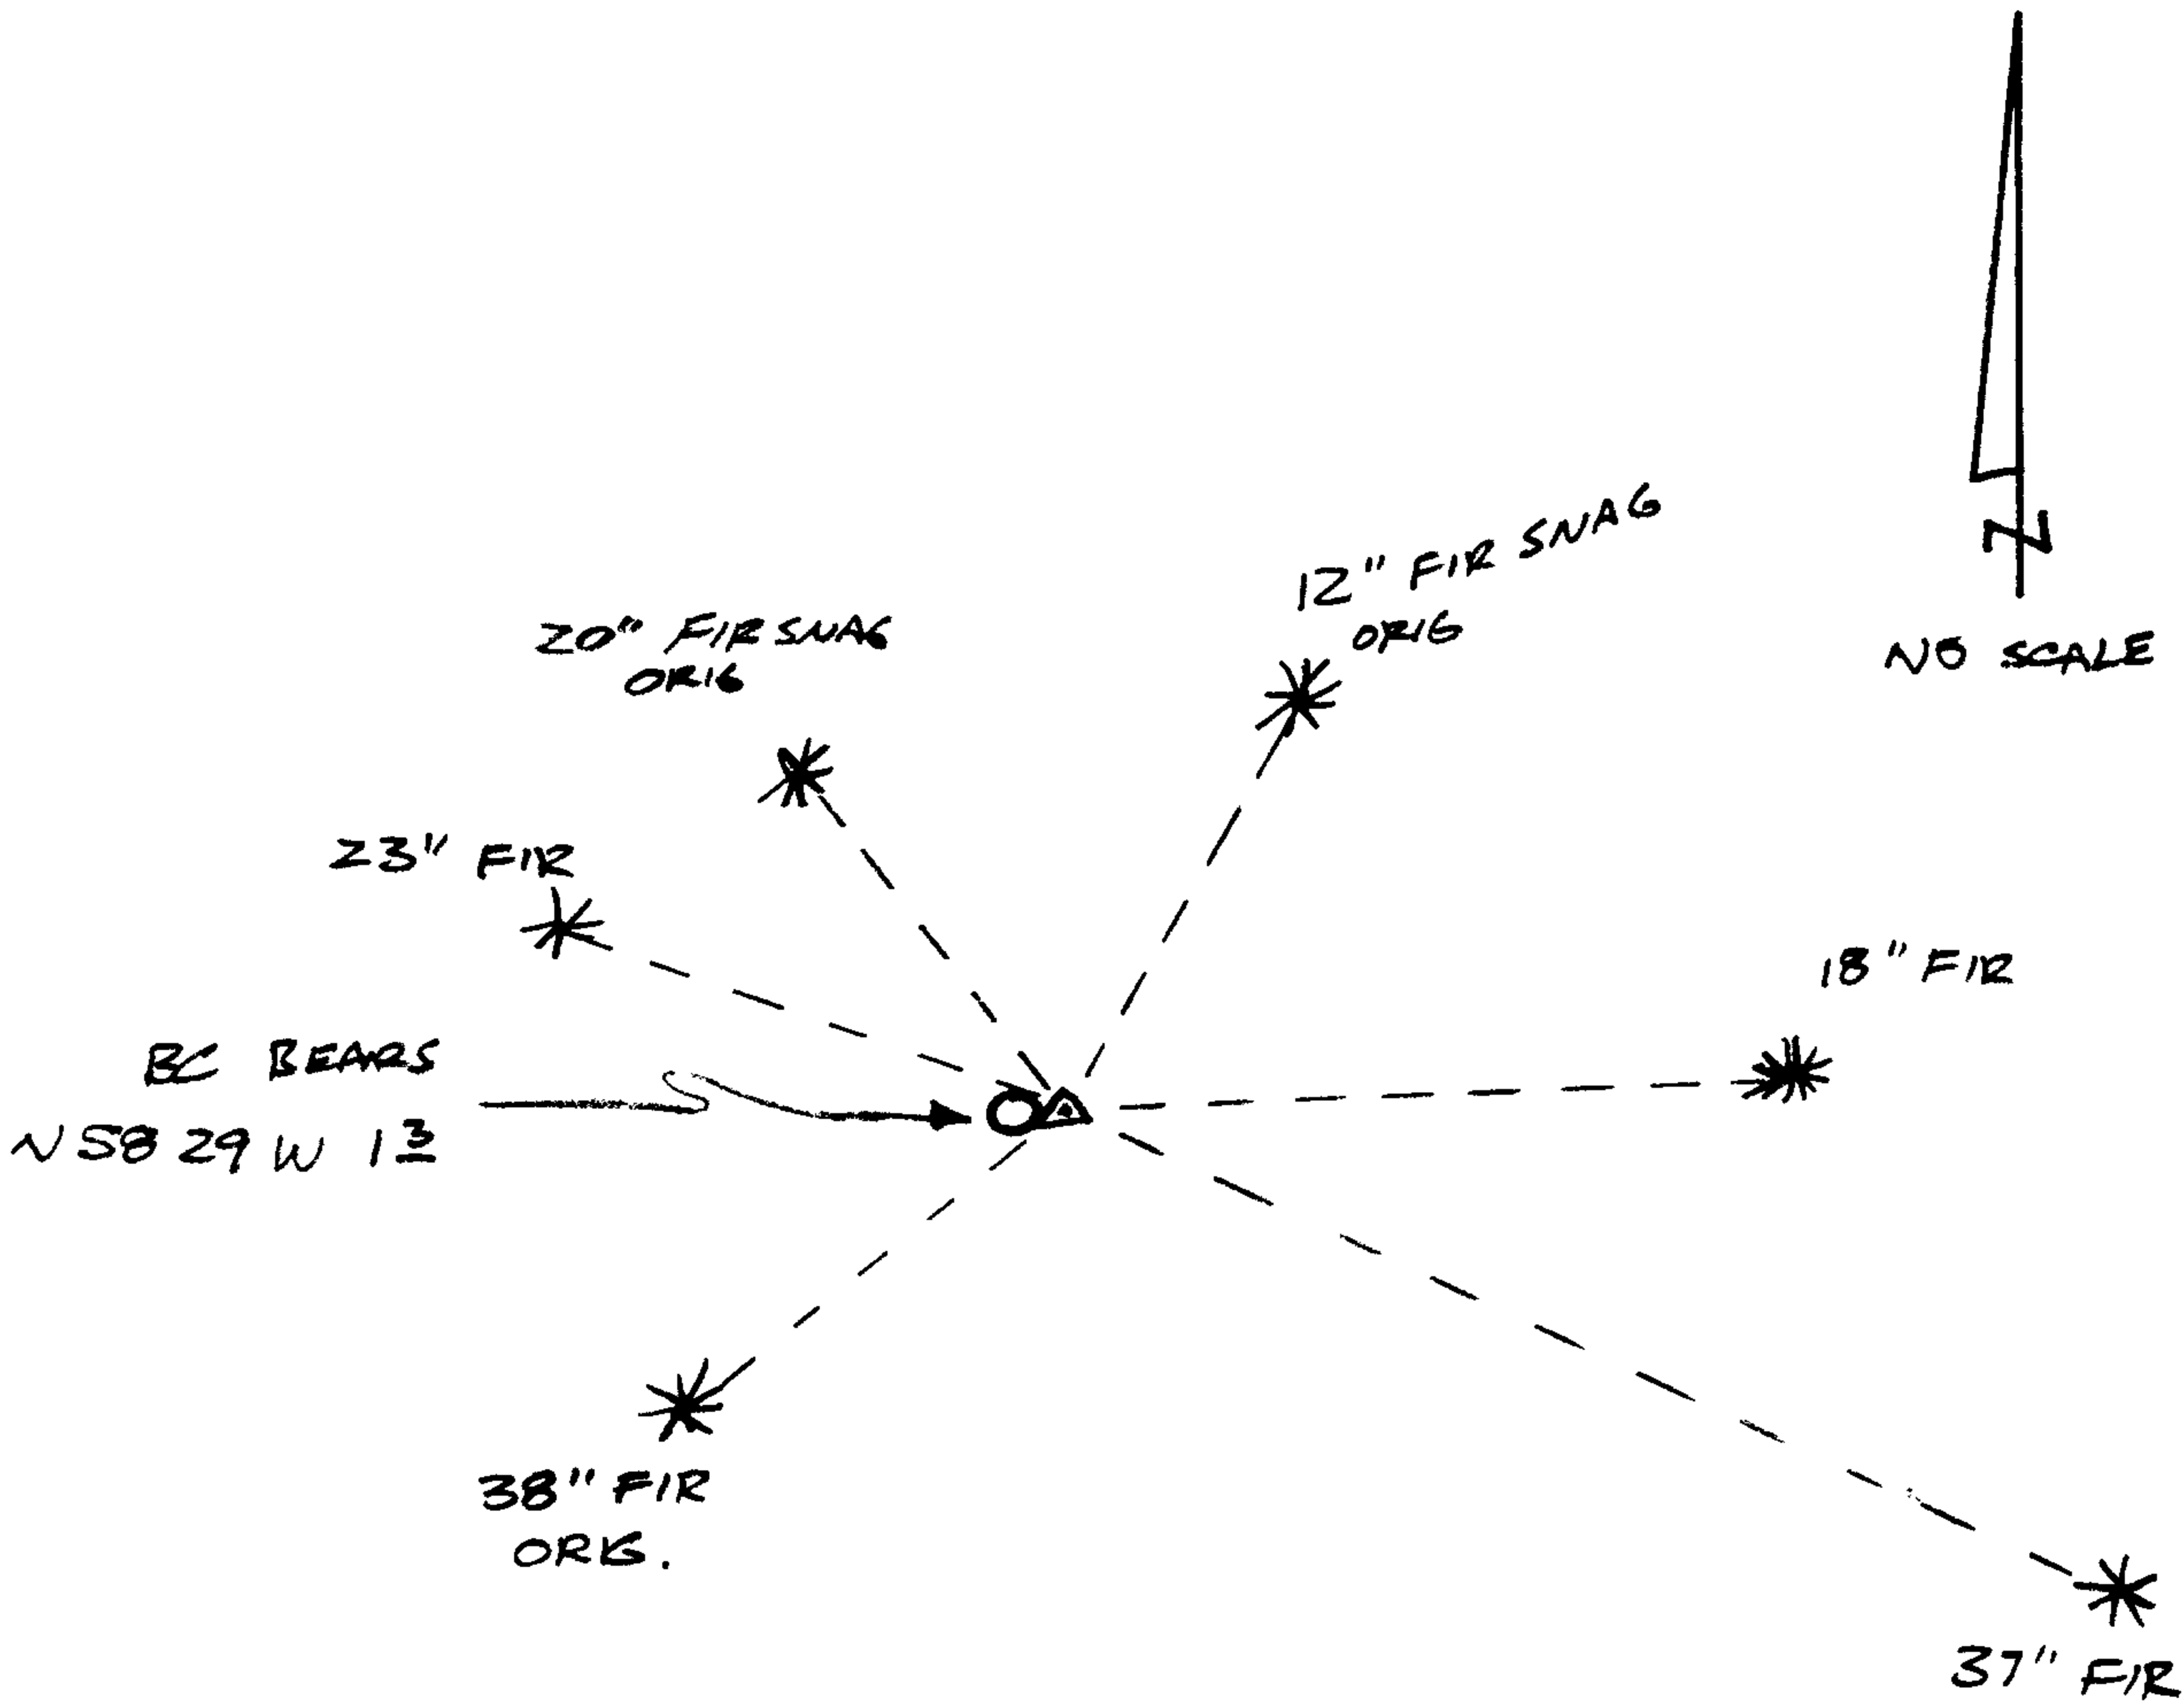

Location & Comments

(This section is mostly blank with some faint lines.)

Comp. Declin. 19° E
 Agency DCSO
 Party Chief GREGORY E. QUIBELL
 Notekeeper Gregory E. Tubell
 Witnesses RAMON SMITH

(Handwritten signature/initials)

Surveyor's Seal

REGISTERED
 PROFESSIONAL
 LAND SURVEYOR

Gregory E. Tubell

OREGON
 JULY 13, 1979
 GREGORY E. QUIBELL
 1834