

GOVERNMENT CORNER RESTORATION FORM

Township 22 S Range 6 W Sec. 12 County DOUGLAS

State OR Date 11-15-82 No. _____

Corner Designation

T22S R6W

$\frac{1}{4}$ $\frac{12}{13}$

- _____ Condition Report Only
- _____ Not Found
- Renewed
- _____ Unrecorded
- _____ Surveyed In
- _____ Referenced Out

Previous Renewals #18, #47 & #126

MONUMENT DETAIL

Monument(s) Found: (Condition and Source)

FD. HAWES "T" IRON WITH COPPER CAP
PER REN. #47.

Accessories Found:

? MAYBE 36"

FD. ORIG. 6" NOW 40" FIR WITH WELL HEALED BLAZE ALSO BARK SCRIBED
"1/4 SIZ CS" BEARS N 19° E 21.8 FT.

FD. 16" W. OAK PER REN. #18 NOW 26" ROTTED REMAINS OF
STUMP BEARS SOUTH 94.8.

FD. 25" FIR PER REN. 126 NOW WINDFALL WITH PARTIALLY
HEALED BLAZE BEARS N 46 W 2.58 TO ROOT HOLE.

#143 ✓

D. S. File No. 62/1-31
D. S. File No. _____

RENEWAL

Monument Set (Procedure and Description)

I REFERENCE FD "T" IRON, THEN SET
 1" x 30" IP WITH BRASS CAP IN ITS
 PLACE. I RESET FD. "T" IRON ALONG
 SOUTH EDGE OF BRASS CAP AND
 SLIGHTLY LOWER.


Monument Detail

CO
 T 225
 DOUGLAS SURVEYOR
 $\frac{1}{4}$ $\frac{S12}{S13}$
 R 6W
 1982

New Accessories

15" FIR SCRIBED "1/4 S12 CS BT" IN DOUBLE BLAZE BEARS N 30° W 86⁹ FT.
 6" W. OAK SCRIBED "1/4 S13 CS BT" IN DOUBLE BLAZE BEARS S 56° E 68 FT.
 8" DOUBLE W. OAK SCRIBED "1/4 S13 CS BT" IN DOUBLE BLAZE BEARS S 70° E 23° FT.

Sketch of Monument, Accessories, and General Area

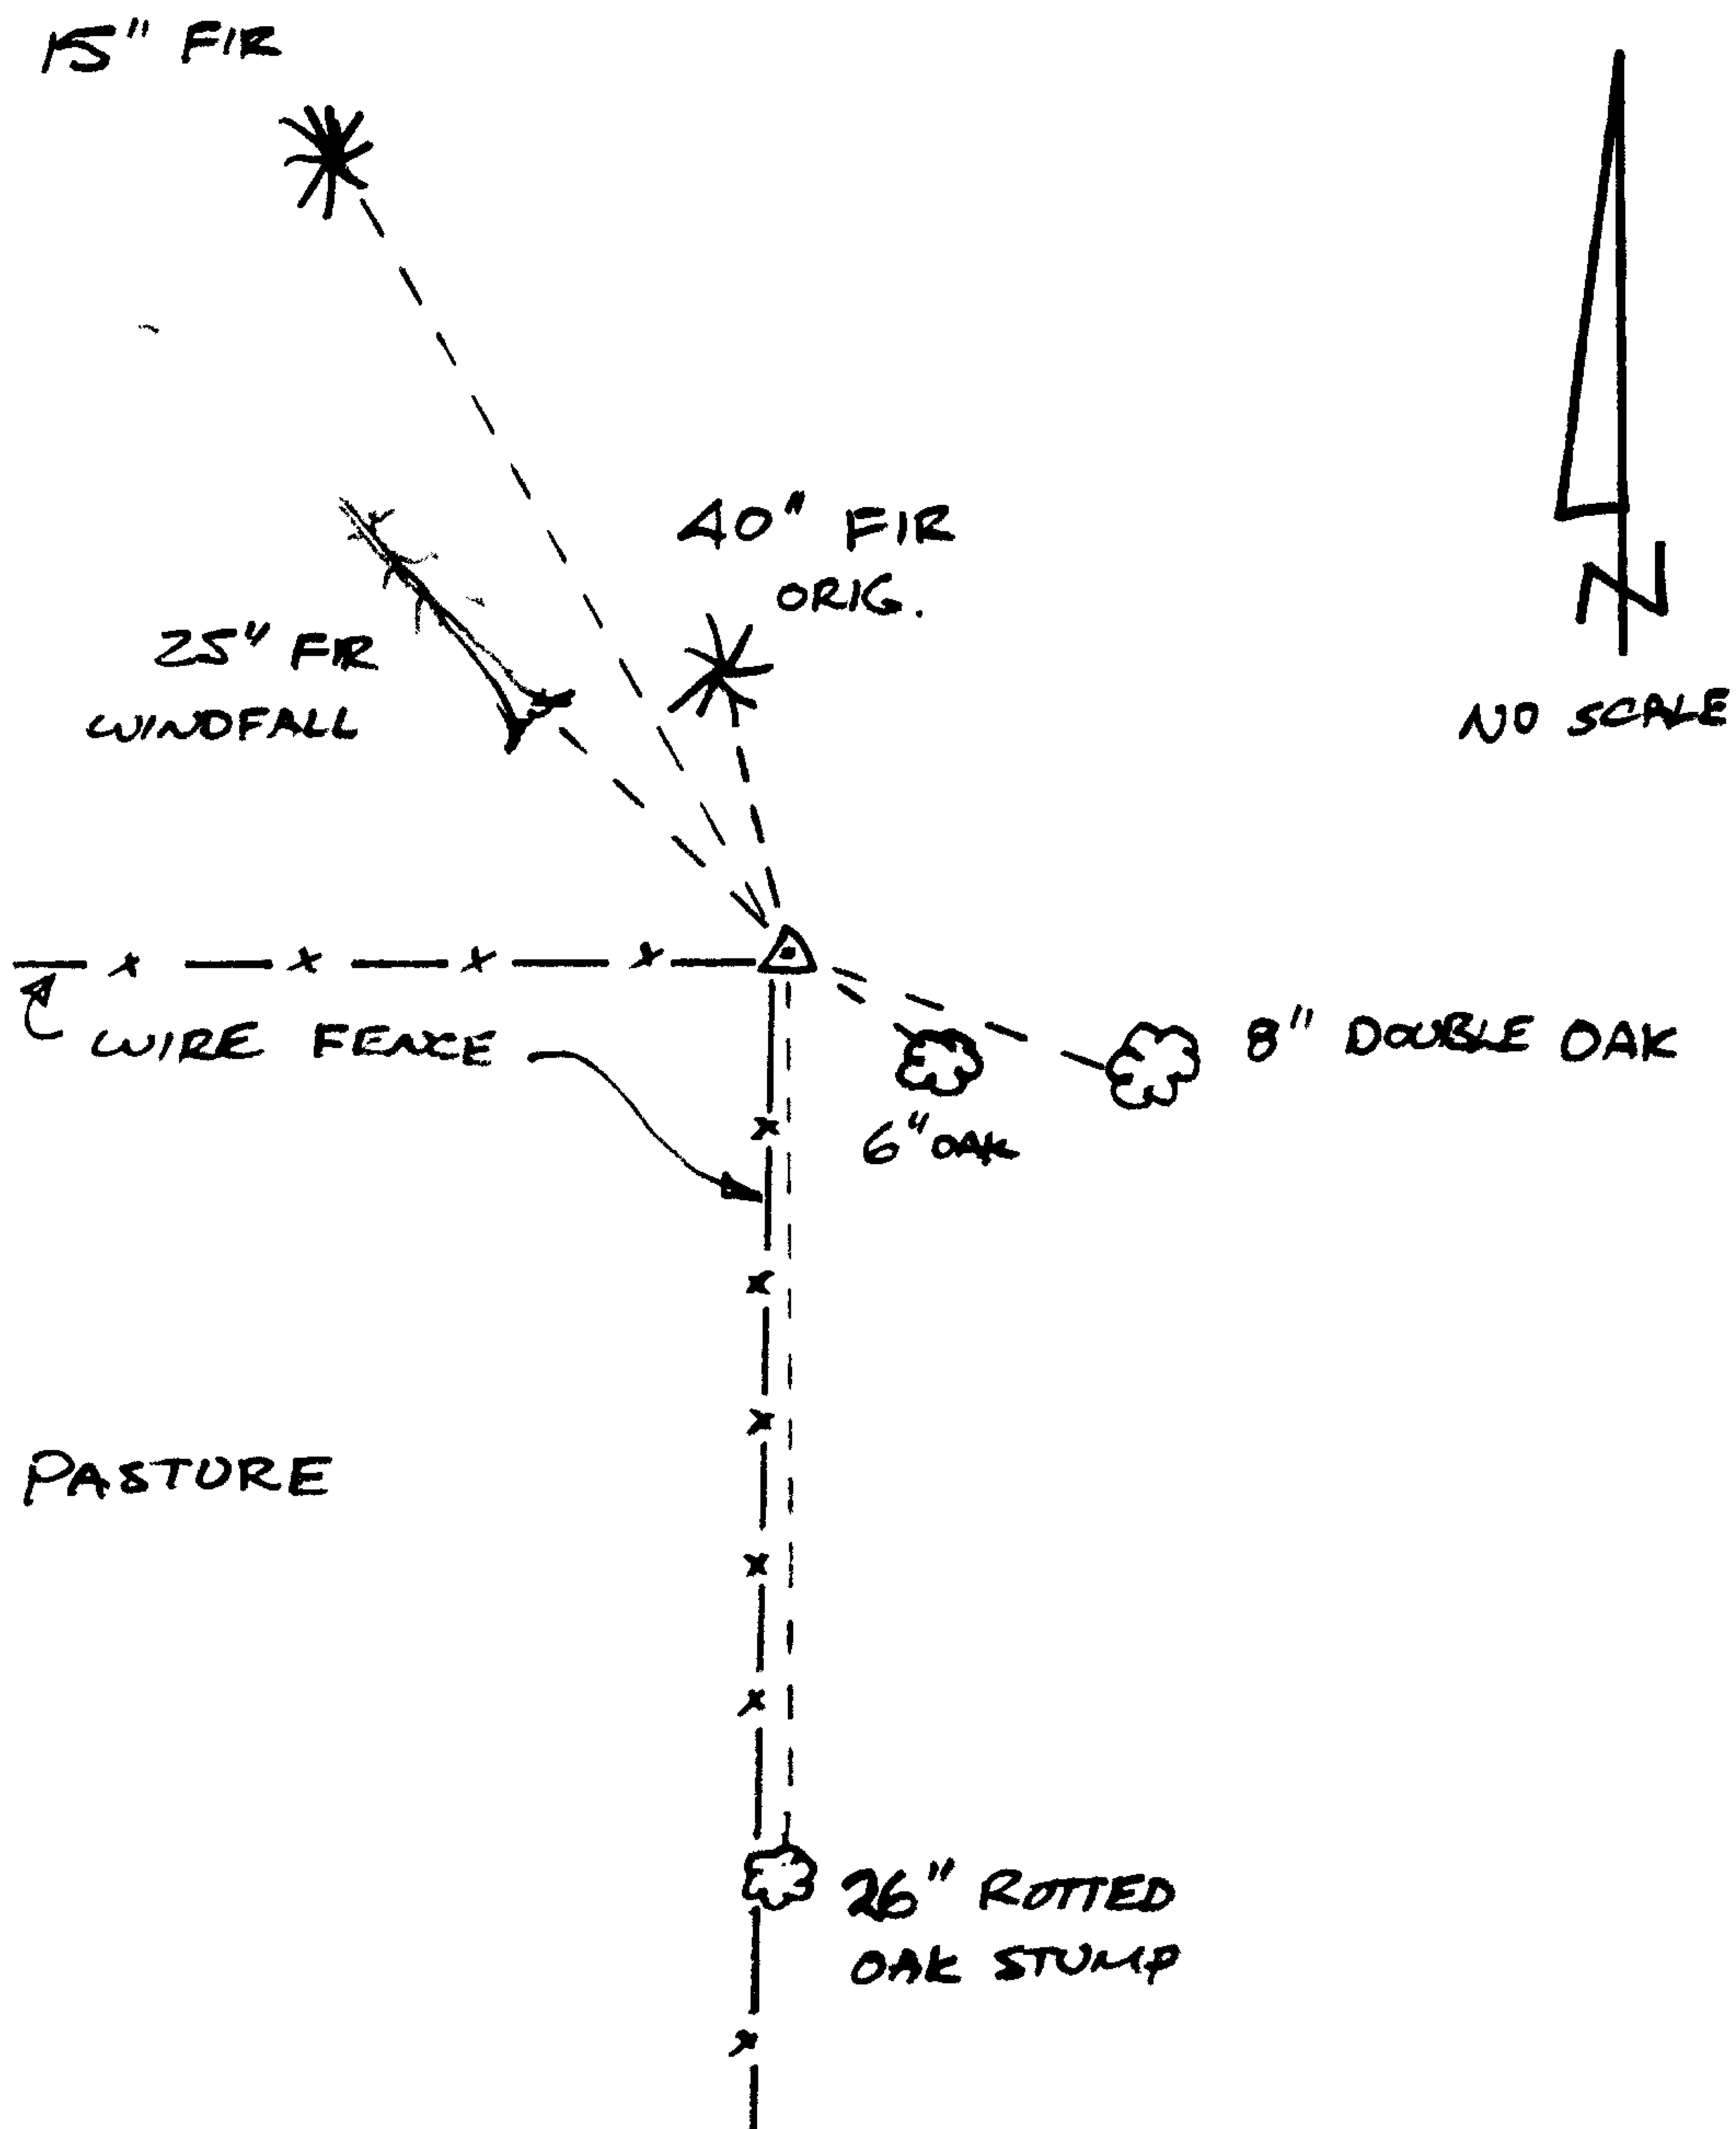

Location & Comments

DCSO RT TAGS ON ALL
 TREES
 Comp. Declin. 19° E
 Agency DCSO
 Party Chief GREGORY E. QUIBELL
 Notekeeper Gregory E. Quibell
 Witnesses RANDY SMITH

Surveyor's Seal

REGISTERED
 PROFESSIONAL
 LAND SURVEYOR

Gregory E. Quibell

OREGON
 JULY 13, 1979
 GREGORY E. QUIBELL
 1834

