

RENEWAL

Monument Detail

Monument Set (Procedure and Description)

SINCE THE FOUND BRASS CAP DID NOT FIT THE ORIG. BT'S., I SET A 1" x 30" IP WITH BRASS CAP ATTACHED AT RECORD BEARING & DIST. FROM THE STANDING ORIG 10" NOW 38" FIR (S 62° W 37 1/2 FT.) BEARING & DIST. TO ROOT HOLE OF DOWN 38" FIR BT IS: S 72° W 62 FT (REC. S 77° W 52 FT) BEARING & DIST TO FD. FOREST APPRAISAL TAG IS: S 14° E 48 FT (REC APPROX 40 FT SIDE)


FD. BRASS CAP BEARS N 13° E 36 FT. FROM BRASS CAP WHICH I SET.

CO
DOUGLAS 1/4 T22S SURVEYOR
S 25
S 36
R 9 W
1982

New Accessories

21" HEMLOCK SCRIBED "YAS 36 CS BT" IN DOUBLE BLAZE BEARS S 14° E 48 FT.
11" FIR SCRIBED "YAS 36 CS BT" IN DOUBLE BLAZE BEARS S 88° W 36 FT.
8" FIR SCRIBED "YAS 25 CS BT" IN DOUBLE BLAZE BEARS N 41° W 12 FT.

Sketch of Monument, Accessories, and General Area

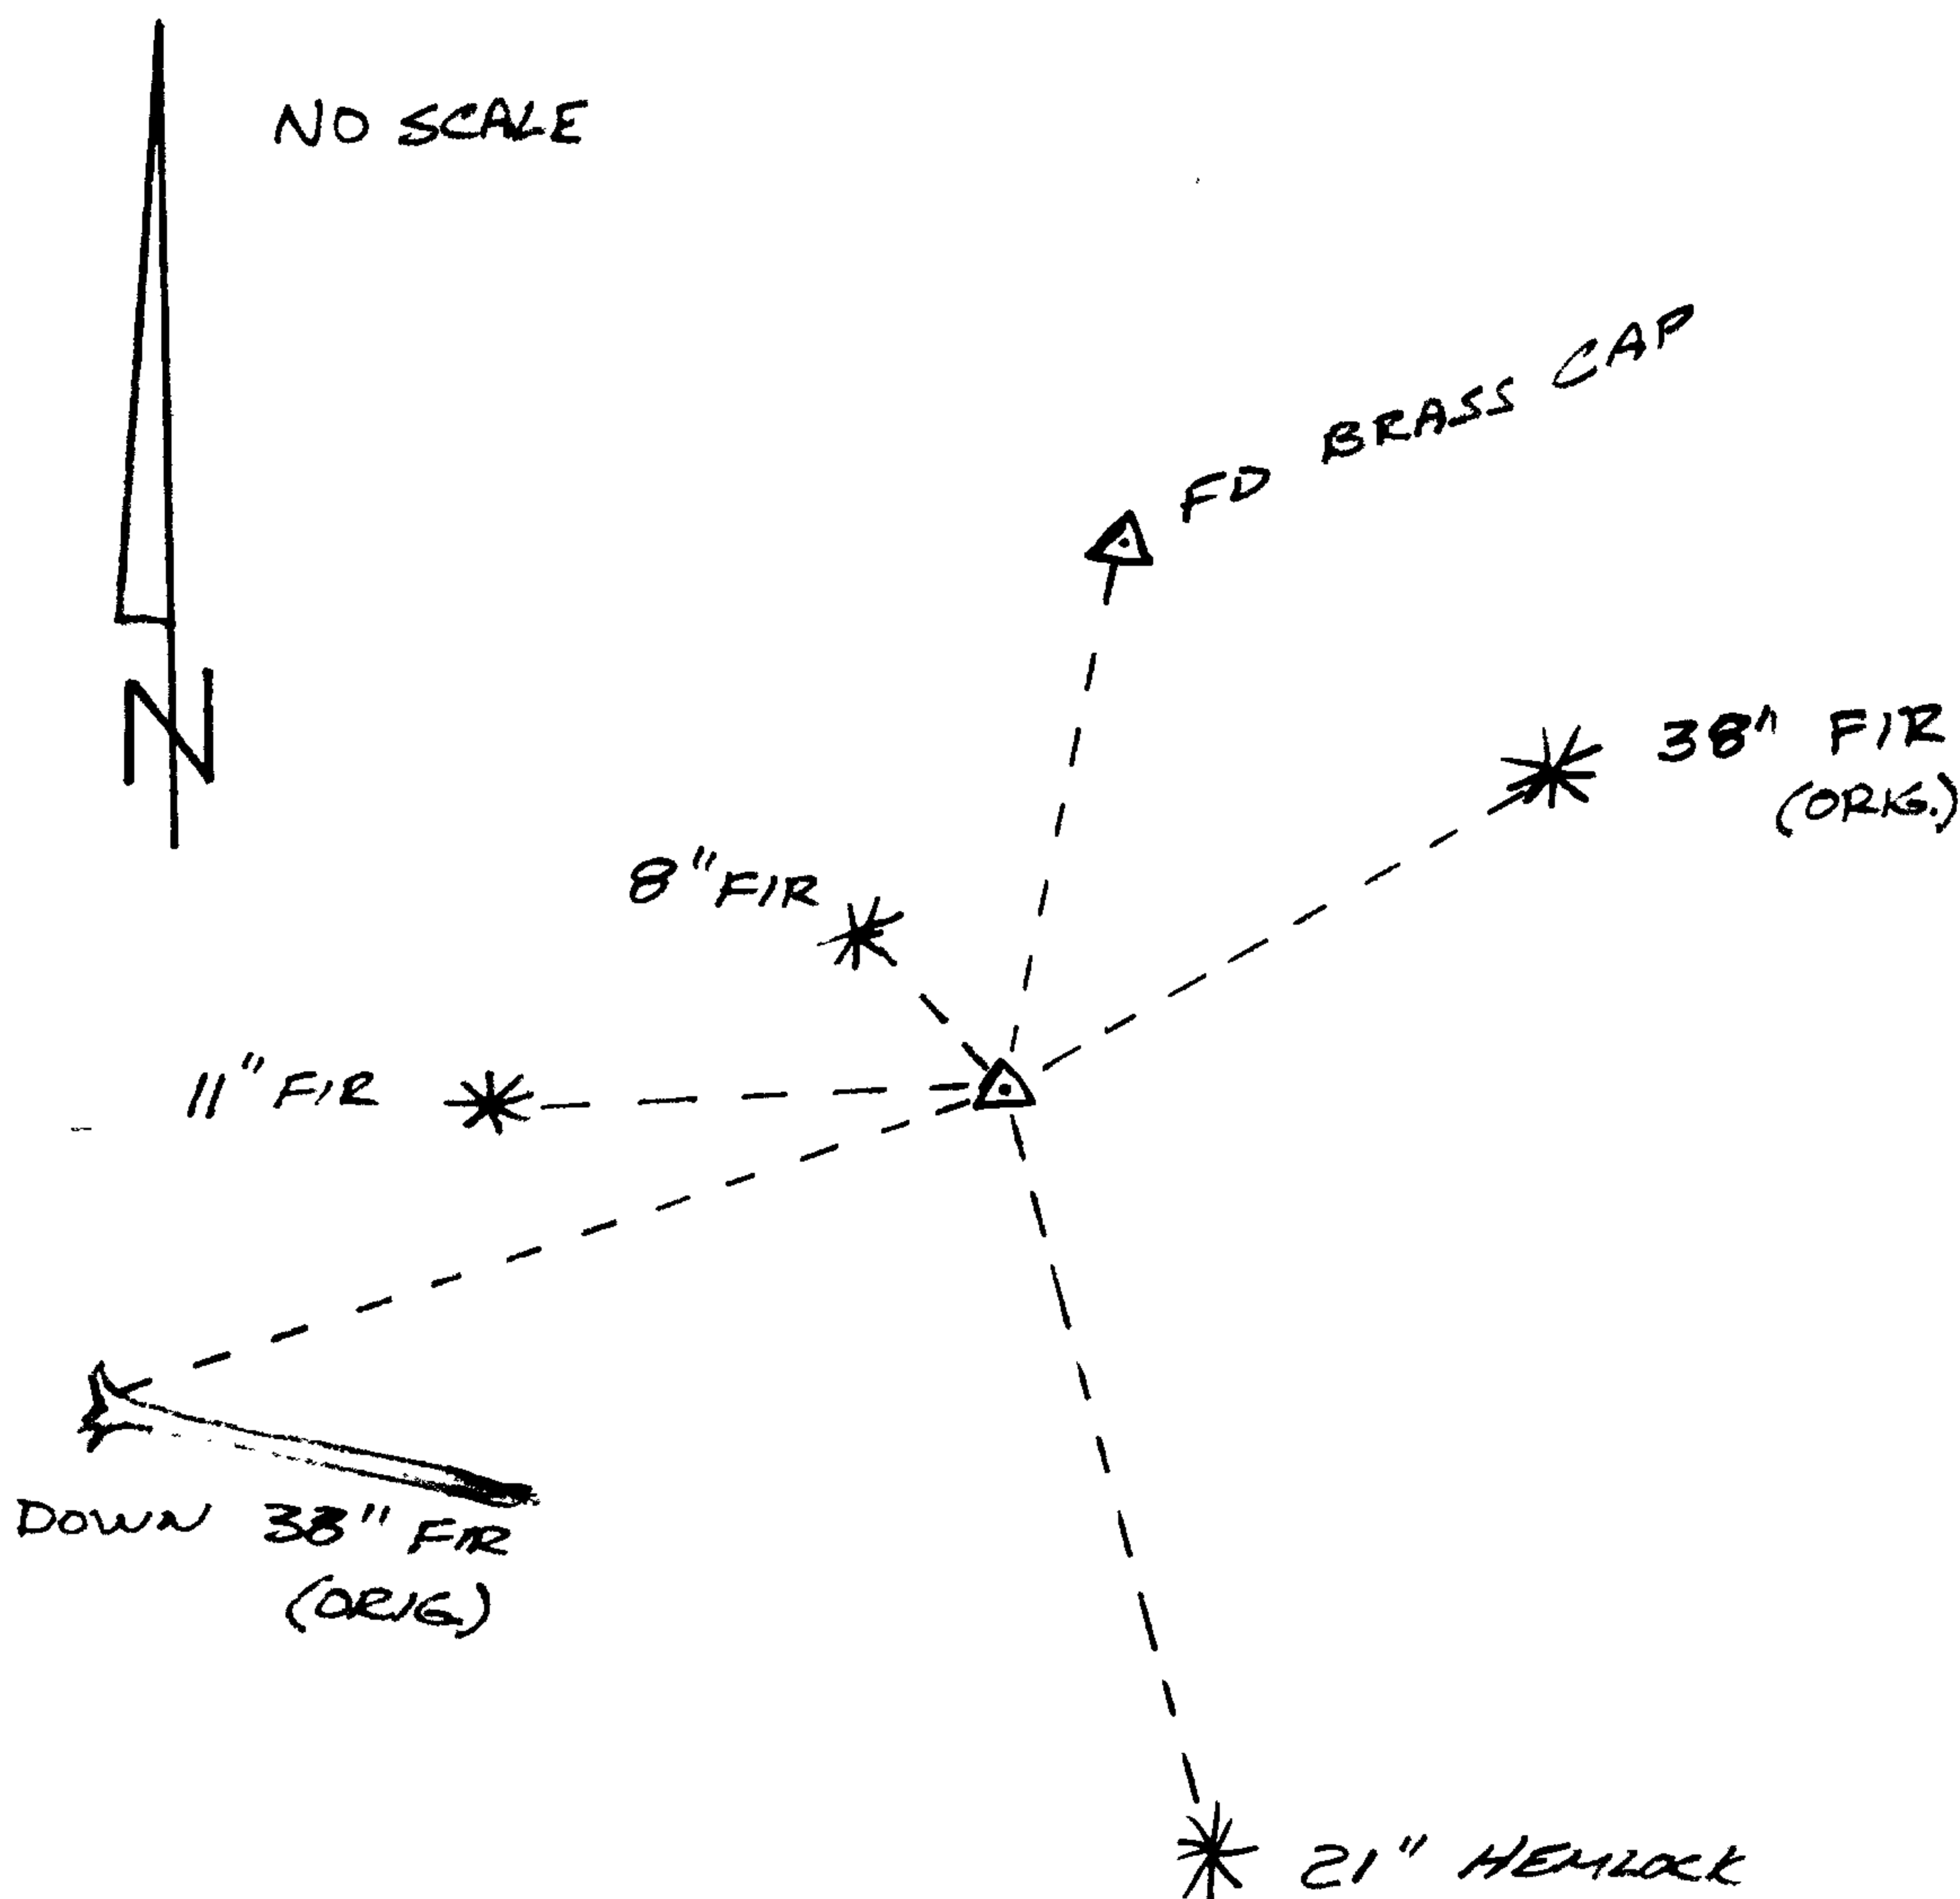

Location & Comments

DCSO BT TAGS PLACED ON ALL BT'S


Comp. Declin. 19° E
Agency DCSO
Party Chief GREGORY E. QUIBELL
Notekeeper Gregory E. Quibell
Witnesses JOHN POWELL
RANDY SMITH

Surveyor's Seal

REGISTERED
PROFESSIONAL
LAND SURVEYOR

Gregory E. Quibell

OREGON
JULY 13, 1979
GREGORY E. QUIBELL
1834

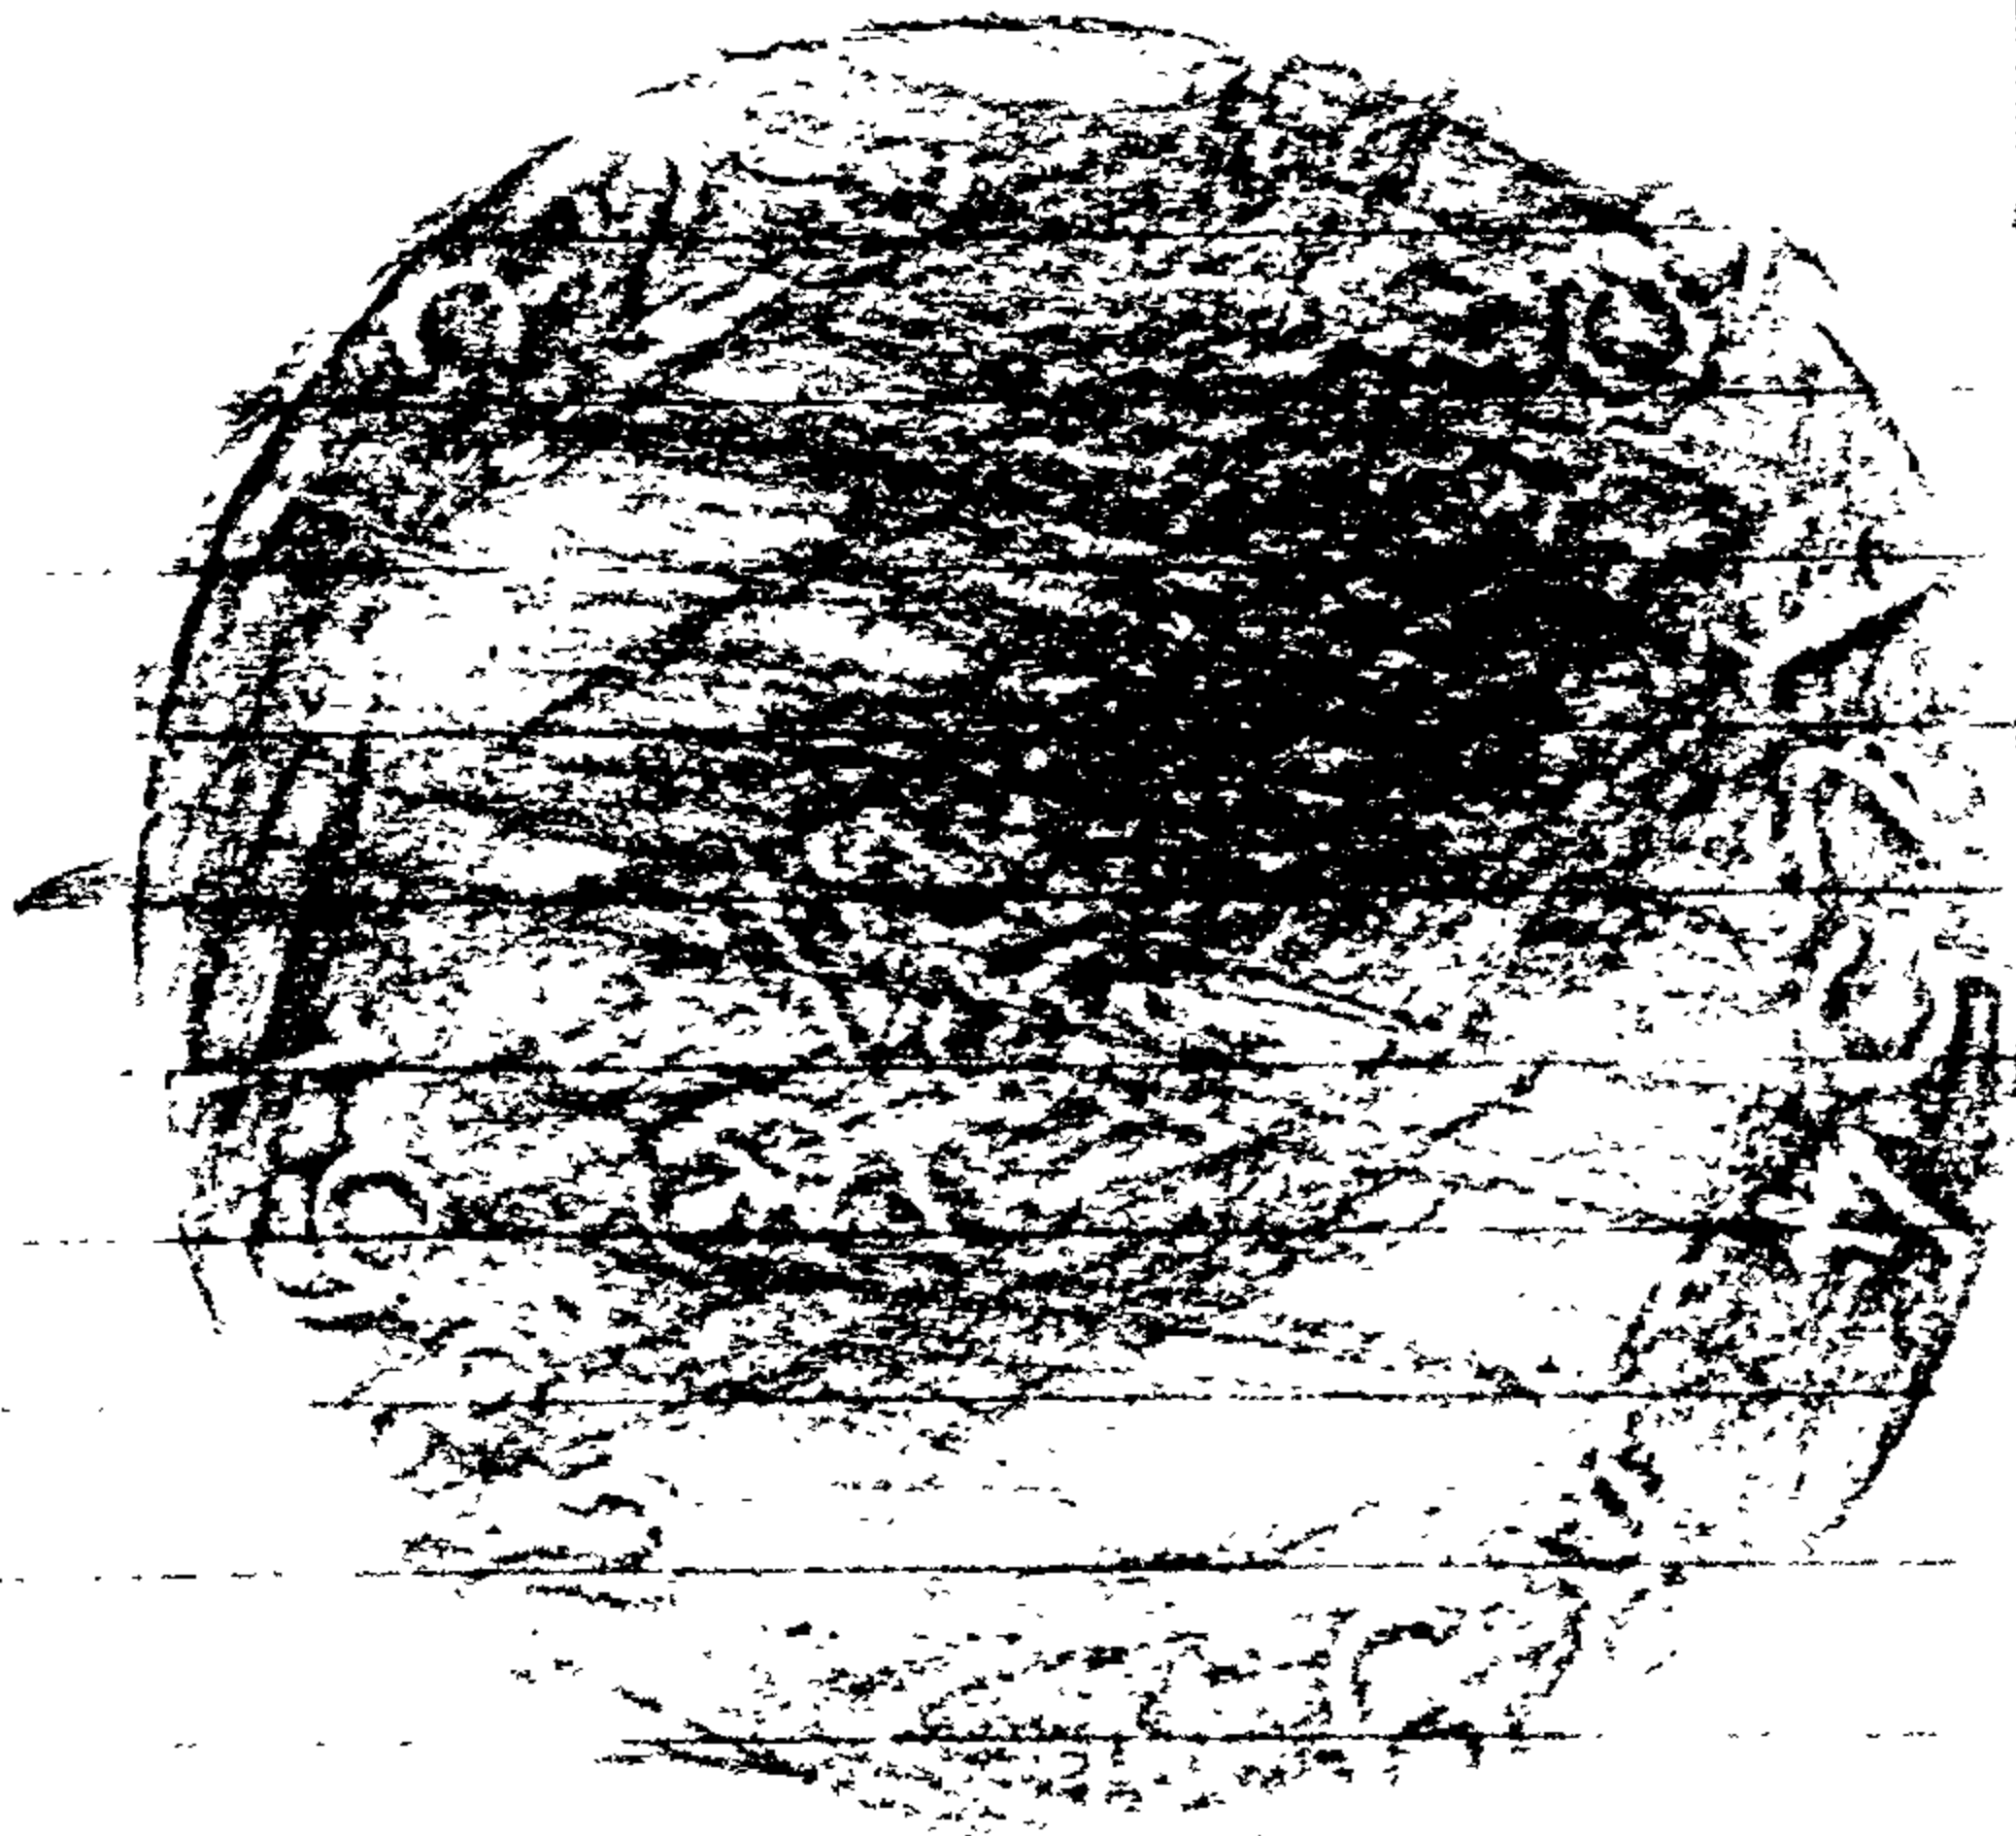

Tp 22 S Rge 9 W Sec 36

(36)

APPROX

40 FT N15W TO N1/4 COR

~~40 FT~~

FOREST APPRAISAL

DEPT.

DO. CO. OR.

T22S PLS 125A
1/4 25
36
R9W
1982

C. S. File No. 62/1-32

HANLIN
4/13/54

C. S. File No. 62/1-32

Subdivisions of T. 22 S., R. 9 W.

WEST COAST PRINTING & BINDING CO., PORTLAND 13725

CHAINS

Marked T. 22 S., R. 9 W., S. 25 B. T.

A Fir, 48 ins. diam., bears S.68*E., 135 lks. dist.

Marked T. 22 S., R. 9 W., S. 36 B. T.

A Fir, 36 ins. diam., bears S.25*W., 133 lks. dist.

Marked T. 22 S., R. 9 W., S. 35 B. T.

A Fir, 32 ins. diam., bears N.27*W., 29 lks. dist.

Marked T. 22 S., R. 9 W., S. 26 B. T.

Land, mountainous: 80.00 chs.

Soil, second rate.

Timber, Fir, Cedar, Maple and Alder.

Undergrowth, dense vine-Maple, Hazel, Rhododendron, Arrow-wood, Salmonberry, Salal and Thimbleberry. 80.00 chs.

October 24, 1894.

Thence, I run,

S.89*47'E., on true line, between secs. 25 and 36.

Va. 20*E.

4.75 Spur, Course SE. + 100

Descend.

21.00 A creek, 12 lks. wide, Course NE. - 200

Ascend.

37.00 Top of spur, Course NE. + 200

Descend.



40.00 Set Fir post, 4 1/2 feet long, 4 ins. square, 24 ins. in

ground, on hillside sloping E. for 1/2 sec. corner,

marked 1/4 S. on the N. face, from which,

A Fir, 10 ins. diam., bears N.62*E., 57 lks. dist.

Marked 1/4 S. B. T.

A Fir, 36 ins. diam., bears S.77*W., 80 lks. dist.

Marked 1/4 S. B. T.

52.10 A creek, 10 lks. wide, Course N.15*W.

66.50 Entered swamp, Course NW.

68.25 Leave swamp and ascend.

11" FIR
S 88°W
36
1/4 S 36 CS BT

8" FIR
N 41°W
12
1/4 S 25 CS BT

DOUGLAS COUNTY SURVEYOR
25
4 36
R 11 W
1982

620
S 72 W 52.8" STUMP MARK

21" HEMLOCK
S 14°E
48
1/4 S 36 CS BT

TO FD, CAP

N 13°E
36

C.S. File No. 6211-32