

GOVERNMENT CORNER RESTORATION FORM

Township 30 S Range 8 W Sec. 30 County DOUGLAS

State OR. Date 12-13-82 No. \_\_\_\_\_

Corner Designation

T 30 S

R	25	30	R
9	36	31	8
W			W

- \_\_\_\_\_ Condition Report Only
- \_\_\_\_\_ Not Found
- Renewed
- \_\_\_\_\_ Unrecorded
- \_\_\_\_\_ Surveyed In
- \_\_\_\_\_ Referenced Out

Previous Renewals T30-9 #97 #89 T308

MONUMENT DETAIL

Monument(s) Found: (Condition and Source)

FD 1" x 30" IP WITH BRASS CAP  
ATTACHED STANDING LOOSELY APPROX  
4" IN THE GROUND. BRASS CAP  
PER REN. #97.

SURVEYORS  
 T 30 S  
 COUNTY  
 R  
 9  
 W  

S 25	S 30	R
S 36	S 31	8
		W

 OFFICE

1968

Accessories Found:

- \* ORIG. 15" NOW 28" FIR BEARS N 43 W 24 1/2 FT. (REC. N 47 W)  
WITH PITCHED OVER PREVIOUSLY OPENED BLAZE.
- \* ORIG. 30" NOW 54" FIR WITH SCRIBED "BT" IN PREVIOUSLY OPENED BLAZE,  
ALIVE. DID NOT TAKE BEARING & DIST. SINCE IT WOULD HAVE  
REQUIRED CUTTING MANY TREES OUT OF LINE OF SIGHT AND I  
HAD 6 OTHER BT'S. CLOSE TO COR.
- \* ORIG. 15" NOW 32" PINE WITH PITCHED OVER PREVIOUSLY OPENED BLAZE BEARS  
N 28 E 57 1/2 FT. (REC. N 25 E)
- \* 9" FIR PER REN. #97, NOW 10" WITH WELL HEALED SINGLE BLAZE BEARS  
S 52 E 16 1/2.
- \* 11" W. OAK PER REN. #97, WITH SCRIBED "S RBW S 30 CS BT"  
IN PARTIALLY HEALED BLAZE BEARS N 6 S E 33 1/2 (REC. 34 1/2)
- \* 8" NOW 9" W. OAK PER REN. #97 WITH SCRIBED "T 30 S R 9 W S 25 CS BT"  
BEARS N 10 W 30 1/2 FT.
- \* 8" NOW 10" FIR PER REC. #97 WITH WELL HEALED SINGLE BLAZE  
BEARS S 82 W 26 1/2.
- \* FD. ROOT HOLE AND ROTTED REMAINS OF POSSIBLE ORIG. 5" OAK  
WITH NO SCRIBING OR FACE VISIBLE. ROOT HOLE BEARS S 22 E  
6 1/2 FT. (REC. S 10 E 5 1/2)

#13 T30-9 ✓  
 #13 T30-8 ✓

C

RENEWAL

Monument Set (Procedure and Description)

SINCE THE LOCATION I FOUND THE BRASS CAP AT FIT ALL THE TREES WELL, I REFERENCE ITS LOCATION AND RESET THE PIPE 24" INTO THE GROUND, AND ADD THE MARKS "RESET 1982" TO THE CAP

Monument Detail

SURVEYORS  
OFFICE

COUNTY

R  
9  
W

T 30 S


525	530
536	531

R  
8  
W

RESET  
1982  
1968

New Accessories

Sketch of Monument, Accessories, and General Area

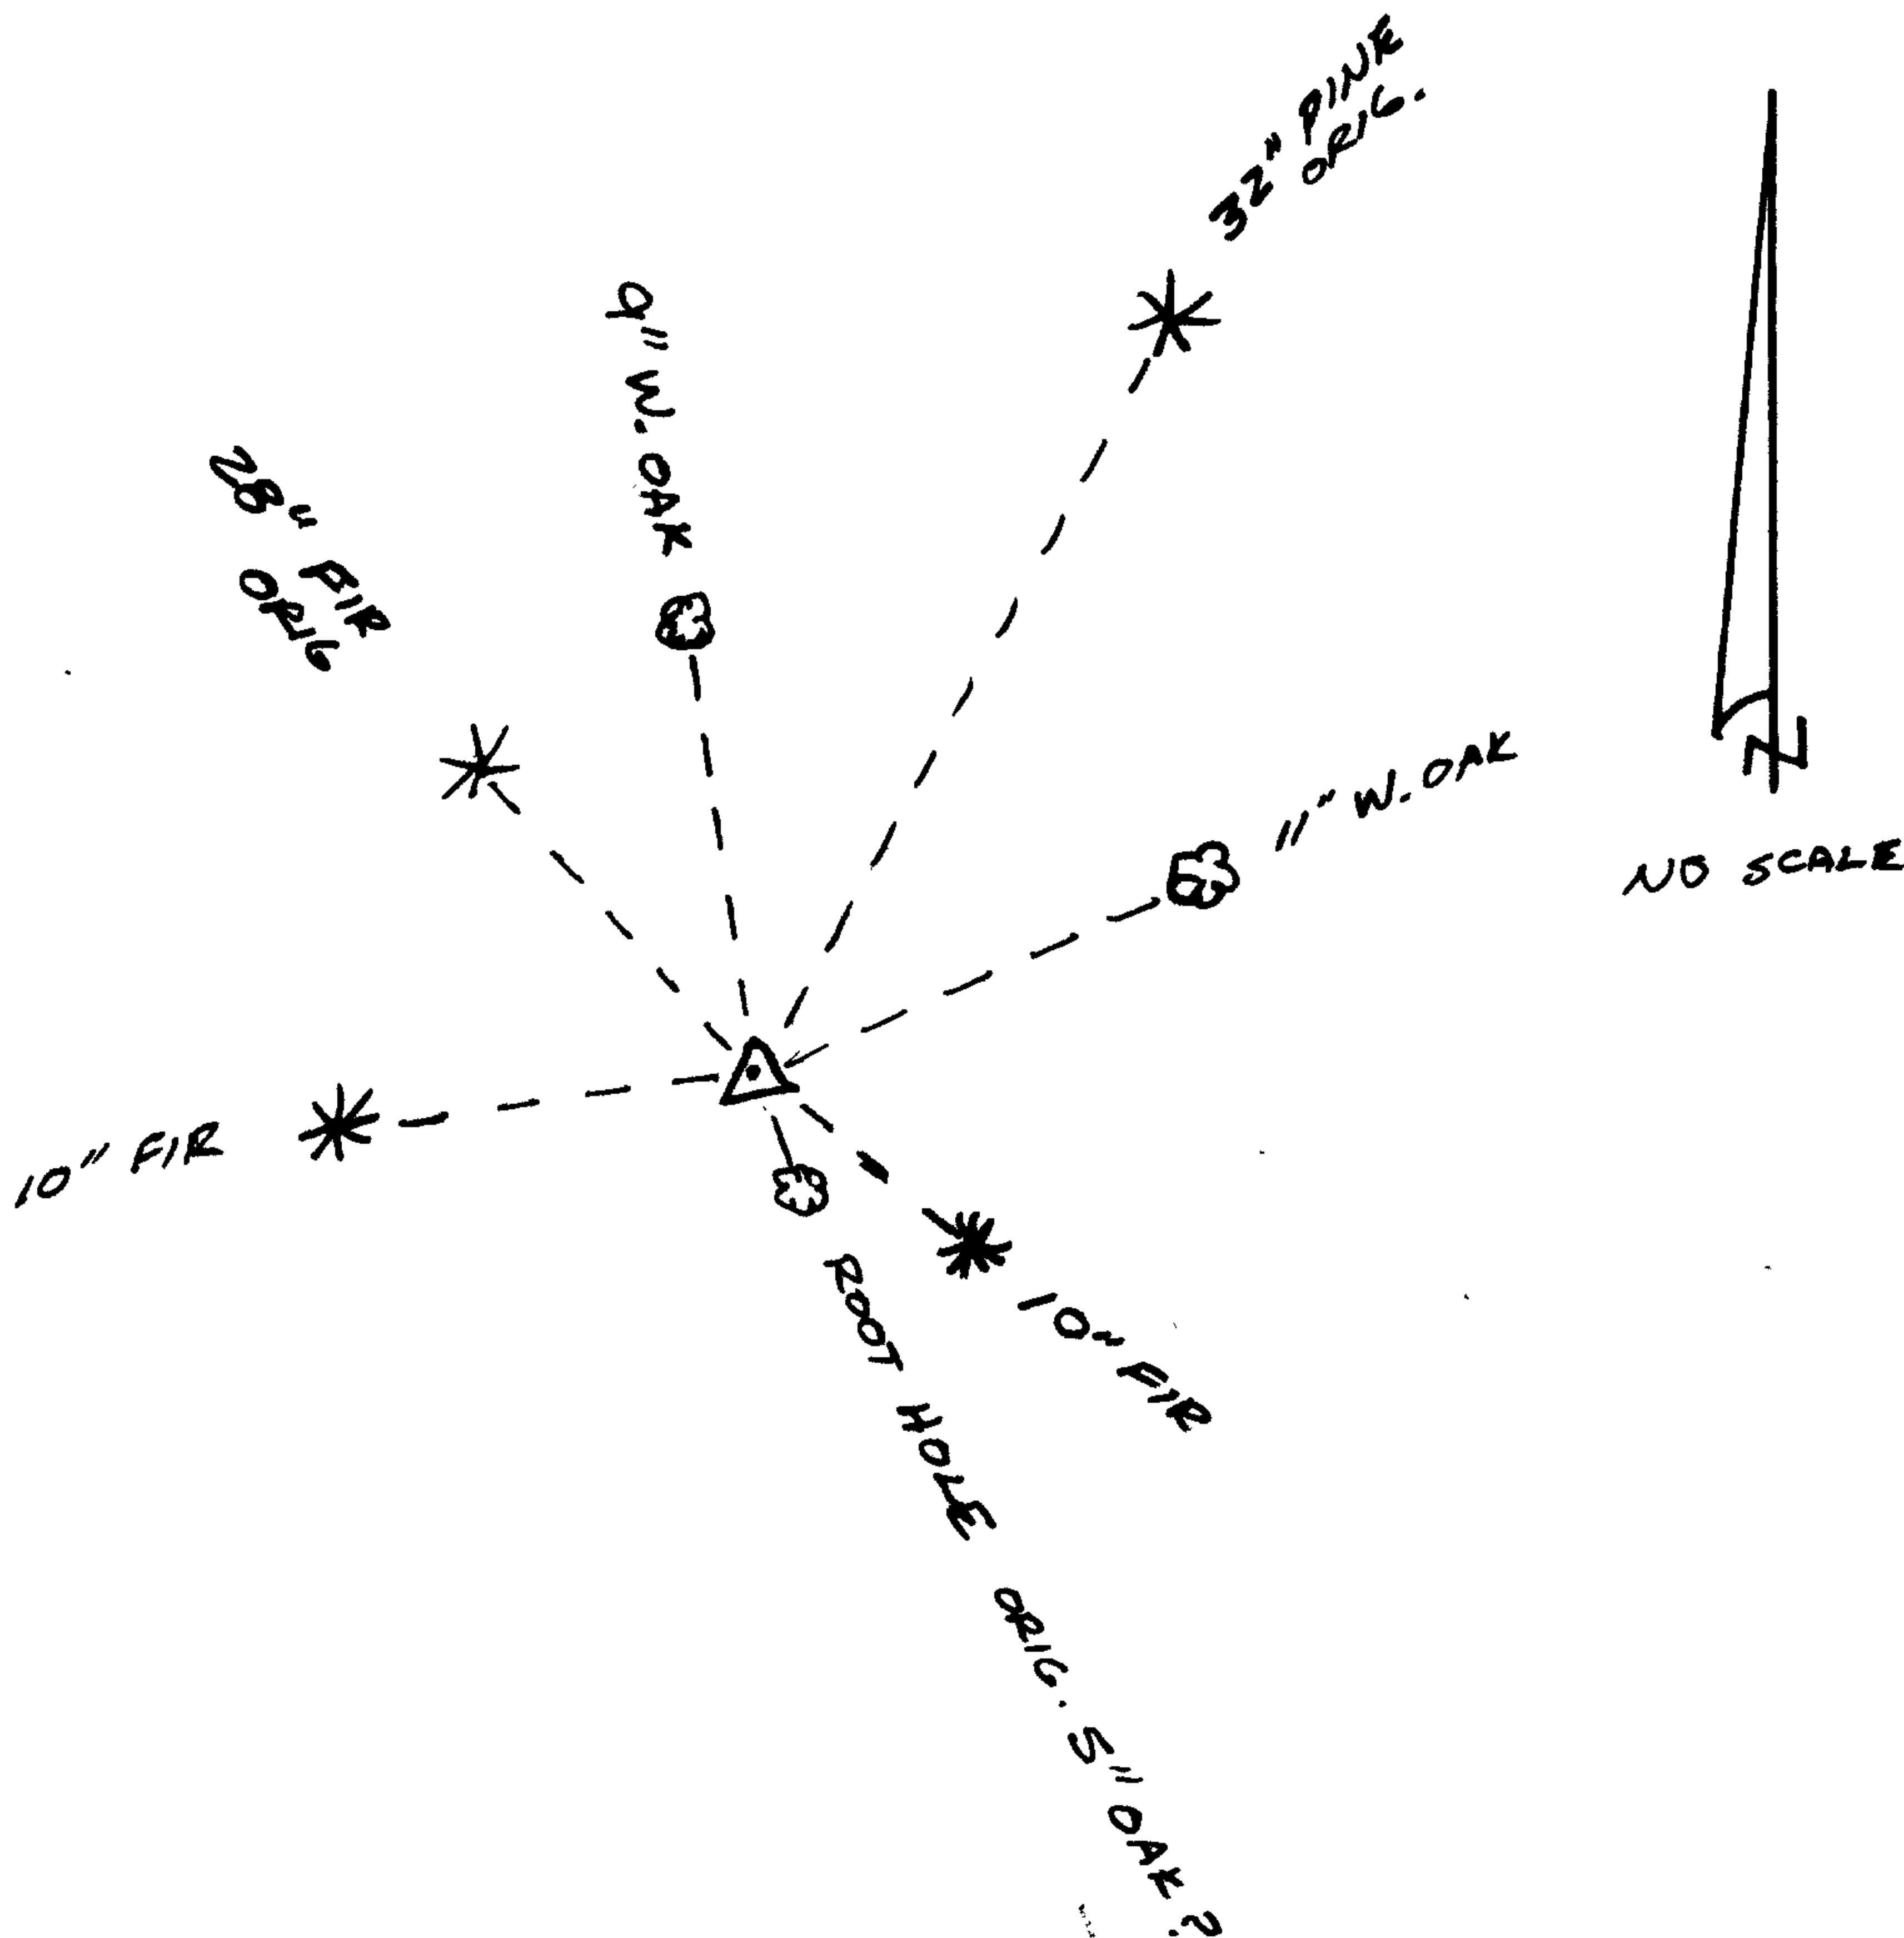

Location & Comments

BLAZE LINE RUNS NORTH FROM COR. TO ROAD 30-9-24-1

Comp. Declin. 19° E  
 Agency DCSO  
 Party Chief GREGORY E. QUIBELL  
 Notekeeper Gregory E. Quibell  
 Witnesses JOHN POWELL  
RANDY SMITH

Surveyor's Seal

REGISTERED  
PROFESSIONAL  
LAND SURVEYOR

*Gregory E. Quibell*

OREGON  
JULY 13, 1979  
GREGORY E. QUIBELL  
1834