

GOVERNMENT CORNER RESTORATION FORM

Township 25S Range 5W Sec. 3 County Douglas

State OR Date 12-23-82 No. _____

Corner Designation

SW
DIC
16

- _____ Condition Report Only
- _____ Not Found
- Renewed
- _____ Unrecorded
- _____ Surveyed In
- _____ Referenced Out..

Previous Renewals 190

Monument(s) Found: (Condition and Source)

MONUMENT DETAIL

Ed. 7/8" Iron Rod set by
Victor M. Melind at the point
he determined to be SW DIC 16.

Per map (M46-11)

Accessories Found:

Per Map (M93-31)

7/8" Iron Rod with plastic cap S 1/2 E 176 2 ; Thence
N 89 E 372 2 to a 7/8" Iron Rod with plastic cap.

#141 X

RENEWAL

Monument Set (Procedure and Description)

Set 1" x 30" IRON PIPE WITH BRASS CAP
 ON THE Easterly side of 5/8" IRON ROD, set
 by Victor Melind per map (M 96-11)

I determined that this was correct
 5/8" IRON ROD by using (map M 93-31)

I checked bearings + dist. from the
 SW D.C. 46 cor to a 5/8" IRON ROD with
 plastic cap S 1/2 E 176.8, Thence
 N 89 E 372.9 to a 5/8" IRON ROD with plastic cap


Monument Detail

Douglas County Surveyors
 T25S R5W
 S.W.
 D.C.
 46
 1982

New Accessories

COPCO Power Pole # 5544 560W 45

Sketch of Monument, Accessories, and General Area

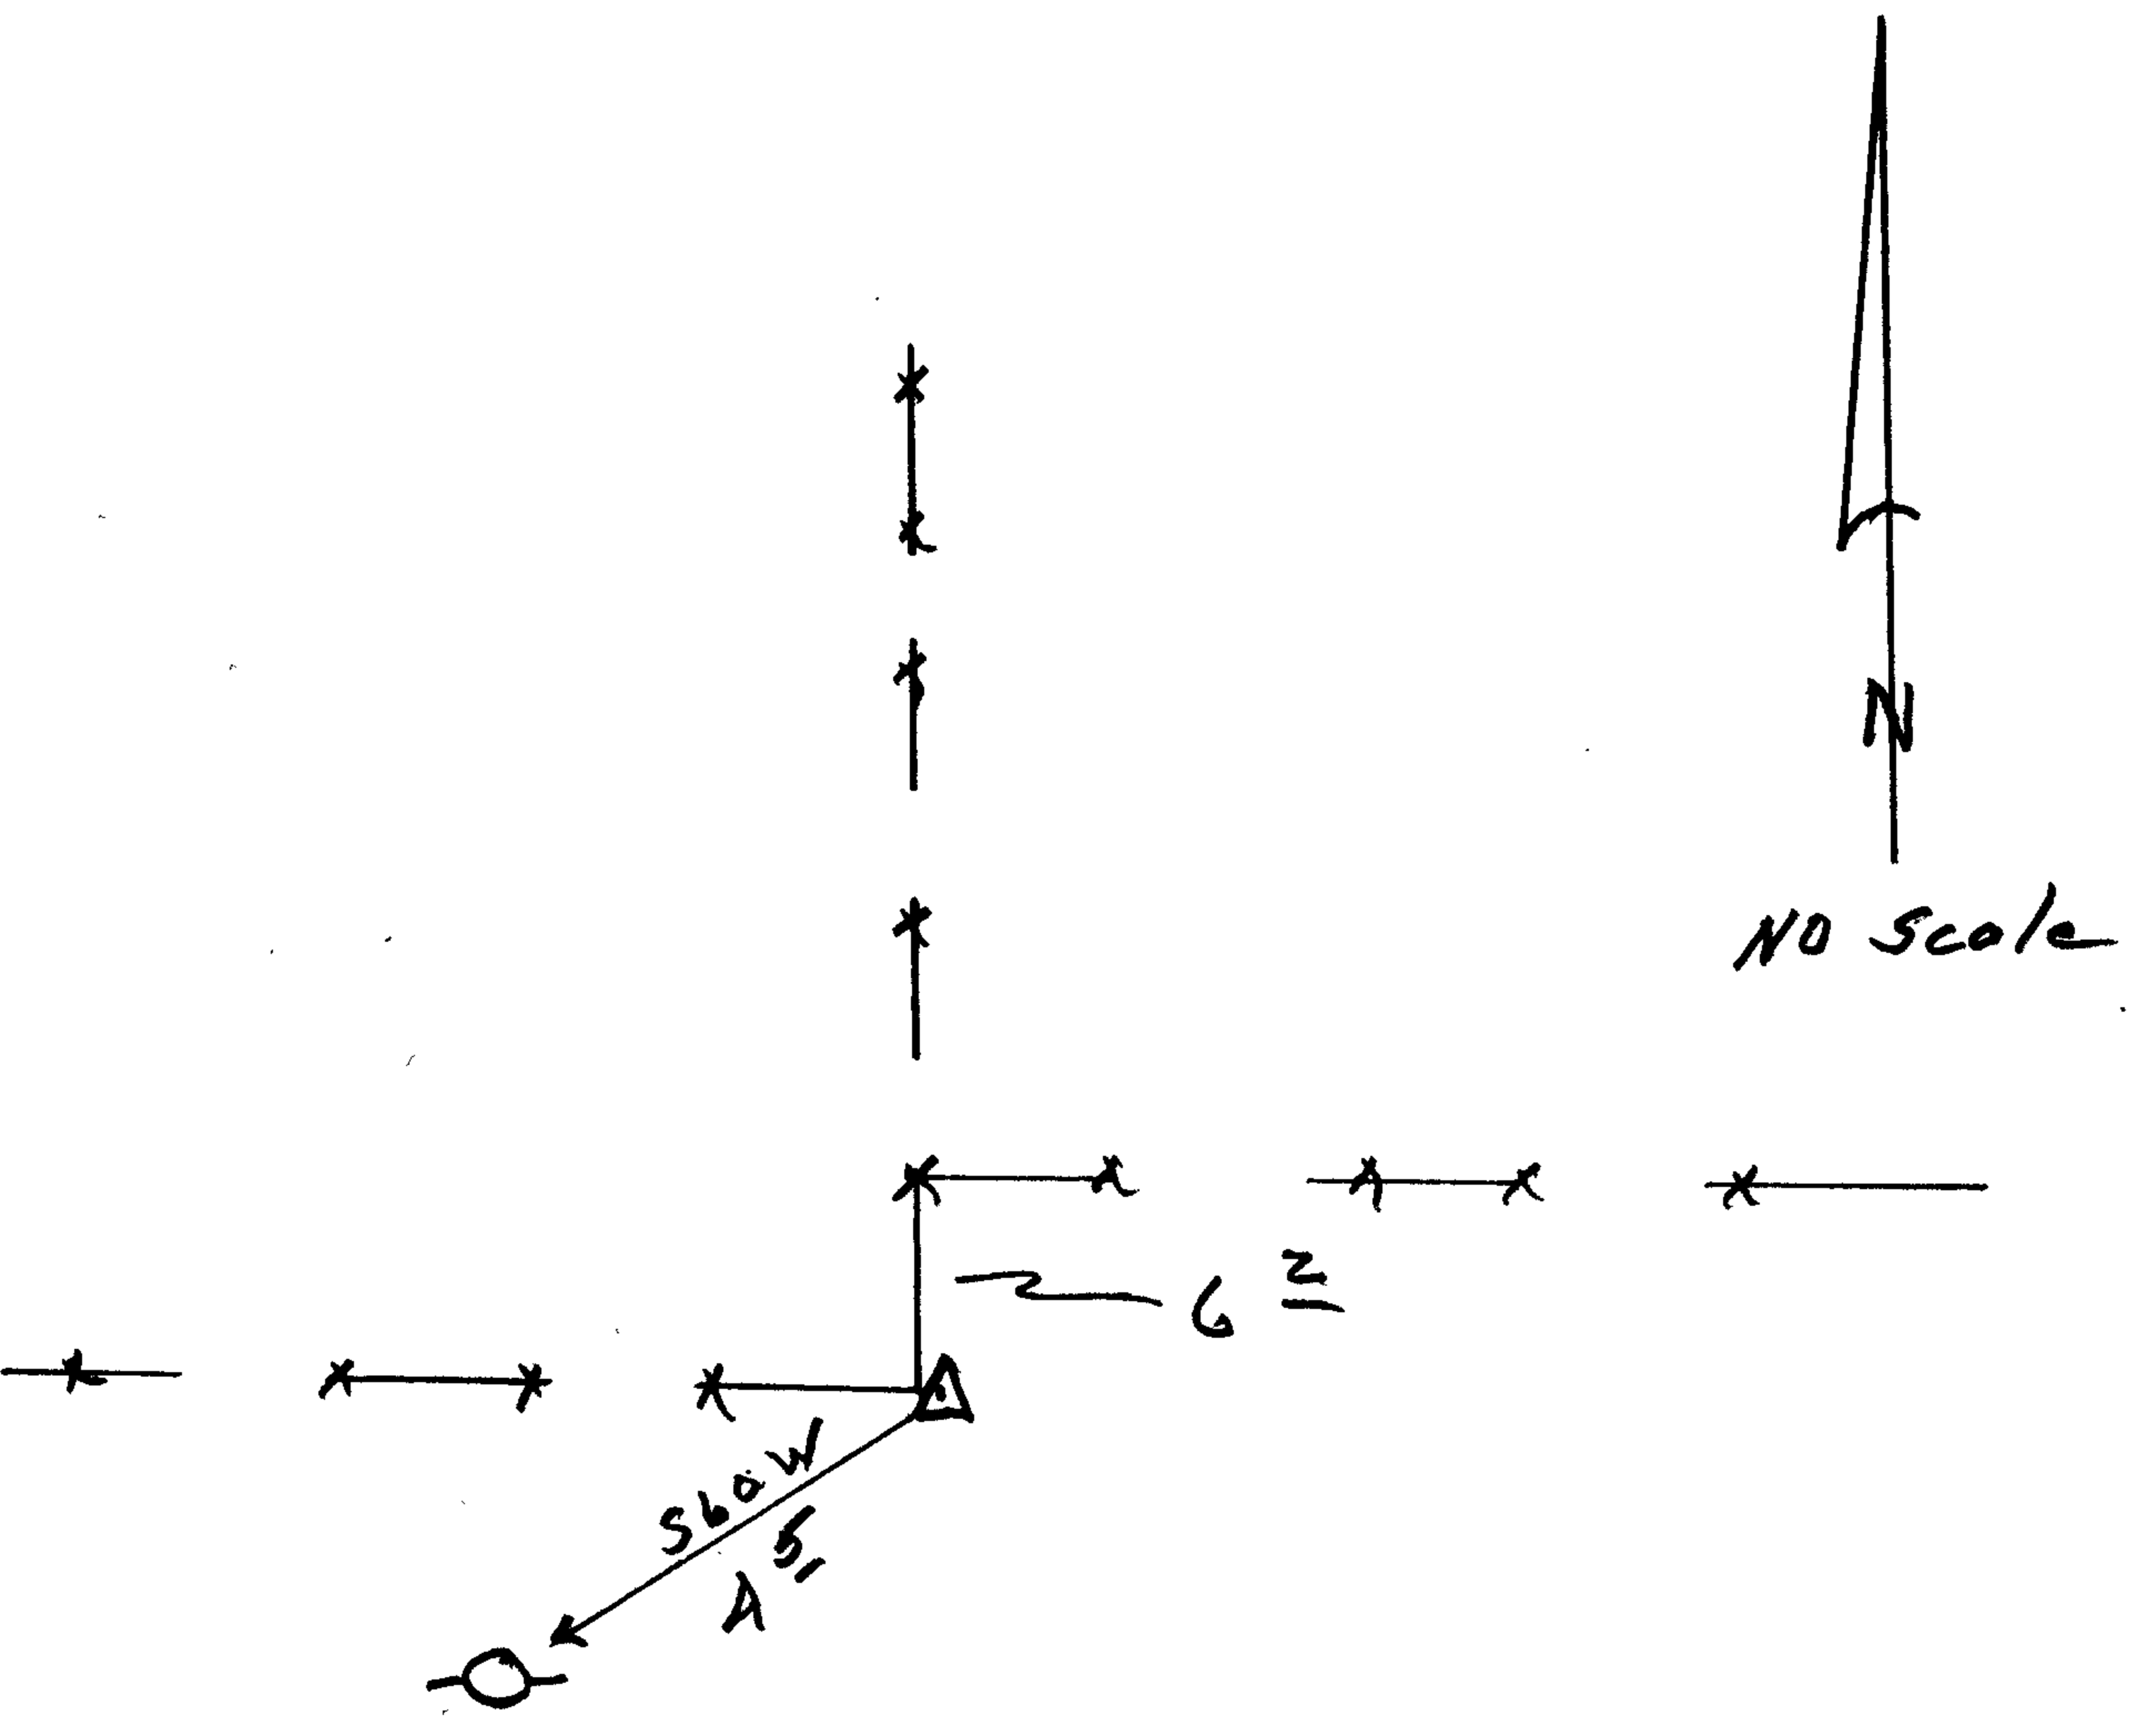

Location & Comments

This cor. lies on Top
 belt spur approx 850 FT
 southerly from Co. Rd # 22
 17 fence cor.

Comp. Declin. 19° E
 Agency PUSD
 Party Chief P
 Notekeeper P
 Witnesses P.S.

Surveyor's Seal


REGISTERED
 PROFESSIONAL
 LAND SURVEYOR

Larry E. Monrean

OREGON
 JULY 13, 1979
 LARRY E. MONREAN
 #1830

M 93-31

~~Q~~ $\frac{1}{2}$ E 176.8

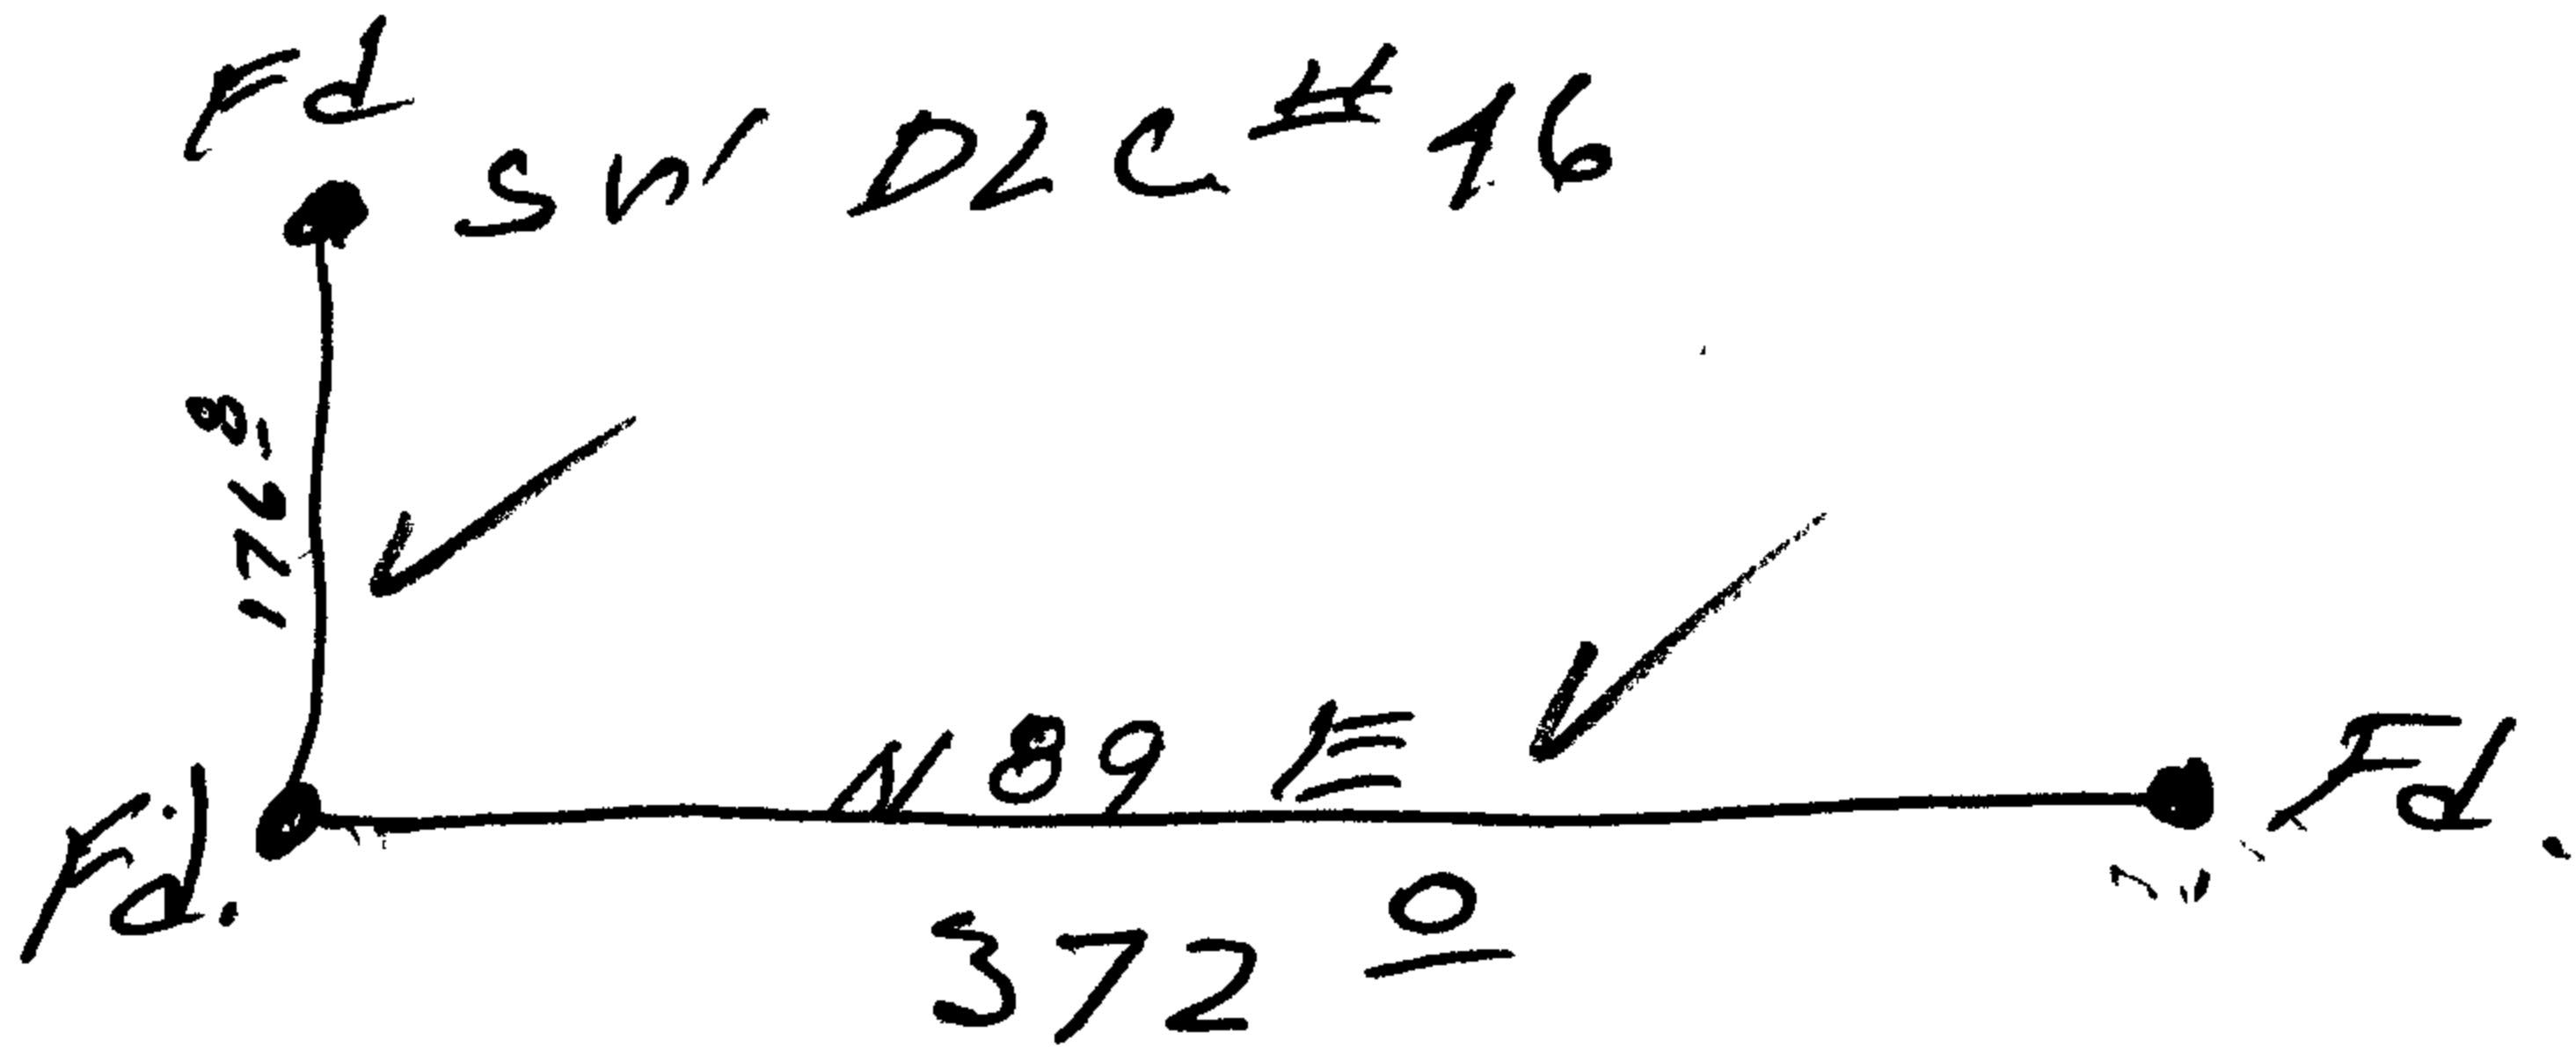

[Handwritten signature]

File No. 62/1-39