

GOVERNMENT CORNER RESTORATION FORM

Township 32S Range 6W Sec. 30 County DOUGLAS

State OR Date 12-30-82 No. \_\_\_\_\_

Corner Designation

T 32S R 6W  
CS  
1/16 | S 30

- Condition Report Only
- Not Found
- Renewed
- Unrecorded
- Surveyed In
- Referenced Out

Previous Renewals M 39-23

Monument(s) Found: (Condition and Source)

PER M 39-23

FD 1" x 30" IPA WITH BRASS CAP  
ATTACHED, BENT UP & LYING OUT  
OF POSITION DUE TO CAT WORK.

MONUMENT DETAIL

SURVEYORS  
T 32S R 6W  
COUNTY OFFICE  
CS 1/16 | S 30

1970

Accessories Found:

13" NOW 14" CEDAR PER M 39-23 WITH SCRIBED "CS 1/16 S 30 CS BT"  
IN PARTIALLY HEALED DOUBLE BLAZE.

10" NOW 12" MADRONE PER M 39-23 WITH WELL HEALED  
DOUBLE BLAZE.

#162 ✓

GLENN 62/1-40 C

RENEWAL

Monument Set (Procedure and Description)

Monument Detail

I RESET FD. BRASS CAP USING REG. BEARINGS & DISTANCES FROM BOTH FD. BT'S. AS FOLLOWS:

14" CEDAR BEARS S 51° E 72.5 FT.

12" MADRONE BEARS N 68° W 34.8 FT


I ADD MARKS "RESET 1982" TO BRASS CAP.

SURVEYORS  
COUNTY T32S R6W  
CS 1/16 | S30  
OFFICE  
RESET  
1982  
1970

New Accessories

Sketch of Monument, Accessories, and General Area

Location & Comments

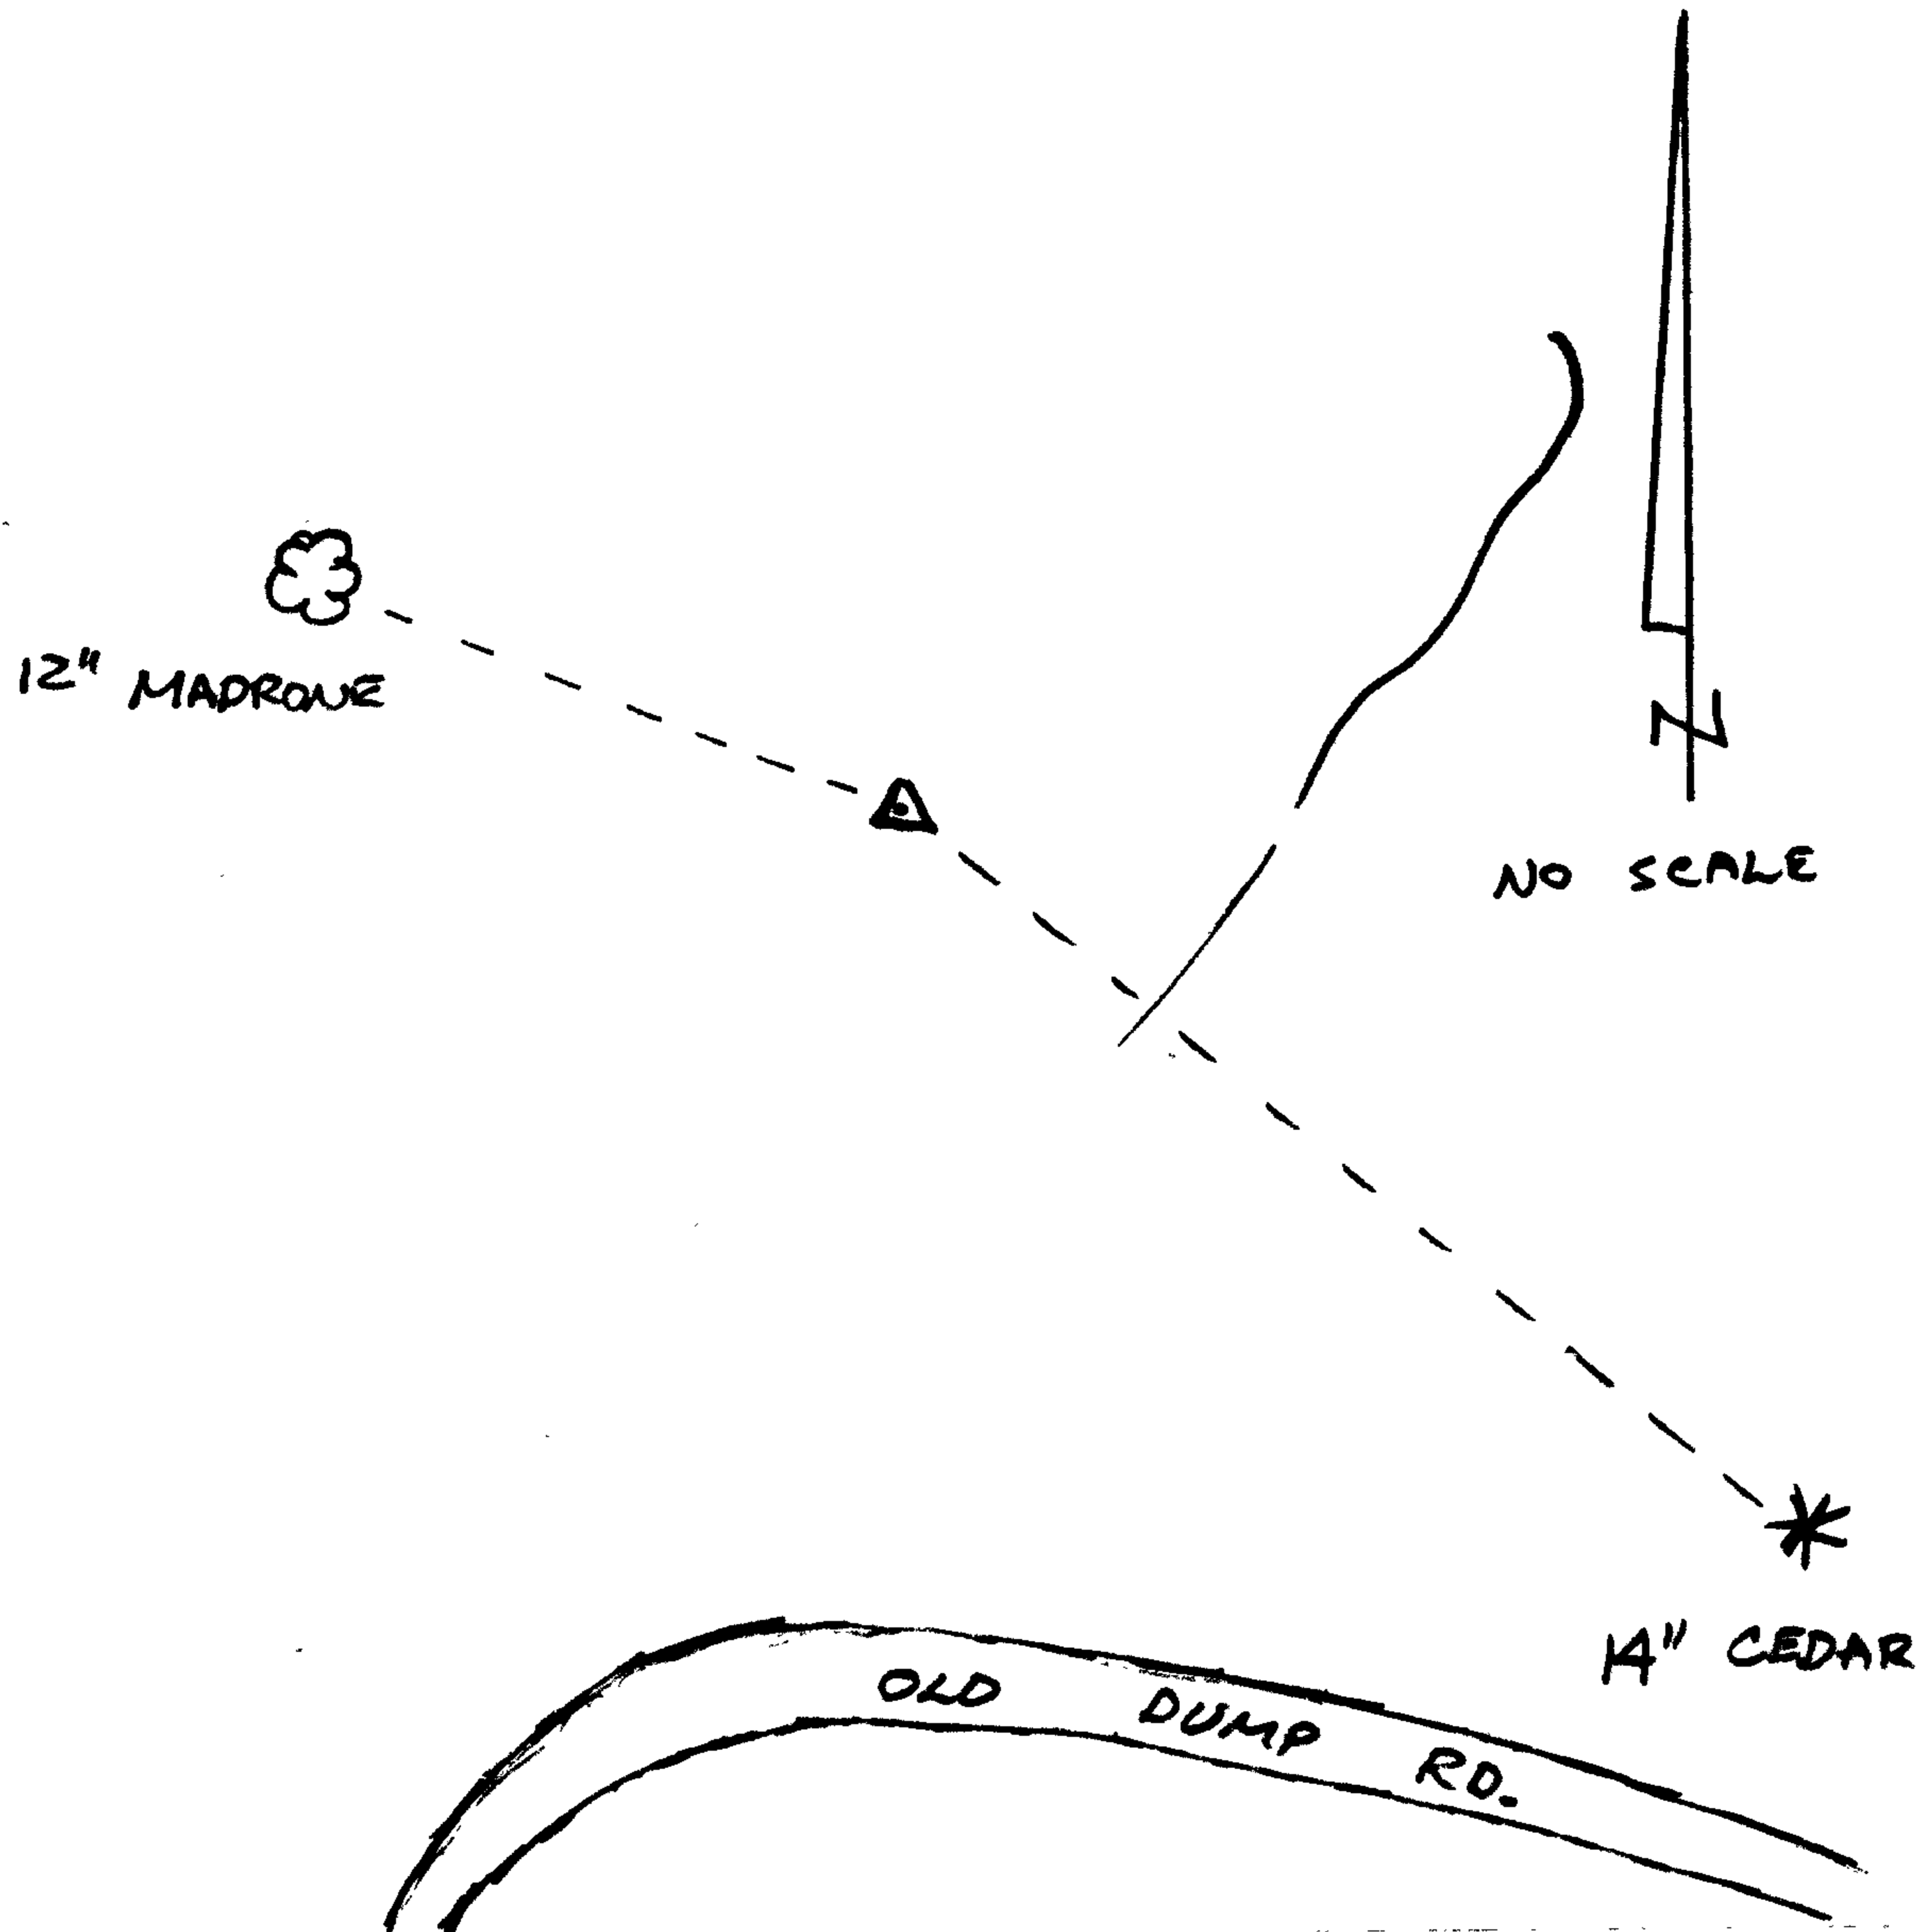

DCSO BT TAGS ON BOTH BT'S

Comp. Declin. 19° E  
Agency DCSO  
Party Chief GREGORY E. QUIBELL  
Notekeeper Gregory E. Quibell  
Witnesses JOHN POWELL  
RANDY SMITH

Surveyor's Seal  
REGISTERED PROFESSIONAL LAND SURVEYOR  
Gregory E. Quibell  
OREGON  
JULY 13, 1979  
GREGORY E. QUIBELL  
1834