




FROM BYRONS COR.

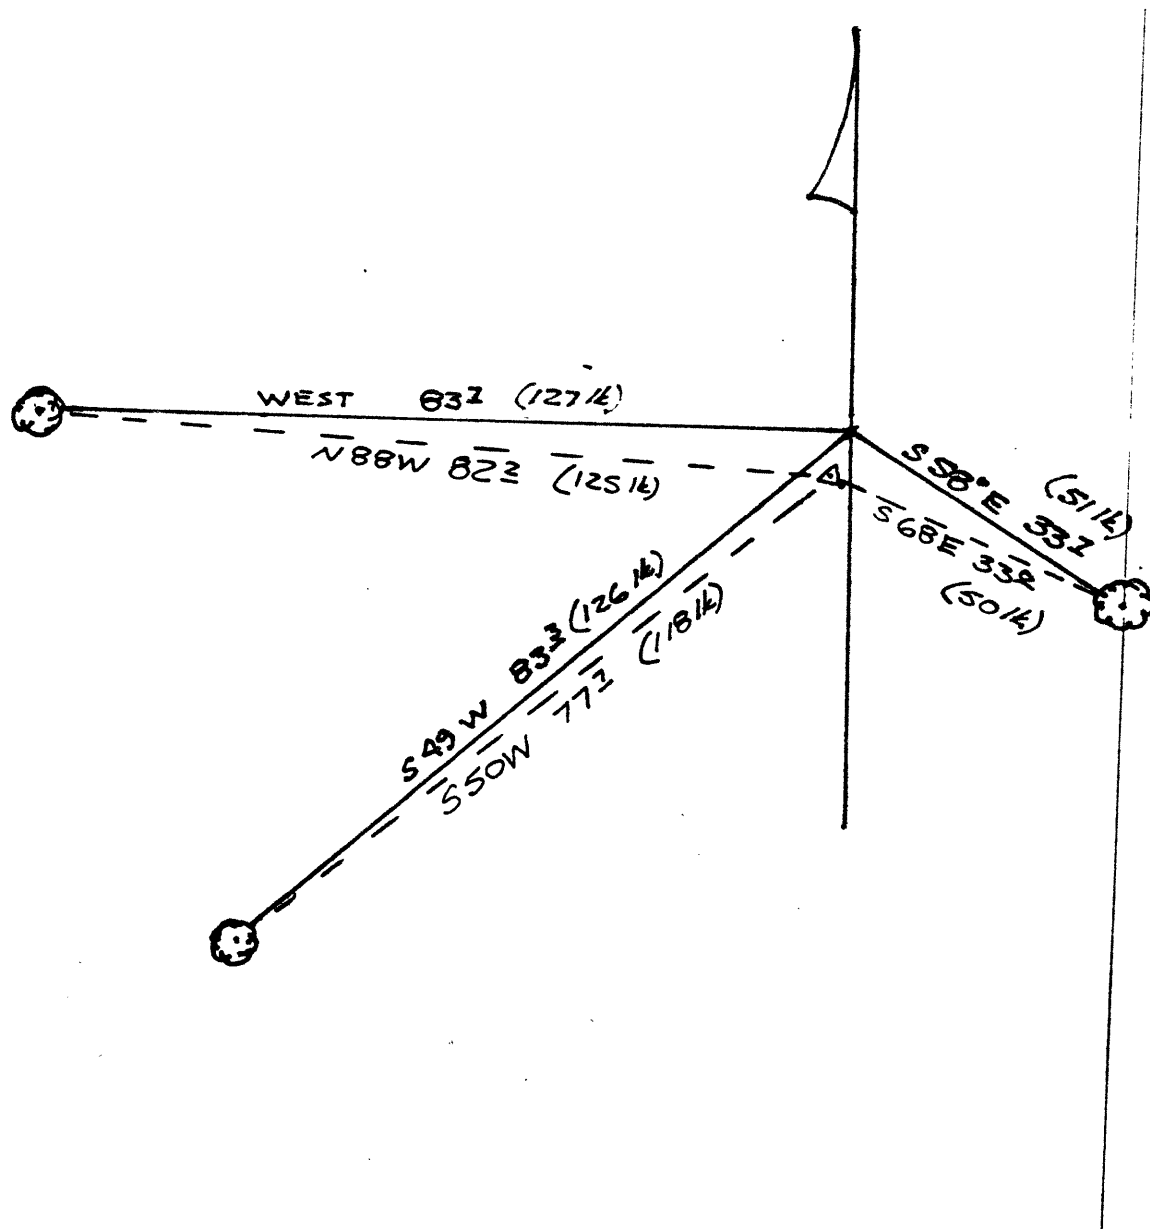

53 DIA

ORIG.

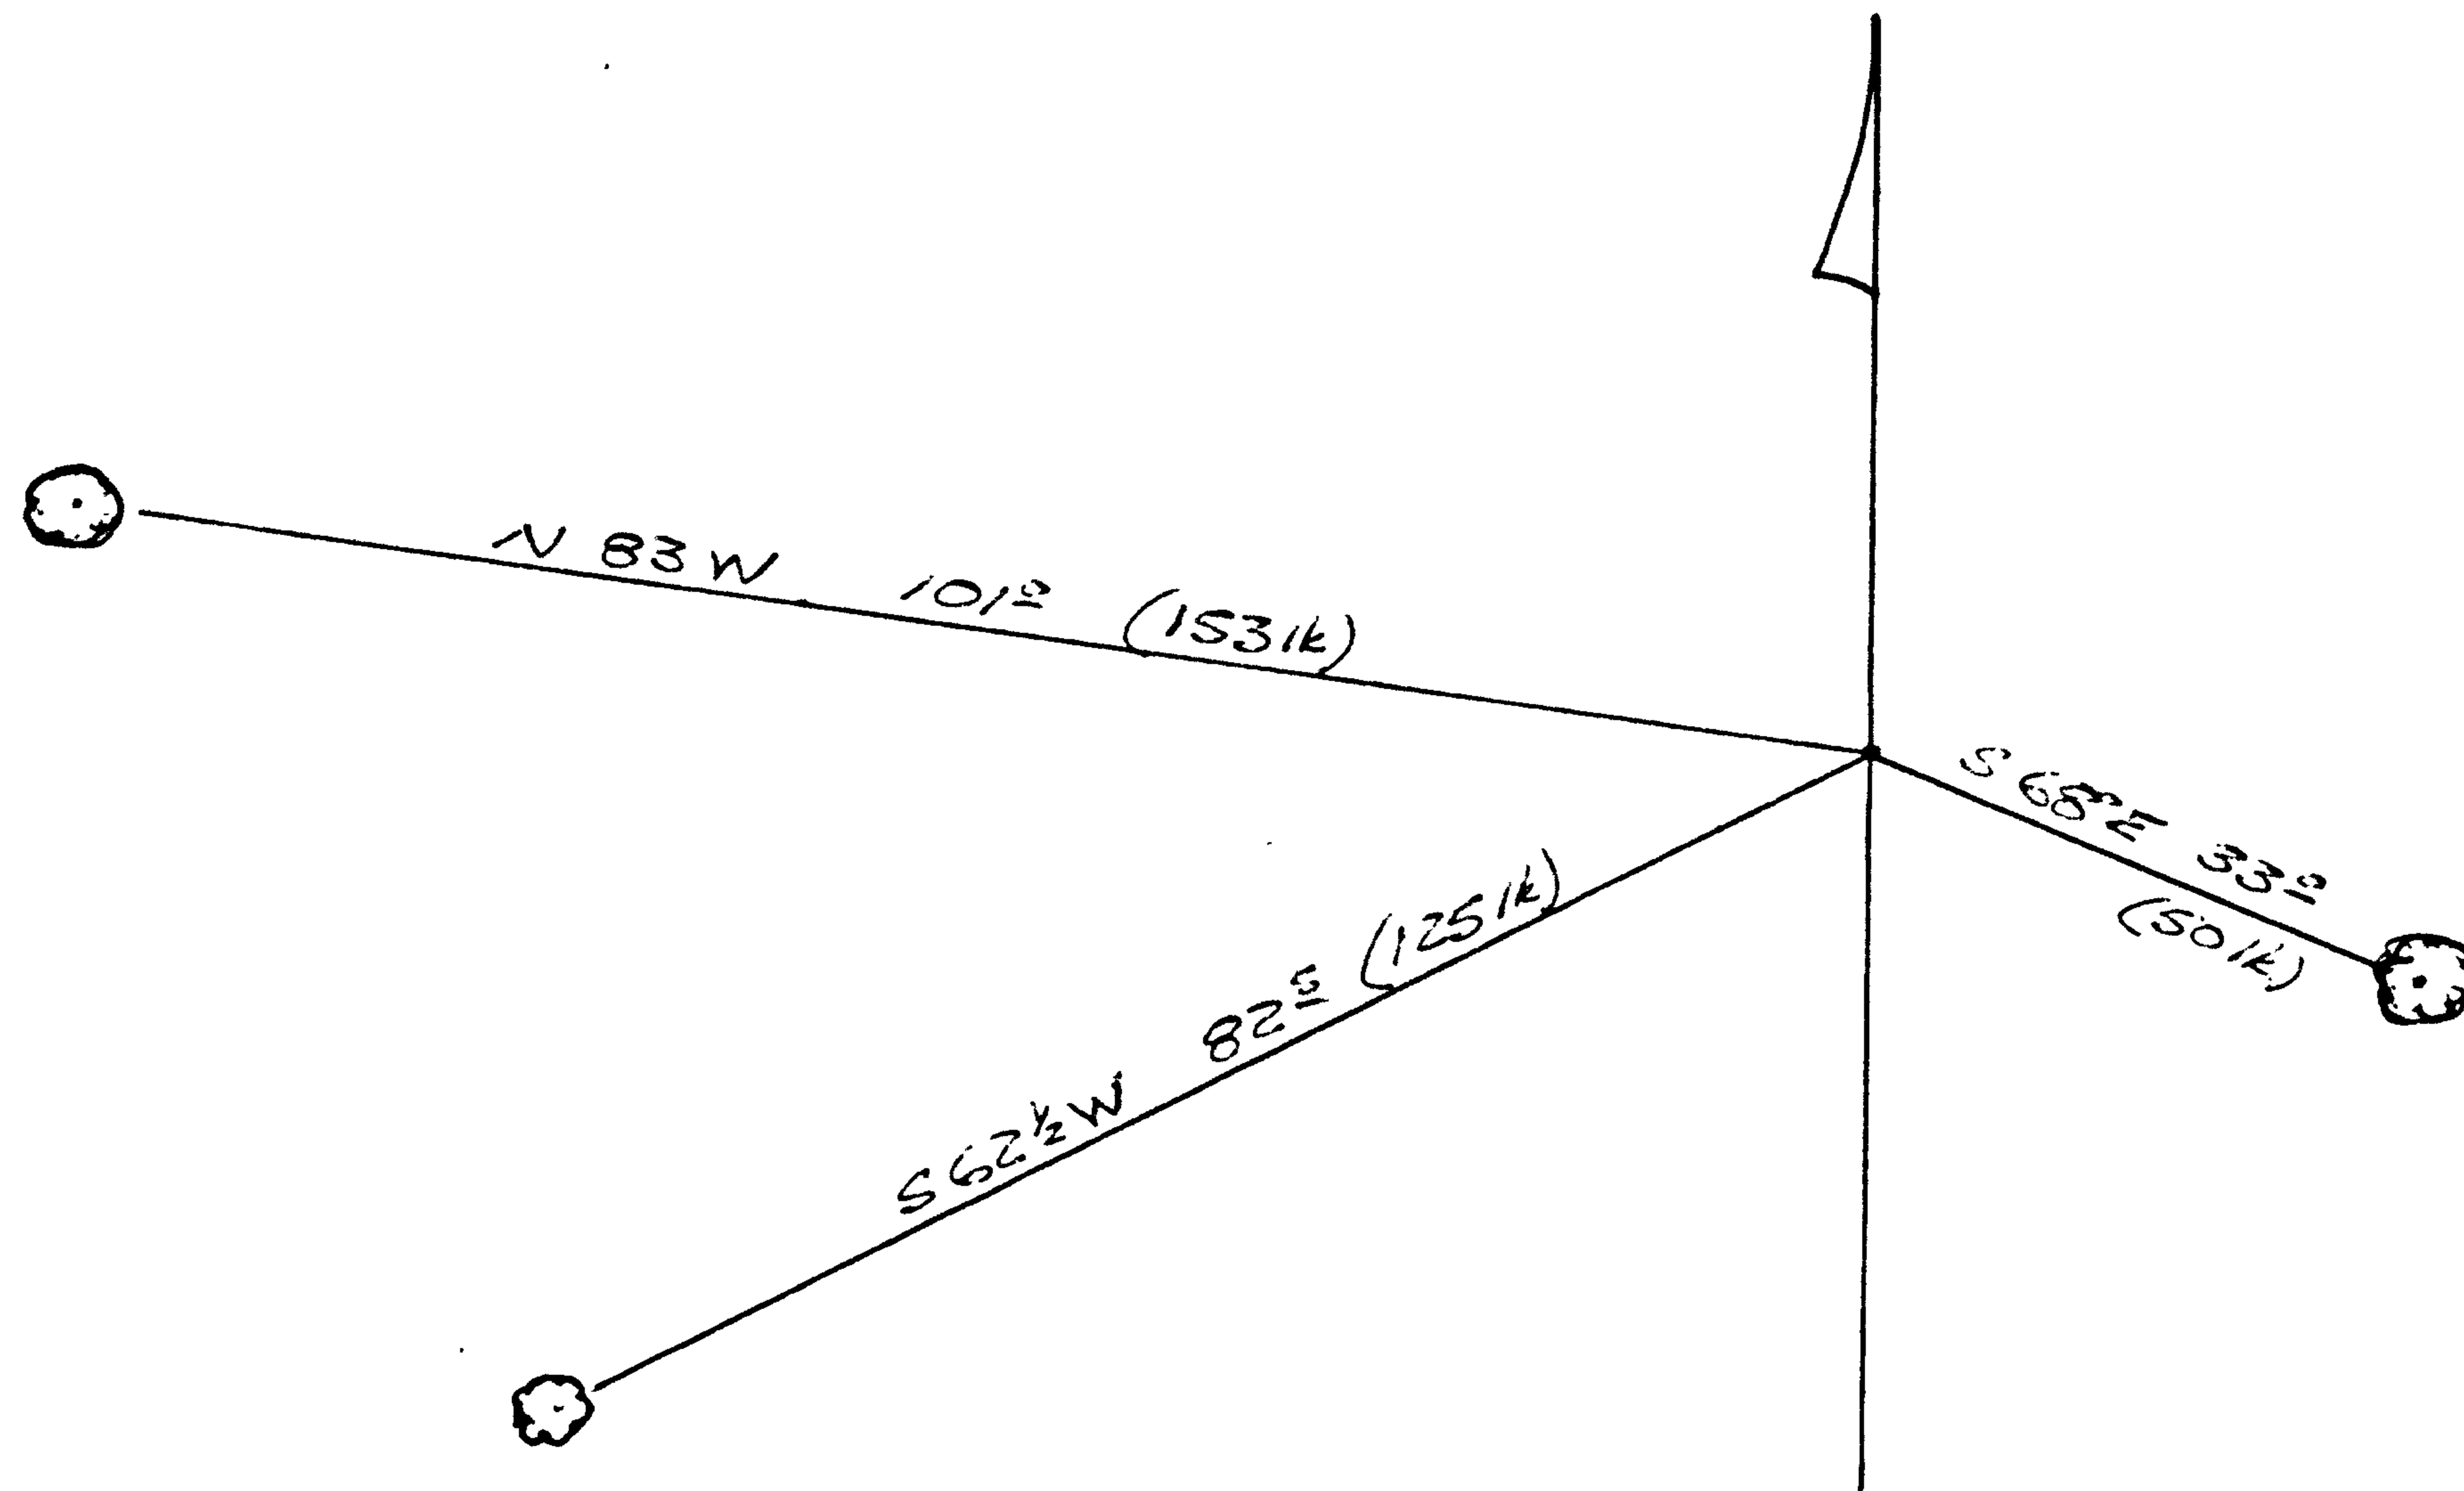

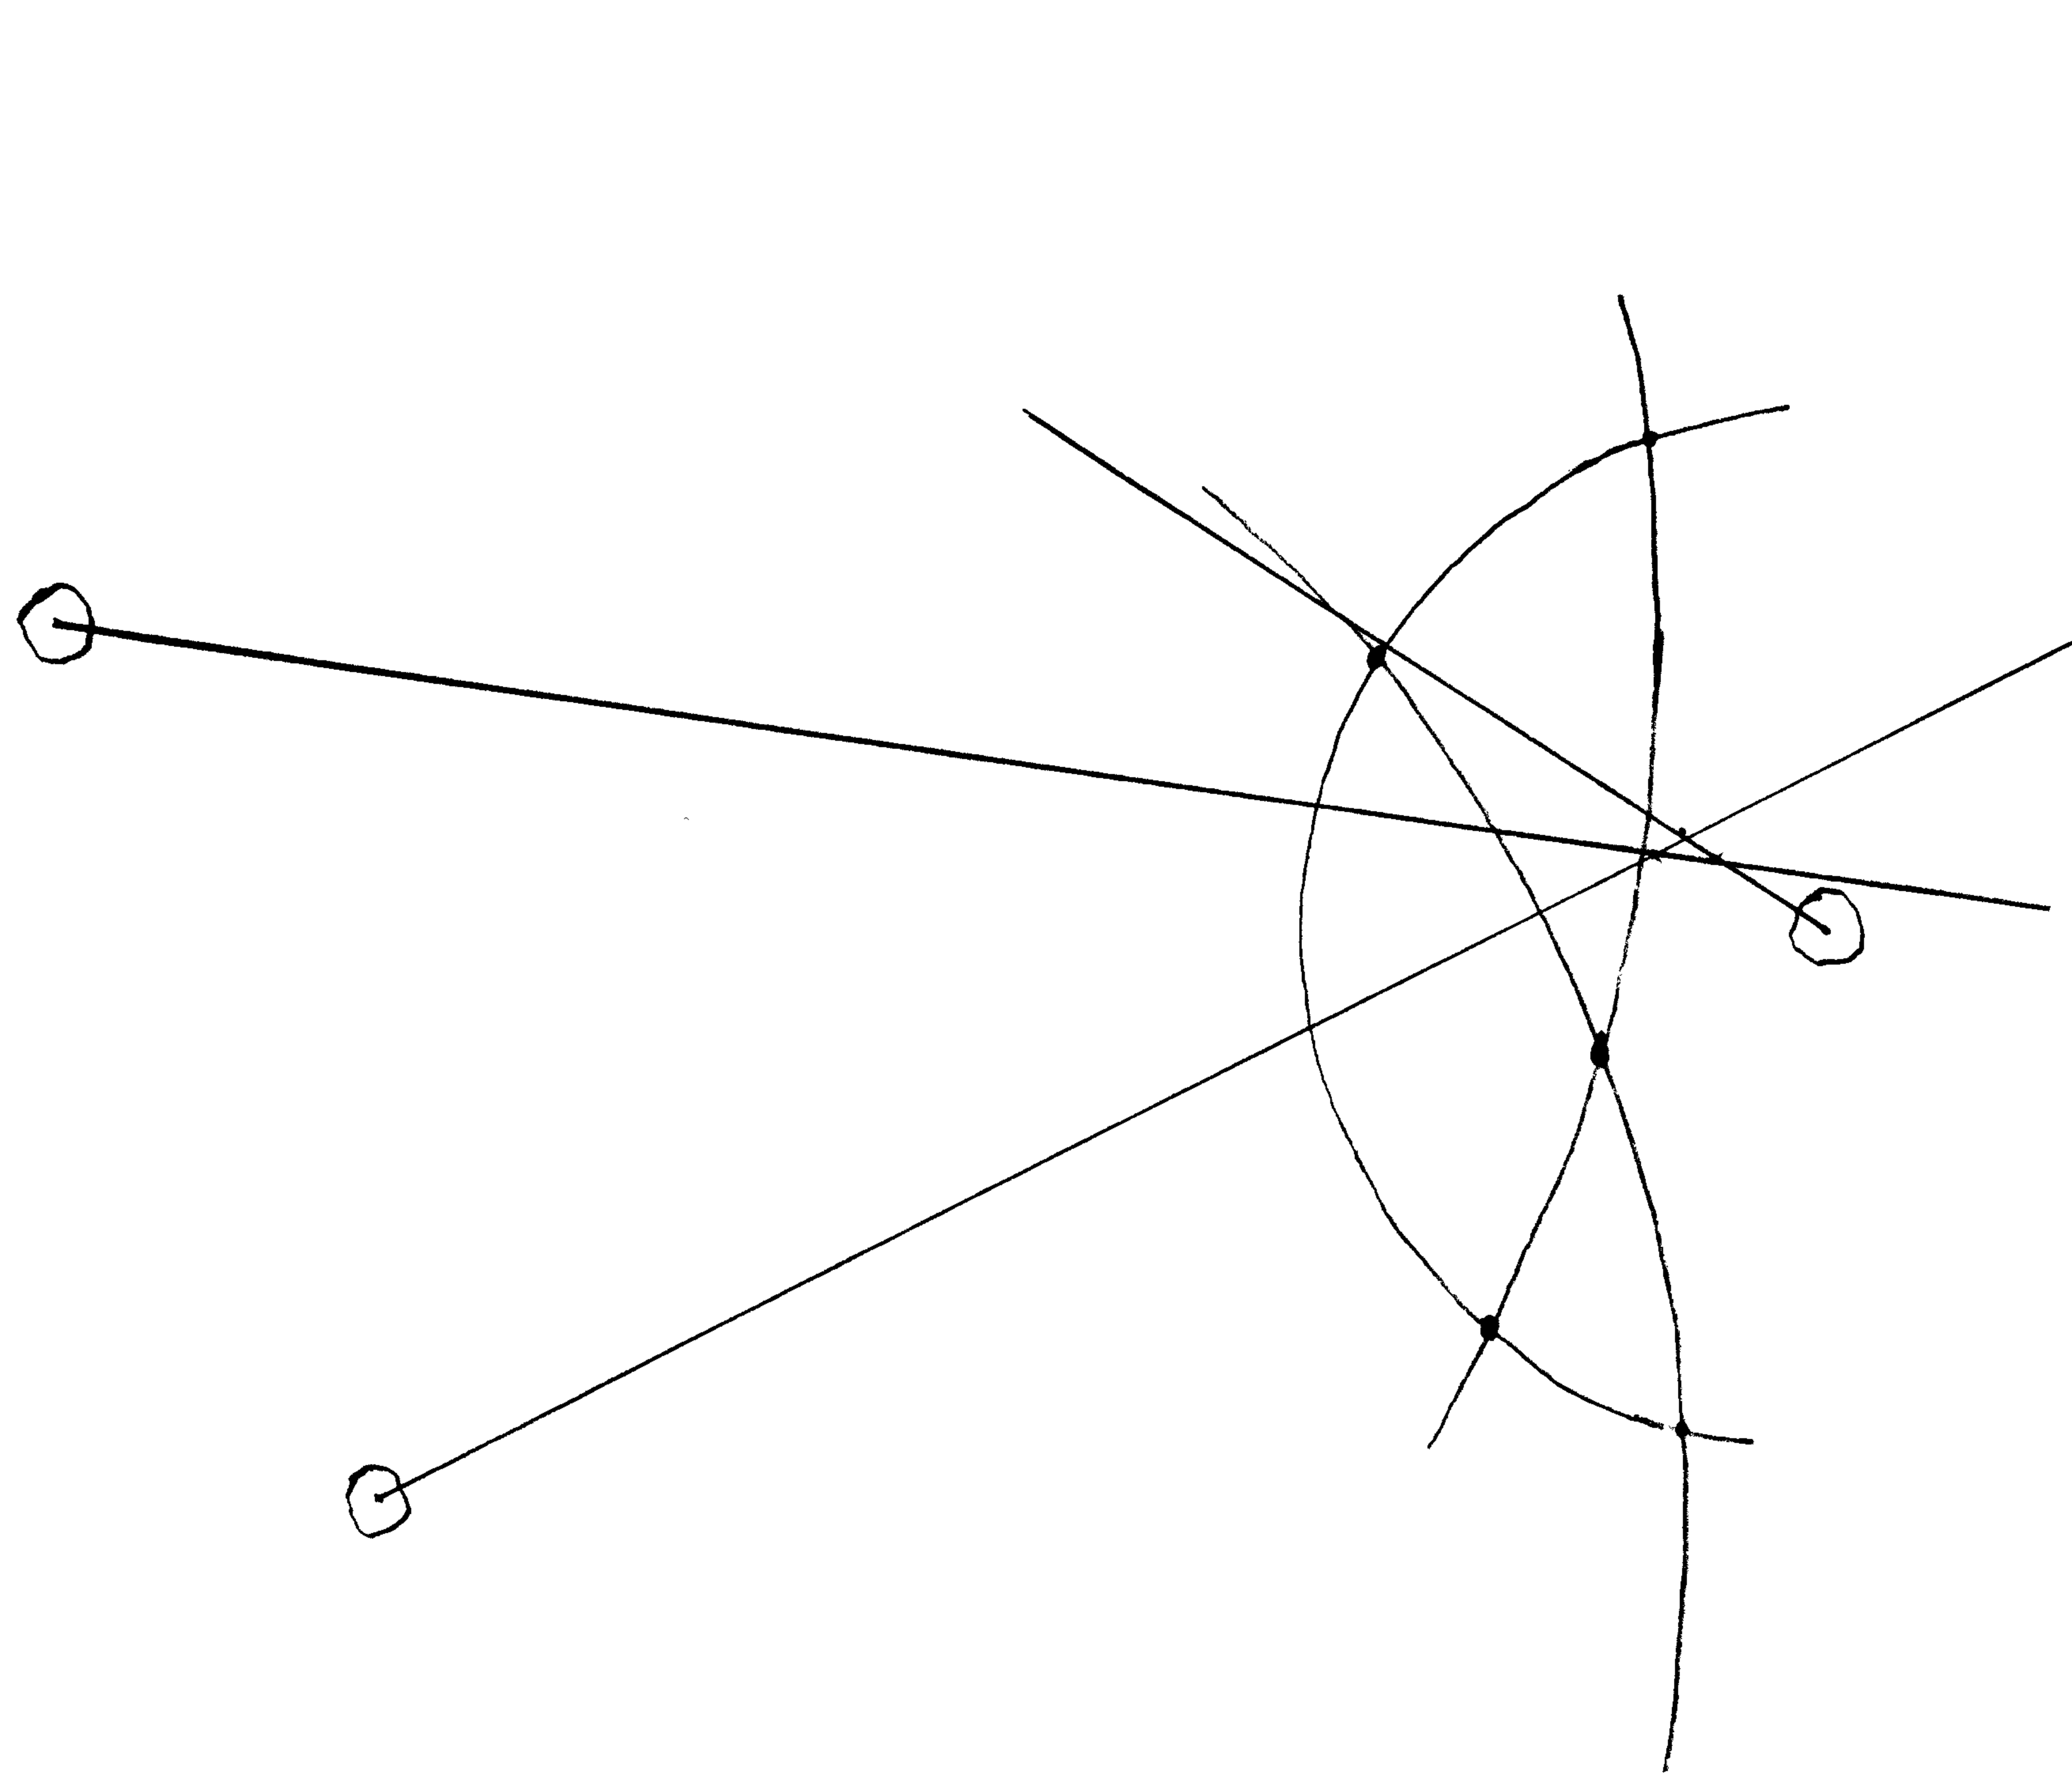

C. S. File No. 62/1-42