

RENEWAL

Monument Set (Procedure and Description)


Monument Detail

SINCE THIS AREA IS TO BE LOGGED SOON I DO NOT SET NEW MONUMENT BUT DO LEAVE FD. 3/4" IR PER REN. # SB IN PLACE.

New Accessories

SET SPIKE IN CENTER OF ORIG 48" NOW 52" FIR STUMP, MARKED "B01" BEARS N66°W 22.9 FT.

Sketch of Monument, Accessories, and General Area

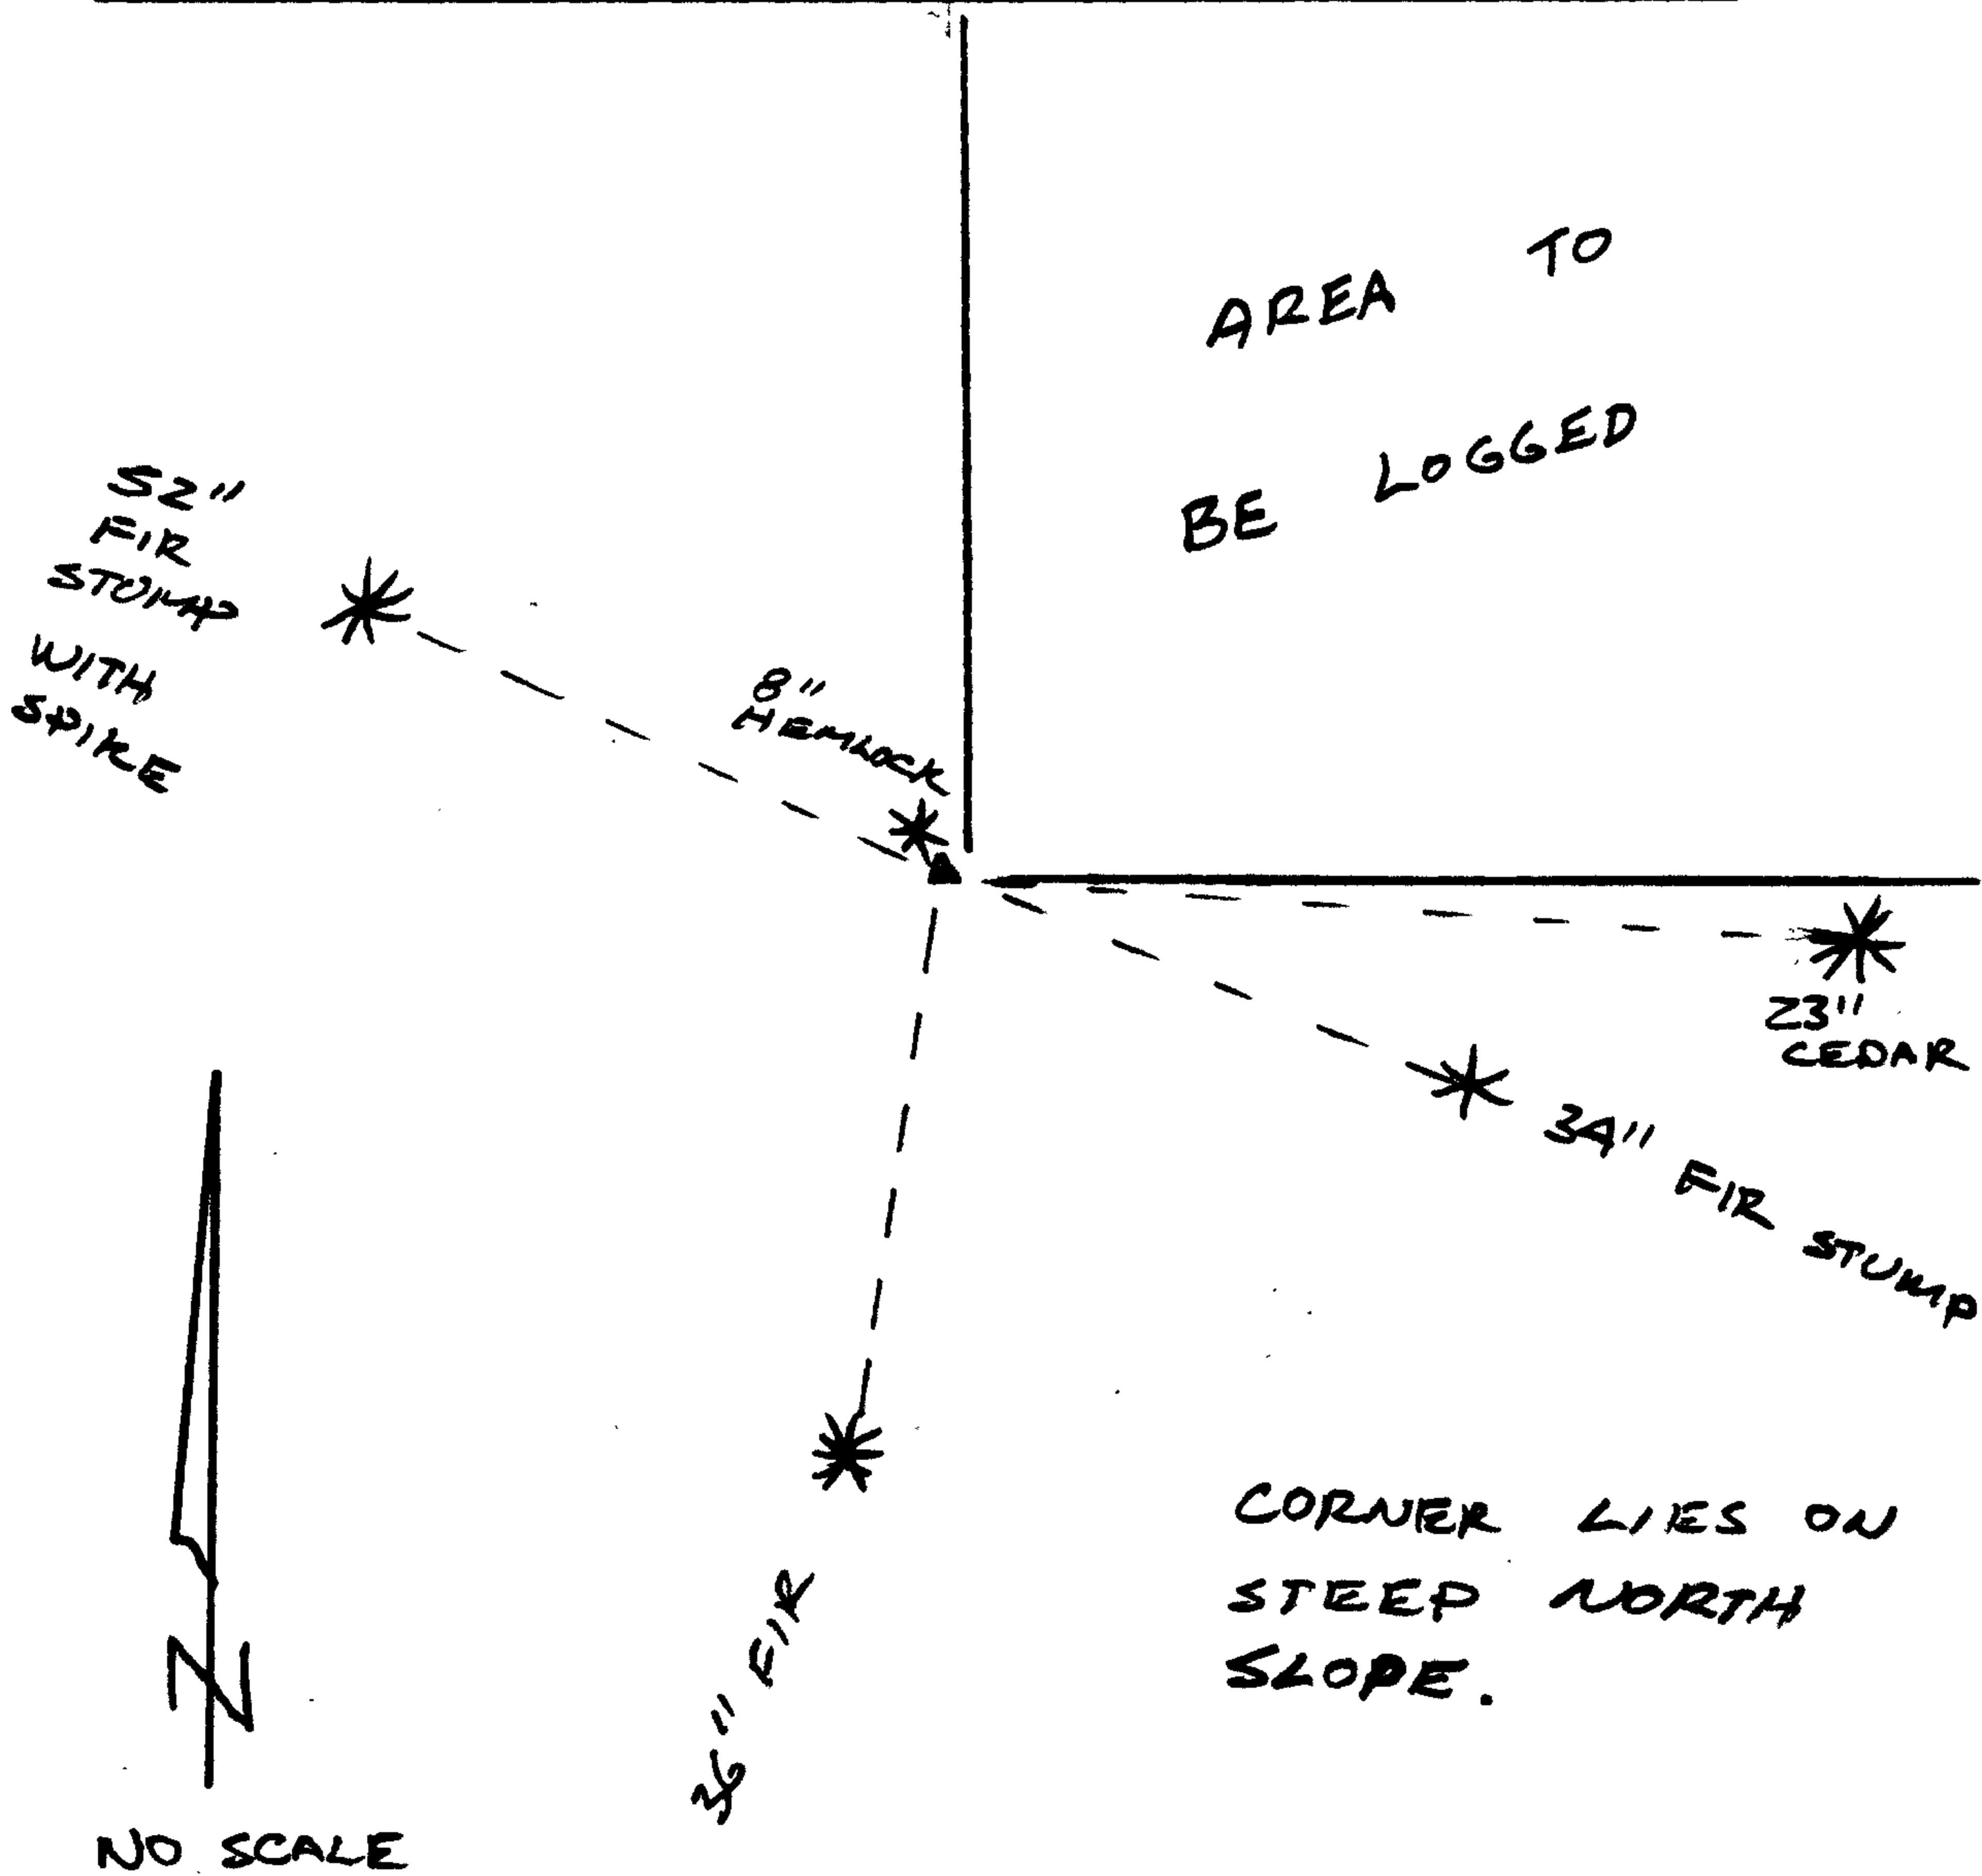

Location & Comments

BEARING TREES ARE OUTSIDE OF CLEAR CUT BOUNDARY SIGNS THEREFORE MOST ACCESSORIES SHOULD BE UNTOUCHED BY LOGGING. I DOUBLE TAGGED ALL BT'S FOR BETTER VISIBILITY.

Comp. Declin. 19° E
 Agency DCSO
 Party Chief GREGORY E. QUIRELL
 Notekeeper " " "
 Witnesses JOHN POWELL

Surveyor's Seal

REGISTERED
 PROFESSIONAL
 LAND SURVEYOR

Gregory E. Quirell

OREGON
 JULY 13, 1979
 GREGORY E. QUIRELL
 1834

NO SCALE