



RENEWAL

Monument Set (Procedure and Description)

Monument Detail

I "X" OUT THE 6 THAT WAS IMPROPERLY STAMPED IN "S 26" PER REN. # 92 AND STAMP 9 ALONGSIDE


SURVEYORS  
COUNTY T31S R6W OFFICE  
1/4 S 24  
S 32  
1966

New Accessories

SET SPIKE MARKED "BO 1" IN TOP OF 36" CEDAR STUMP BEARS N 52° E 34 1/2 FT. TO SPIKE.

SET SPIKE MARKED "BO 2" IN TOP OF 39" FIR STUMP USED FOR TAIL HOLD IN RECENT LOGGING, BEARS S 6 1/2 E 40° TO SPIKE.

Sketch of Monument, Accessories, and General Area

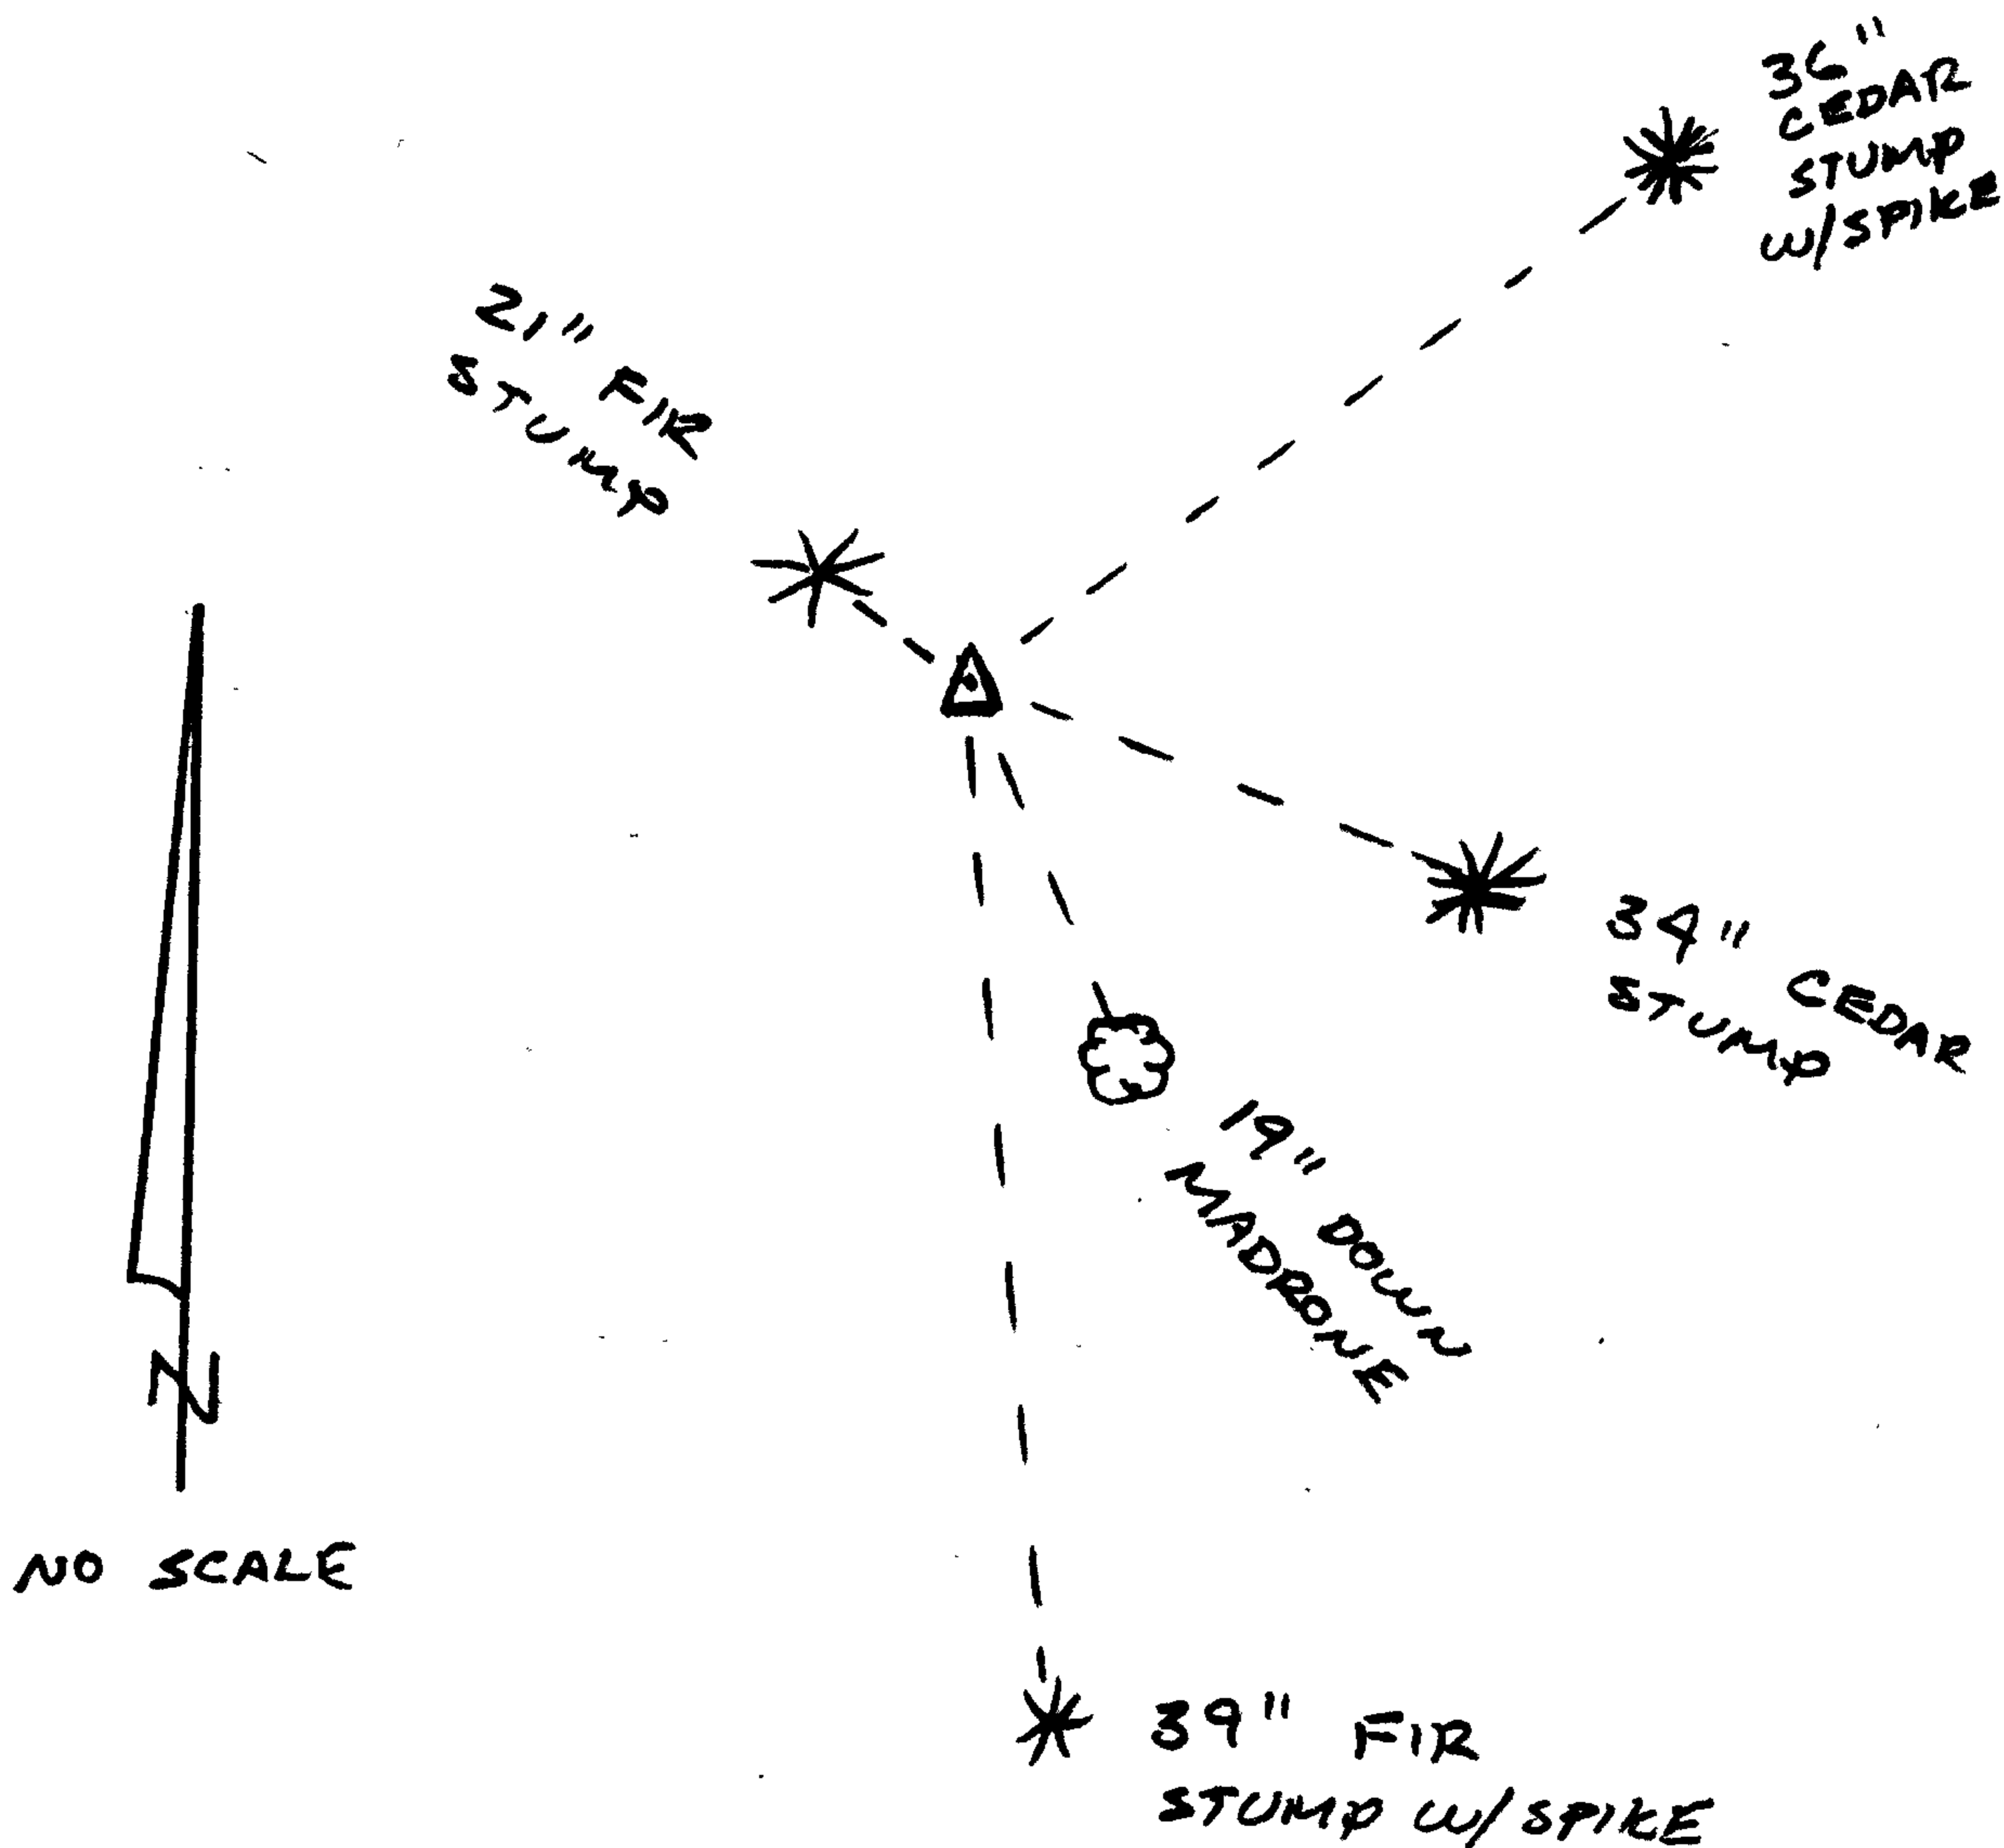

Location & Comments

CORNER LIES ON RIDGE TOP RUNNING N 18° E APPROX. 200' NORTH OF ROAD WHICH GOES TO LANDING

Comp. Declin. 19° E  
Agency DCSO  
Party Chief GREGORY E. QUIBELL  
Notekeeper " " "  
Witnesses JOHN POWELL

*of jfm*

Surveyor's Seal

REGISTERED  
PROFESSIONAL  
LAND SURVEYOR

*Gregory E. Quibell*

OREGON  
JULY 13, 1979  
GREGORY E. QUIBELL  
1834