

GOVERNMENT CORNER RESTORATION FORM

Township 32 S Range 4 W Sec. 5 County DOUGLAS

State OR Date 1-12-83 No. _____

Corner Designation

T 32 S R 4 W

$\frac{1}{4}$ S 6 | 55

- Condition Report Only
- Not Found
- Renewed
- Unrecorded
- Surveyed In
- Referenced Out

Previous Renewals #13, 1959 RESURVEY, #140

Monument(s) Found: (Condition and Source)

FD. 5/8" IR WITH ALUM. CAP PER
REN. #140. MONUMENT IS
LOCATED IN DITCH ON NORTH
SIDE OF COW CR. ROAD.

DOUGLAS
T 32 S R 4 W CO.

$\frac{1}{4}$ S 6 | 55

1979

SURVEYOR

Accessories Found:

FD. 30" FIR STUMP PER REN. #13 WITH SCRIBED "1/4"
VISIBLE BEARS S 15° E 46² FT.

FD. 36" FIR PER REN. #13, NOW 60" STUMP WITH NO FACE
VISIBLE BEARS S 47 W 114² FT.

FD. 6" MADRONE PER RESURVEY, NOW 14" WITH GOOD SCAR
ON MOST SOUTHERLY TRUNK OF A TRIPLE TRUNK TREE
BEARS N 18° E 66² FT. (REC. N 22° E)

FD. 10" MADRONE PER RESURVEY, NOW 22" NO GOOD BLAZE VISIBLE
BEARS S 25 W 54¹ FT.

FD. 5/8" IR SET FLUSH WITH THE GROUND, BEARS N 45° W
30.0 FT. PER REN. #140

#146 ✓

G.S. No. 62/7-15 C

RENEWAL

Monument Set (Procedure and Description)

Monument Detail

SINCE FOUND MONUMENT IS IN A LOCATION WHERE IT IS CONTINUALLY BEING DISTURBED BY ROAD MAINTANENCE CREWS, I SET A 1"x30" IP WITH BRASS CAP ATTACHED FOR WIT. COR. I SET WIT. COR. N22° E 41' FT FROM 1/4 COR. WIT. COR. IS SET ALONG THE WESTERLY SIDE OF A NORTH-SOUTH FENCELINE.

DOUGLAS COUNTY SURVEYORS OFFICE
T32S RAW
WIT. COR.
S22W 41' TO
1/4 S6/S5

1983

New Accessories FROM WIT. COR.

14" MADRONE PER RESURVEY BEARS N 13° E 26 1/2 FT.


22" MADRONE PER RESURVEY BEARS S 24 1/2° W 99' FT.

30" FIR STUMP PER REN. #13 BEARS S 2° W 83 1/2 FT.

58" IR PER REAL #140 BEARS S 66 1/2° W 40 1/2 FT.

Sketch of Monument, Accessories, and General Area

Location & Comments

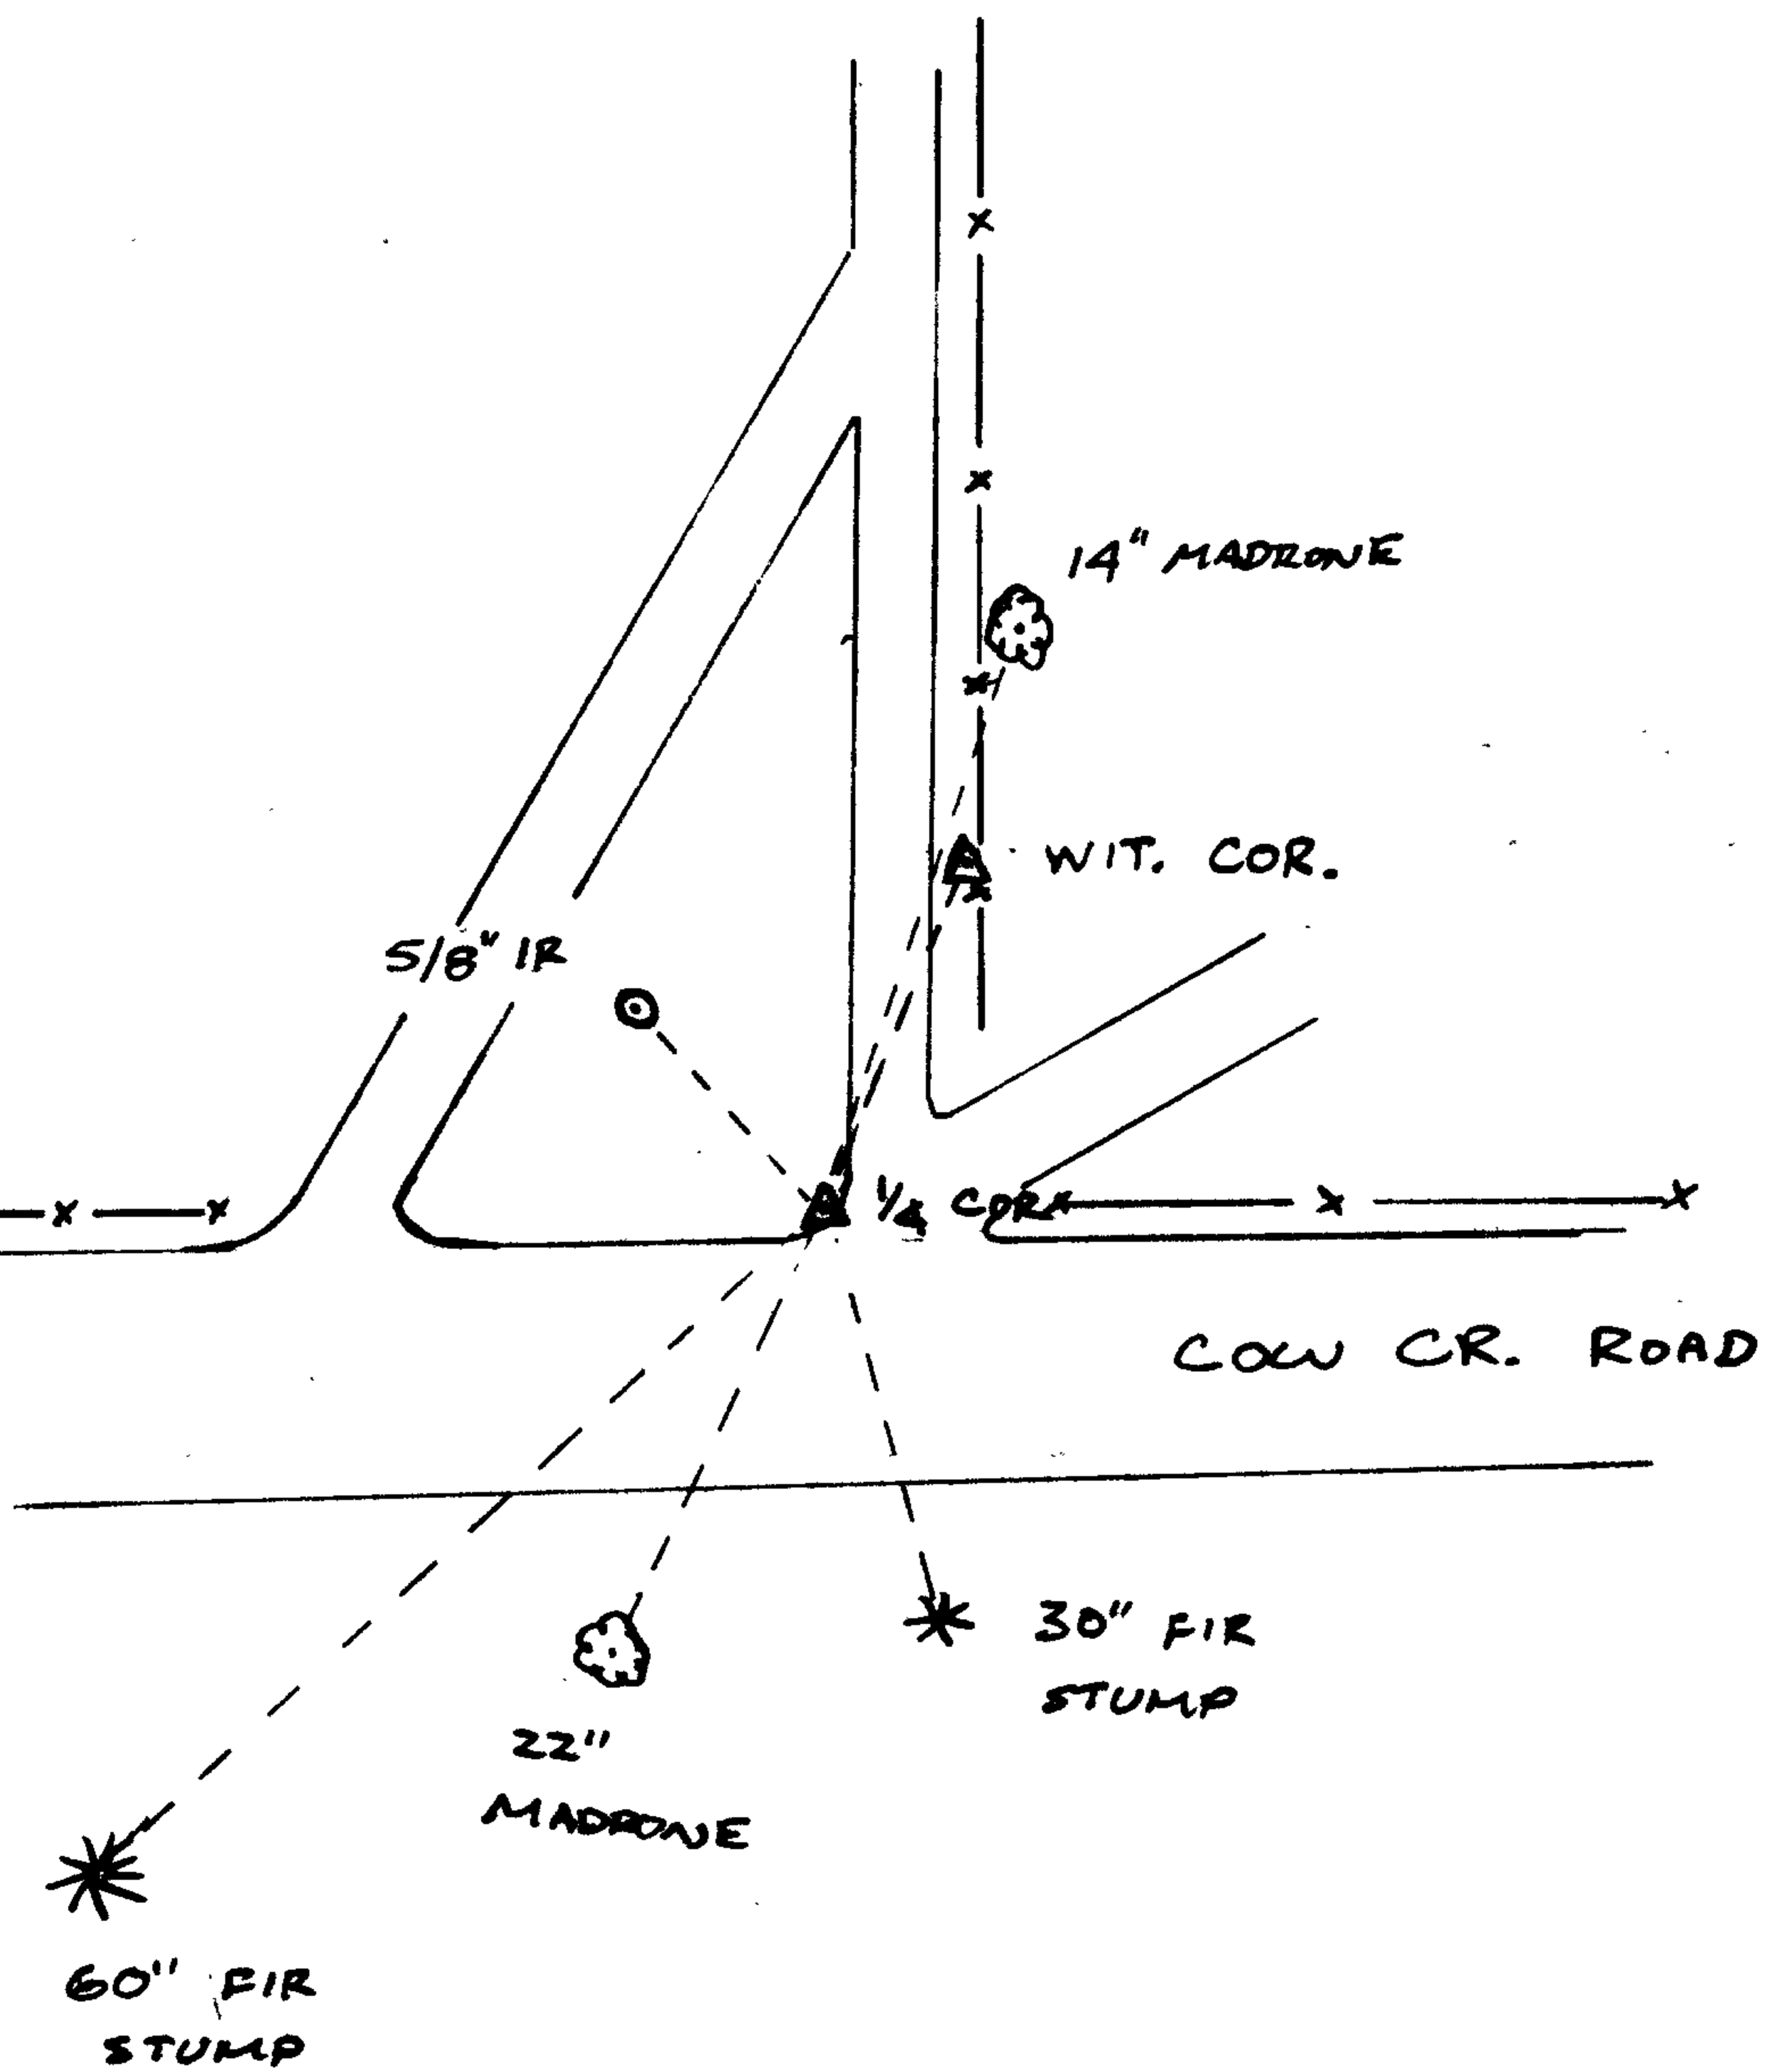

Comp. Declin. 19° E
Agency DCSO
Party Chief GREGORY E. QUIBELL
Notekeeper Gregory E. Quibell
Witnesses JOHN POWELL
RANDY SMITH

Surveyor's Seal

REGISTERED PROFESSIONAL LAND SURVEYOR
Gregory E. Quibell
OREGON
JULY 13, 1979
GREGORY E. QUIBELL
1834