





ROSEBURG, OR 9/4/70

DOUGLAS COUNTY SURVEYOR

BURT HOLT  
673 1251


PH.

CORNER RENEWAL REQUEST

Section 2 Twp. 21 Rge. A

Date 5-5-88

Condition of Corner and Accessories:

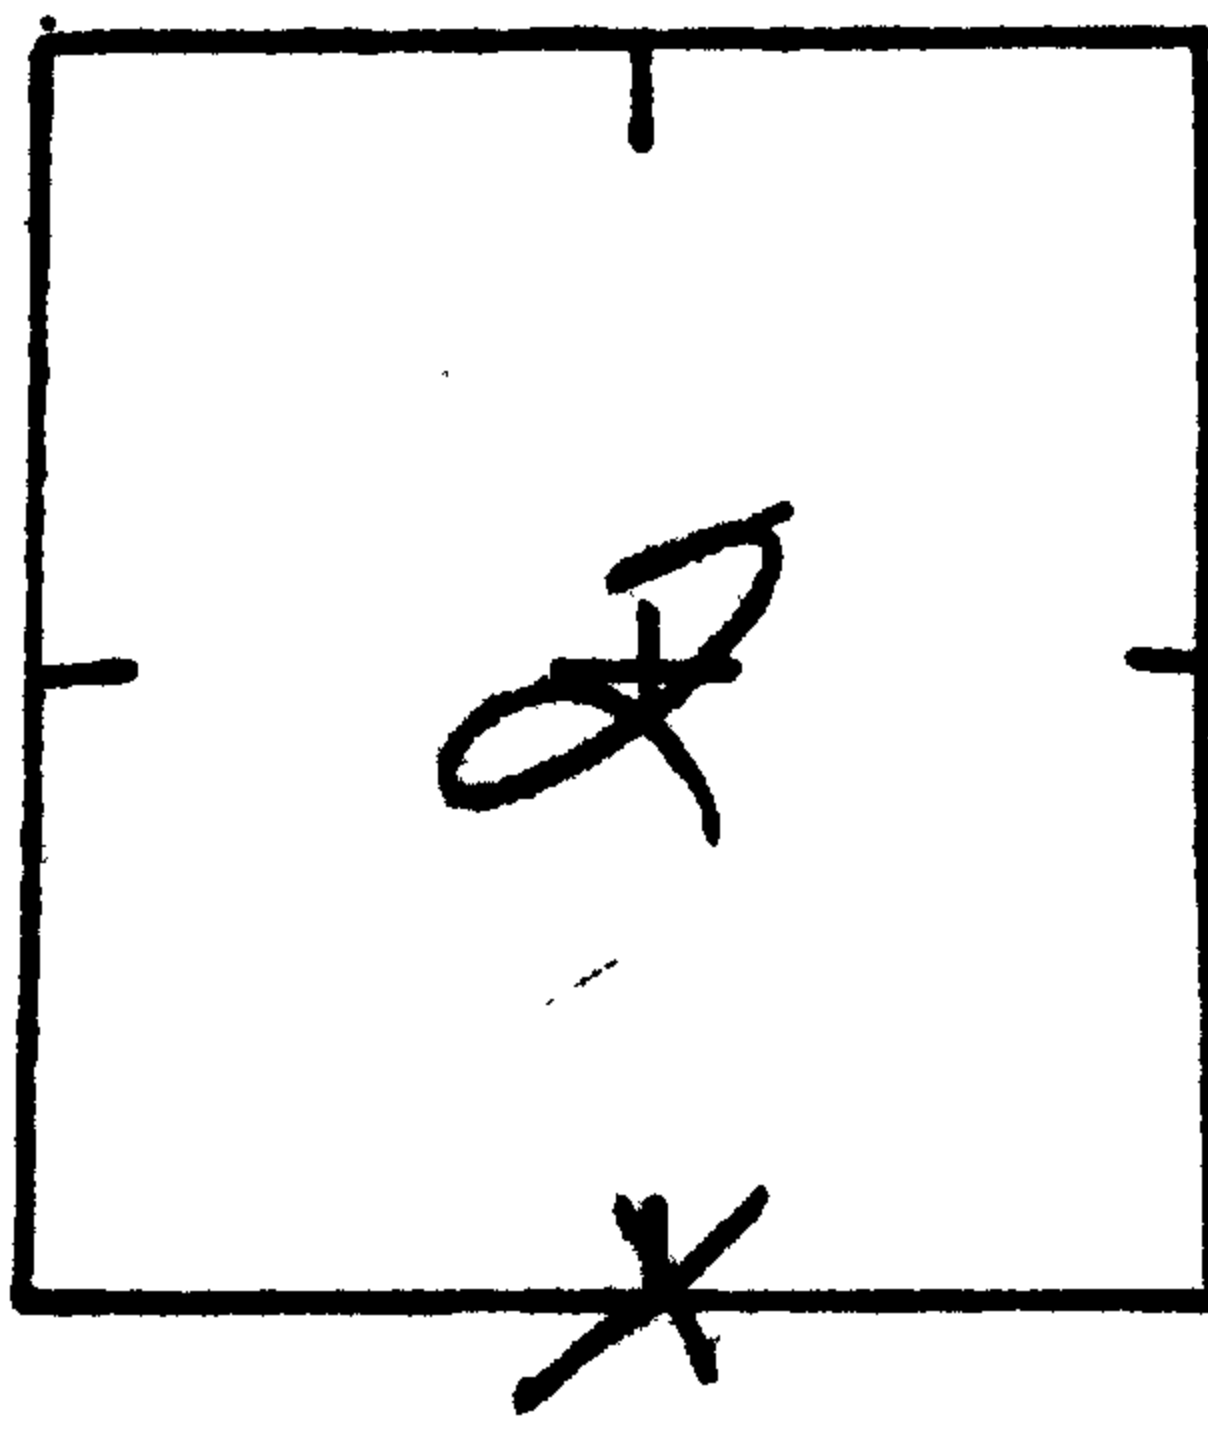

2 stumps - owner believes to be BT's  
as distance measures good  
(1 IR from Ren. #16)  
(1 corner)  
(Rens #16 & 115)

over

TO REACH: (Please show approximate distances, clearcuts, roads, fences, etc.)

OFF 99 (I-5) WEST of Divide Take PRINCE RO. TAKE  
SUN STUDS RD. (NOT MKD) BY A BIG BARN IN DRAW BELOW  
HOUSE (MAP ATTACHED)

Notify immediately prior to renewal visit? Yes X (if you want) No       
Notify following renewal visit? Yes X No       
Is corner in immediate danger of being lost or disturbed? Yes      No     

Name HERMAN PEEIFFER  
Address 3515 GLEN OAK DR.  
EUG. 97405  
Telephone 484-9757

ADDITIONAL COMMENTS CAN CALL OWNER IF IN AREA he CAN meet you &  
show you corner -

PERHAPS BETTER CALL SUN STUDS for permission to TRAVEL RO.

OWNER IS AN OLD FORESTER & feels the 2 STUMPS he has FO  
ARE the 2 TREES - Has RUN the LINE BETWEEN 2 & 11  
DISTANCE fits WELL - He HAS Driven in a PIPE where  
he BELIEVES CORNER SHOULD BE -

The 3/4" I.P. <sup>(1/2" I.P. used)</sup> MENTIONED IN Ren. # 115 IS THERE  
BUT ABOUT 20 FT EAST of where owner BELIEVES  
CORNER TO BE -

(Lane C. Wouldn't go out on his request.)

PROPERTY BELONGS TO THE STATE OF TEXAS



Found Probable orig. <sup>FIR</sup> Stump S40°E 145'

OLD AXE WORK

NO trace OF OTHER ORIG. BT.

Found per renewal 16 20" FIR = N44°E 165'  
Now 31" Stump

Found per Renewal 16 12" cedar = Now 29" Stump  
S2°E 214'

Found 1/2" I.P. Set by PFEIFFER

Found per Renewal 115 3/4" pipe this pipe bears  
N73°E 305' from I pipe set by PFEIFFER