

DATE: May 22, 1980

T265 R3E
S11 | S12
S14 | S13

OK
6-9-83
BY GREG
QUIBELL

Condition Report Only
 Not Found
 Renewed
 Unrecorded
 Surveyed In
 Referenced Out

Previous Renewal #'s None

Monument(s) Found: (Condition and Source) A 2 ins. diam. iron pipe, with a standard U.S.C. & G.S. brass cap, firmly set and protruding approx 0.5 feet from ground cap is marked T265 R3E

S11 | S12
S14 | S13
1930

Vol. 23
Pg 9758

Accessories Found: (Condition and Source) An original 26 ins. diam. Cedar bearing N. 40° E., 81² feet is gone. A original fir 28 ins. diam. now 36 ins. diam. bears S 59° E, 83² feet (as per record). An original fir 26 ins. diam. now 36 ins. diam. bears S 58° W, 10⁶ feet (as per record). An original 36 ins. diam. now 46 ins. diam. fir bears

✓ #5

N 14° W, 6⁶ feet (as per record).

RENEWAL

Monument Set: (Procedure and Description) Because monu-
ment as described before is endangered
by planned road work corner is referenced
out as follows: A P.K. nail is set in the root
crown of a distant tree (see specifics below) and a 5/8
ins diam iron rod with aluminum cap is set as a P.O.T.
beyond the P.K. nail. This is done in the NW and
New Accessories: (Description) NE quadrants.

A P.K. nail set in root crown at base of a 14 ins.
diam D. fir bears N 50° W, 128⁸⁴ feet, tree is
marked with unscribed blaze and DCSO B.T. tag.

A 5/8 ins. diam by 30 ins. long iron rod with a center
punched ^{1 ins. diam} DCSO aluminum cap bears N 50° W, 161⁹⁴ feet
Rod and cap are firmly set and protrude approx 4 ins. above
ground.

Location and Comments:

20° E

Compass Declination

Agency

Party Chief

Notekeeper

Witnesses

11/20/20

1/4/20

DATE: May 22, 1980

Condition Report Only

Not Found

Renewed

Unrecorded

Surveyed In

Referenced Out

T265 R3E (cont'd)


S11 | S12
S14 | S13

RENEWAL

Previous Renewal #'s

Sketch of reference objects

Monument(s) Found: (Condition and Source) (no scale)

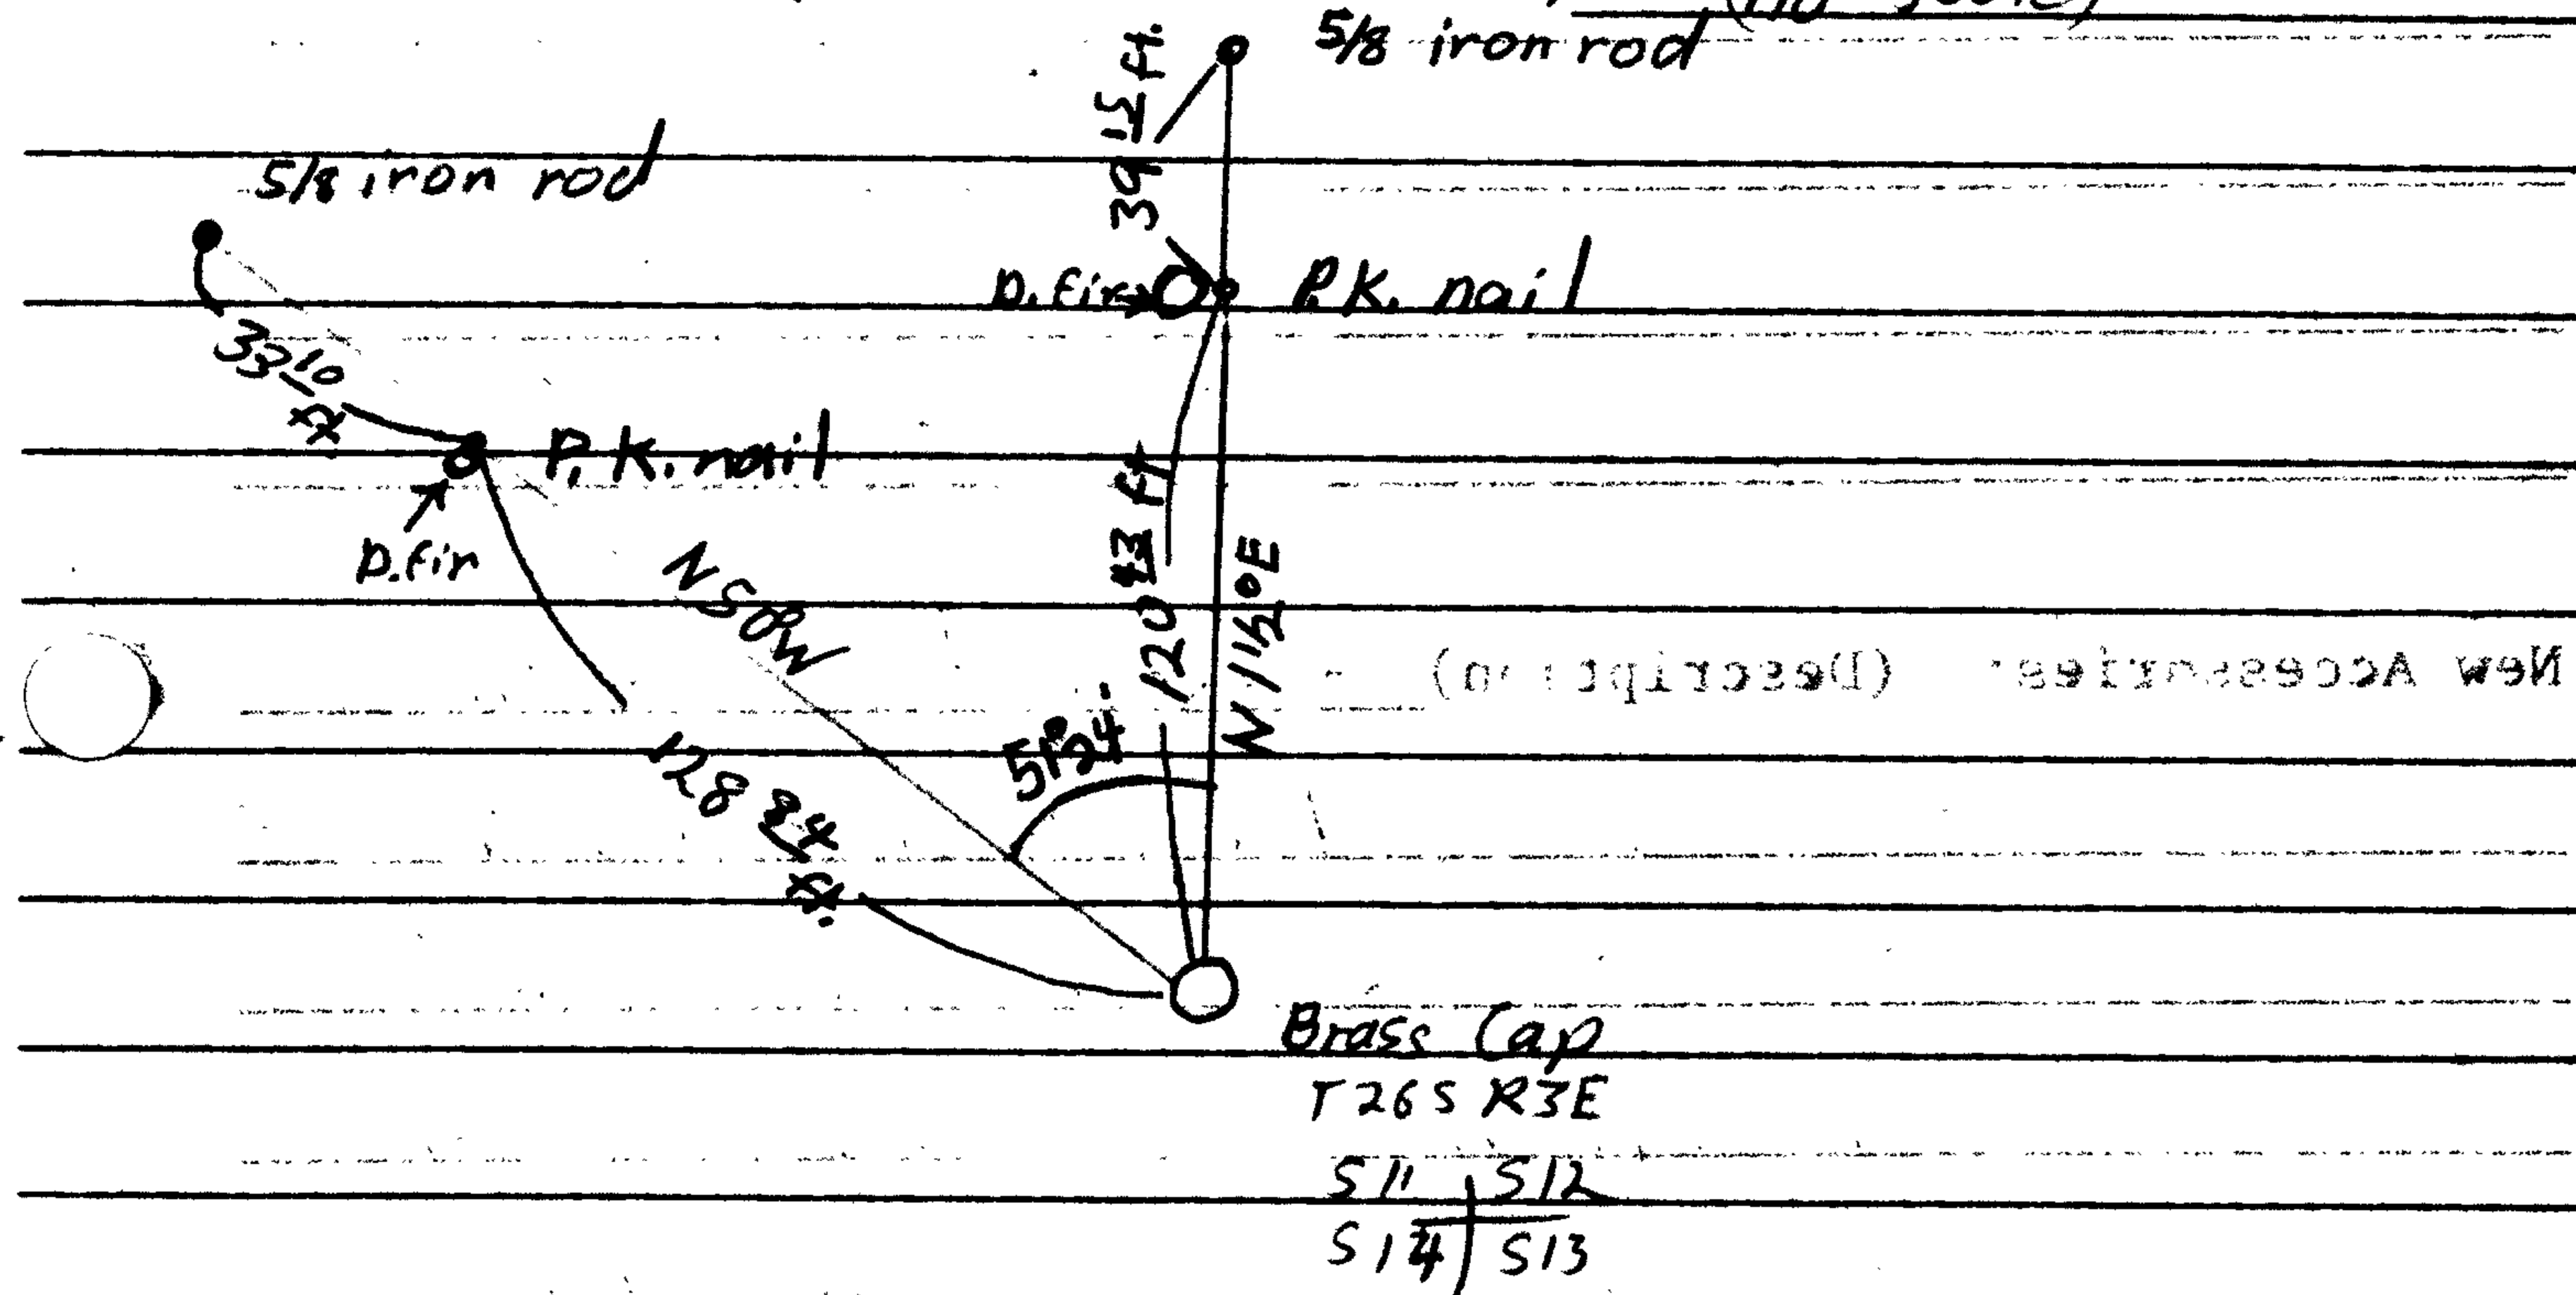

Accessories Found: (Condition and Source)

C.S. File No. 67-5960

(over)

Page 2 of 2

C.S. 62/9-11

RENEWAL

Monument Set: (Procedure and Description)

New Accessories: (Description) A PK nail set in the
root crown of a 34 ins. diam D. fir bears N 1 1/2° E
120 ⁴³ feet, tree is marked with an unscribed blaze
and a D.C.S.O. B.T. tag. A 5/8 ins. diam. by 30 ins long
iron rod with a center punched 1 ins. diam D.C.S.O
aluminum cap, bears N 1 1/2° E, 159 ⁵⁸ feet, rod and
cap are firmly set and protrude approx. 5 ins. above ground.

Location and Comments:

20° E

Compass Declination

D.C.S.O

Agency

Deputy Stephen J Flayse

Party Chief

Stephen John Flayse

Notekeeper

TERRI PLOWFF

Witnesses

SHAWN MEANS

ALEX STEPHENS

~~08/22/88~~