

GOVERNMENT CORNER RESTORATION FORM

Township 30 S Range 2 W Sec. 20 County DOUGLAS

State OREGON Date 7-21-83 No. _____

Corner Designation

EAST $\frac{1}{4}$ S 20 |

- Condition Report Only
- Not Found
- Renewed
- Unrecorded
- Surveyed In
- Referenced Out

Previous Renewals 178

Monument(s) Found: (Condition and Source)

FROM RENEWAL #178 A 1" IRON PIPE
 WITH ATTACHED BRASS CAP, PROTRUDING FROM
 MOUND OF STONE APPROXIMATELY 18".
 CAP IS STAMPED AS NOTED

MONUMENT DETAIL

COUNTY SURVEYORS OFFICE

$\frac{1}{4}$ S 20 |

1970

Accessories Found:

ORIGINAL 73" FIR NOW 76" DIA WITH WELL HEALED BLAZE BEARS N 62° W
 46.2 (REC. 47.5)

PER REN #178 A D FIR 6" NOW 10" WITH WELL HEALED DOUBLE BLAZE
 BEARS N 14° W 51.1 FEET.

#249 ✓

File No. 62/9-19 C

RENEWAL

Monument Set (Procedure and Description)

Monument Detail

NONE

ROUND STONE AROUND FOUND MONUMENT.


New Accessories

A 7" HEMLOCK DOUBLE BLAZED AND SCRIBED $\frac{1}{4}$ S 20 CS BT" BEARS N 40° W 27.4

Sketch of Monument, Accessories, and General Area

Location & Comments

CORNER IS APPROX 33 FT SOUTH OF CREEK COURSE EAST

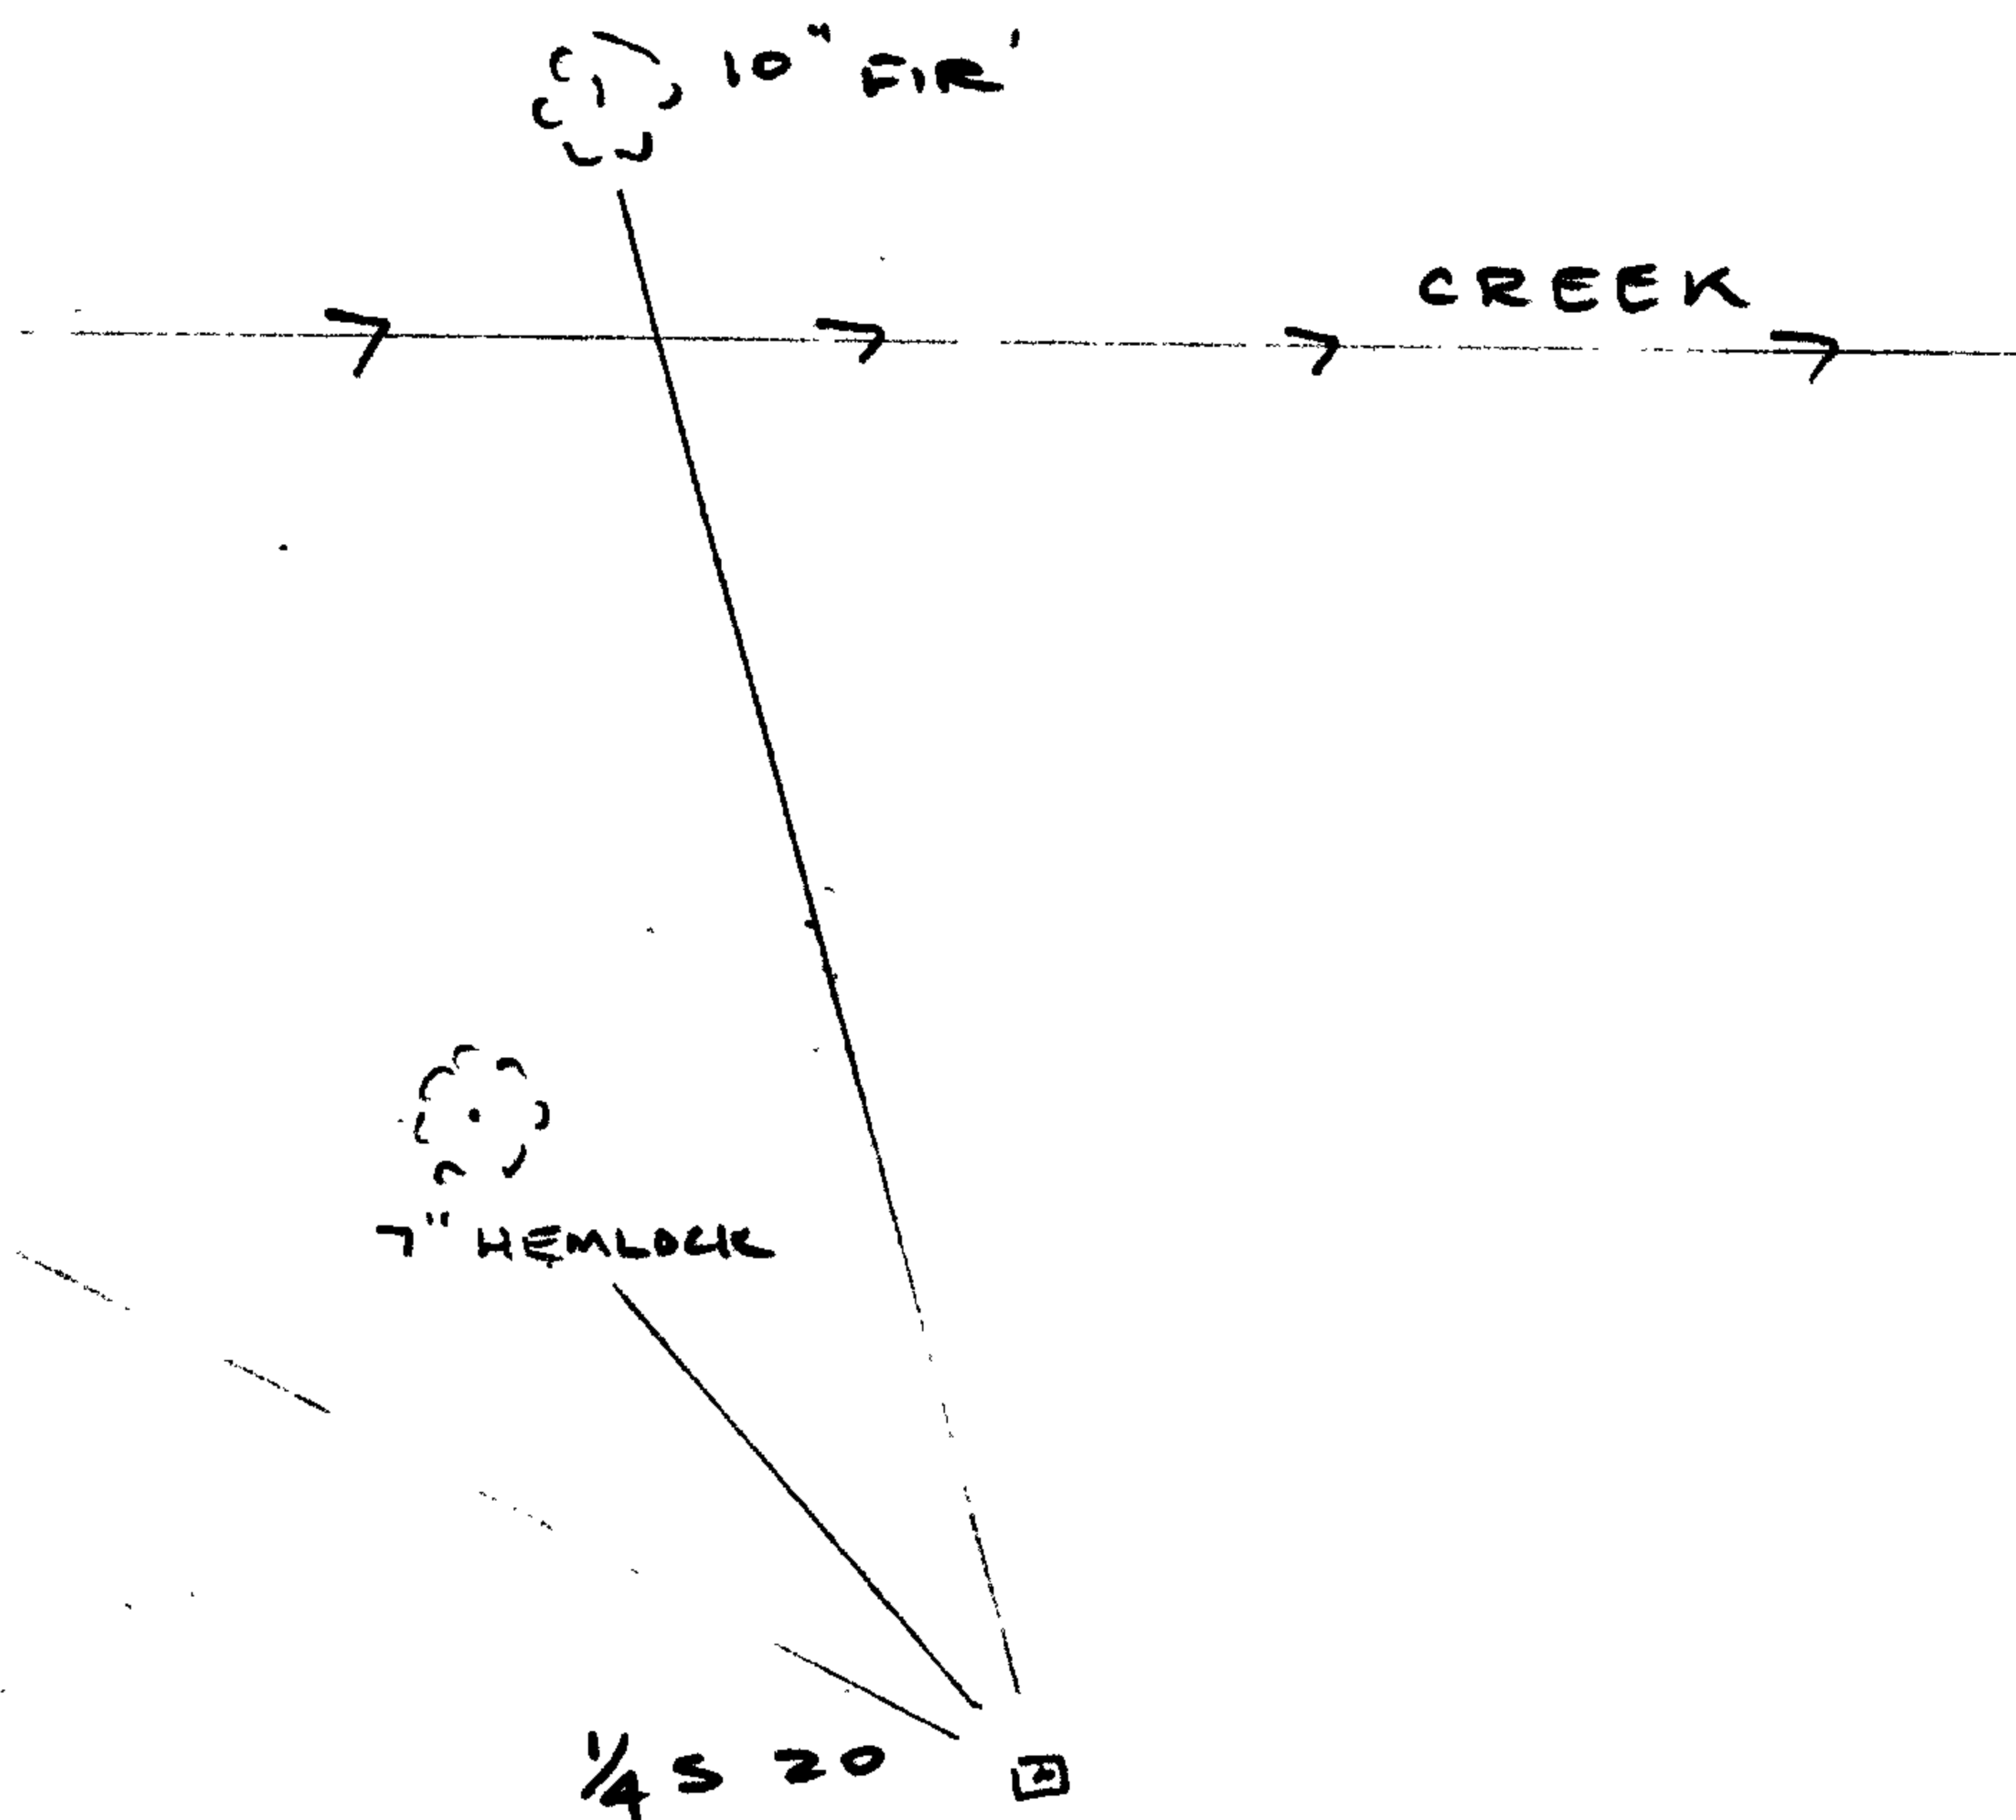

Comp. Declin. 19° EAST
Agency DOUG. CO. SURV. OFF.
Party Chief L. E. MONREAN
Notekeeper " " "
Witnesses J. M. POWELL

Surveyor's Seal

REGISTERED
PROFESSIONAL
LAND SURVEYOR

Larry E. Monrean

OREGON
JULY 13, 1979
LARRY E. MONREAN
#1839