

GOVERNMENT CORNER RESTORATION FORM

Township 30 S Range 4 W Sec. 14 County DOUGLAS

State OREGON Date 7-11-83 No. _____

Corner Designation

T 30 S R 4 W

1/4 S 14
S 23

- _____ Condition Report Only
- _____ Not Found
- Renewed
- _____ Unrecorded
- _____ Surveyed In
- _____ Referenced Out

Previous Renewals 15, 200, 1981 BLM RESURVEY

Monument(s) Found: (Condition and Source)

FOUND 1981 BLM MONUMENT FIRMLY SET IN A VERTICAL POSITION UNDER 15 INCHES OF FILL ALONG SOUTHERLY SIDE OF DIRT ROAD. CAP IS MARKED AS NOTED

THE STONE & STAKE PER RENEWAL # 15 NOT FOUND
THE BRASS CAP MONUMENT PER RENEWAL # 200 NOT FOUND.

MONUMENT DETAIL

T 30 S R 4 W

1/4 S 14
S 23
1981

Accessories Found:

ORIGINAL 12" OAK RESEISED DURING RENEWAL
#200 (1963) NOW 32" DIA. IT HAS PARTIALLY HEALED BLAZE WITH SOME SCRIBING VISIBLE BEARS S 47° W 23⁰ FEET (REC. S 45° W).

1981 BLM SURVEY
7" NOW 8" MADRONE BARK SCRIBED " 1/4 S 23 BT" BEARS S 85 1/2° E 26 1/2 FEET.

UNRECORDED 1/2" DIA. IRON PIPE WITH A 1/2" DIA BOLT ALONGSIDE
BEARS S 25° E 9 1/2 FEET.

#284 ✓

S. E. No. 62/9-22 C

RENEWAL

Monument Set (Procedure and Description)

Monument Detail

NONE


AS THIS MONUMENT IS FIRMLY SET AND APPEARS TO BE SAFE BELOW THE SURFACE WE PLACE AN IRON FENCE POST AND WITNESS SIGN ALONG NORTHERLY EDGE OF MONUMENT.

New Accessories

A 9" MADRONE DOUBLE BLAZED AND SCRIBED " 1/4 S 14 CS BT " BEARS N 45° W 76 3/4 FEET.

Sketch of Monument, Accessories, and General Area

Location & Comments

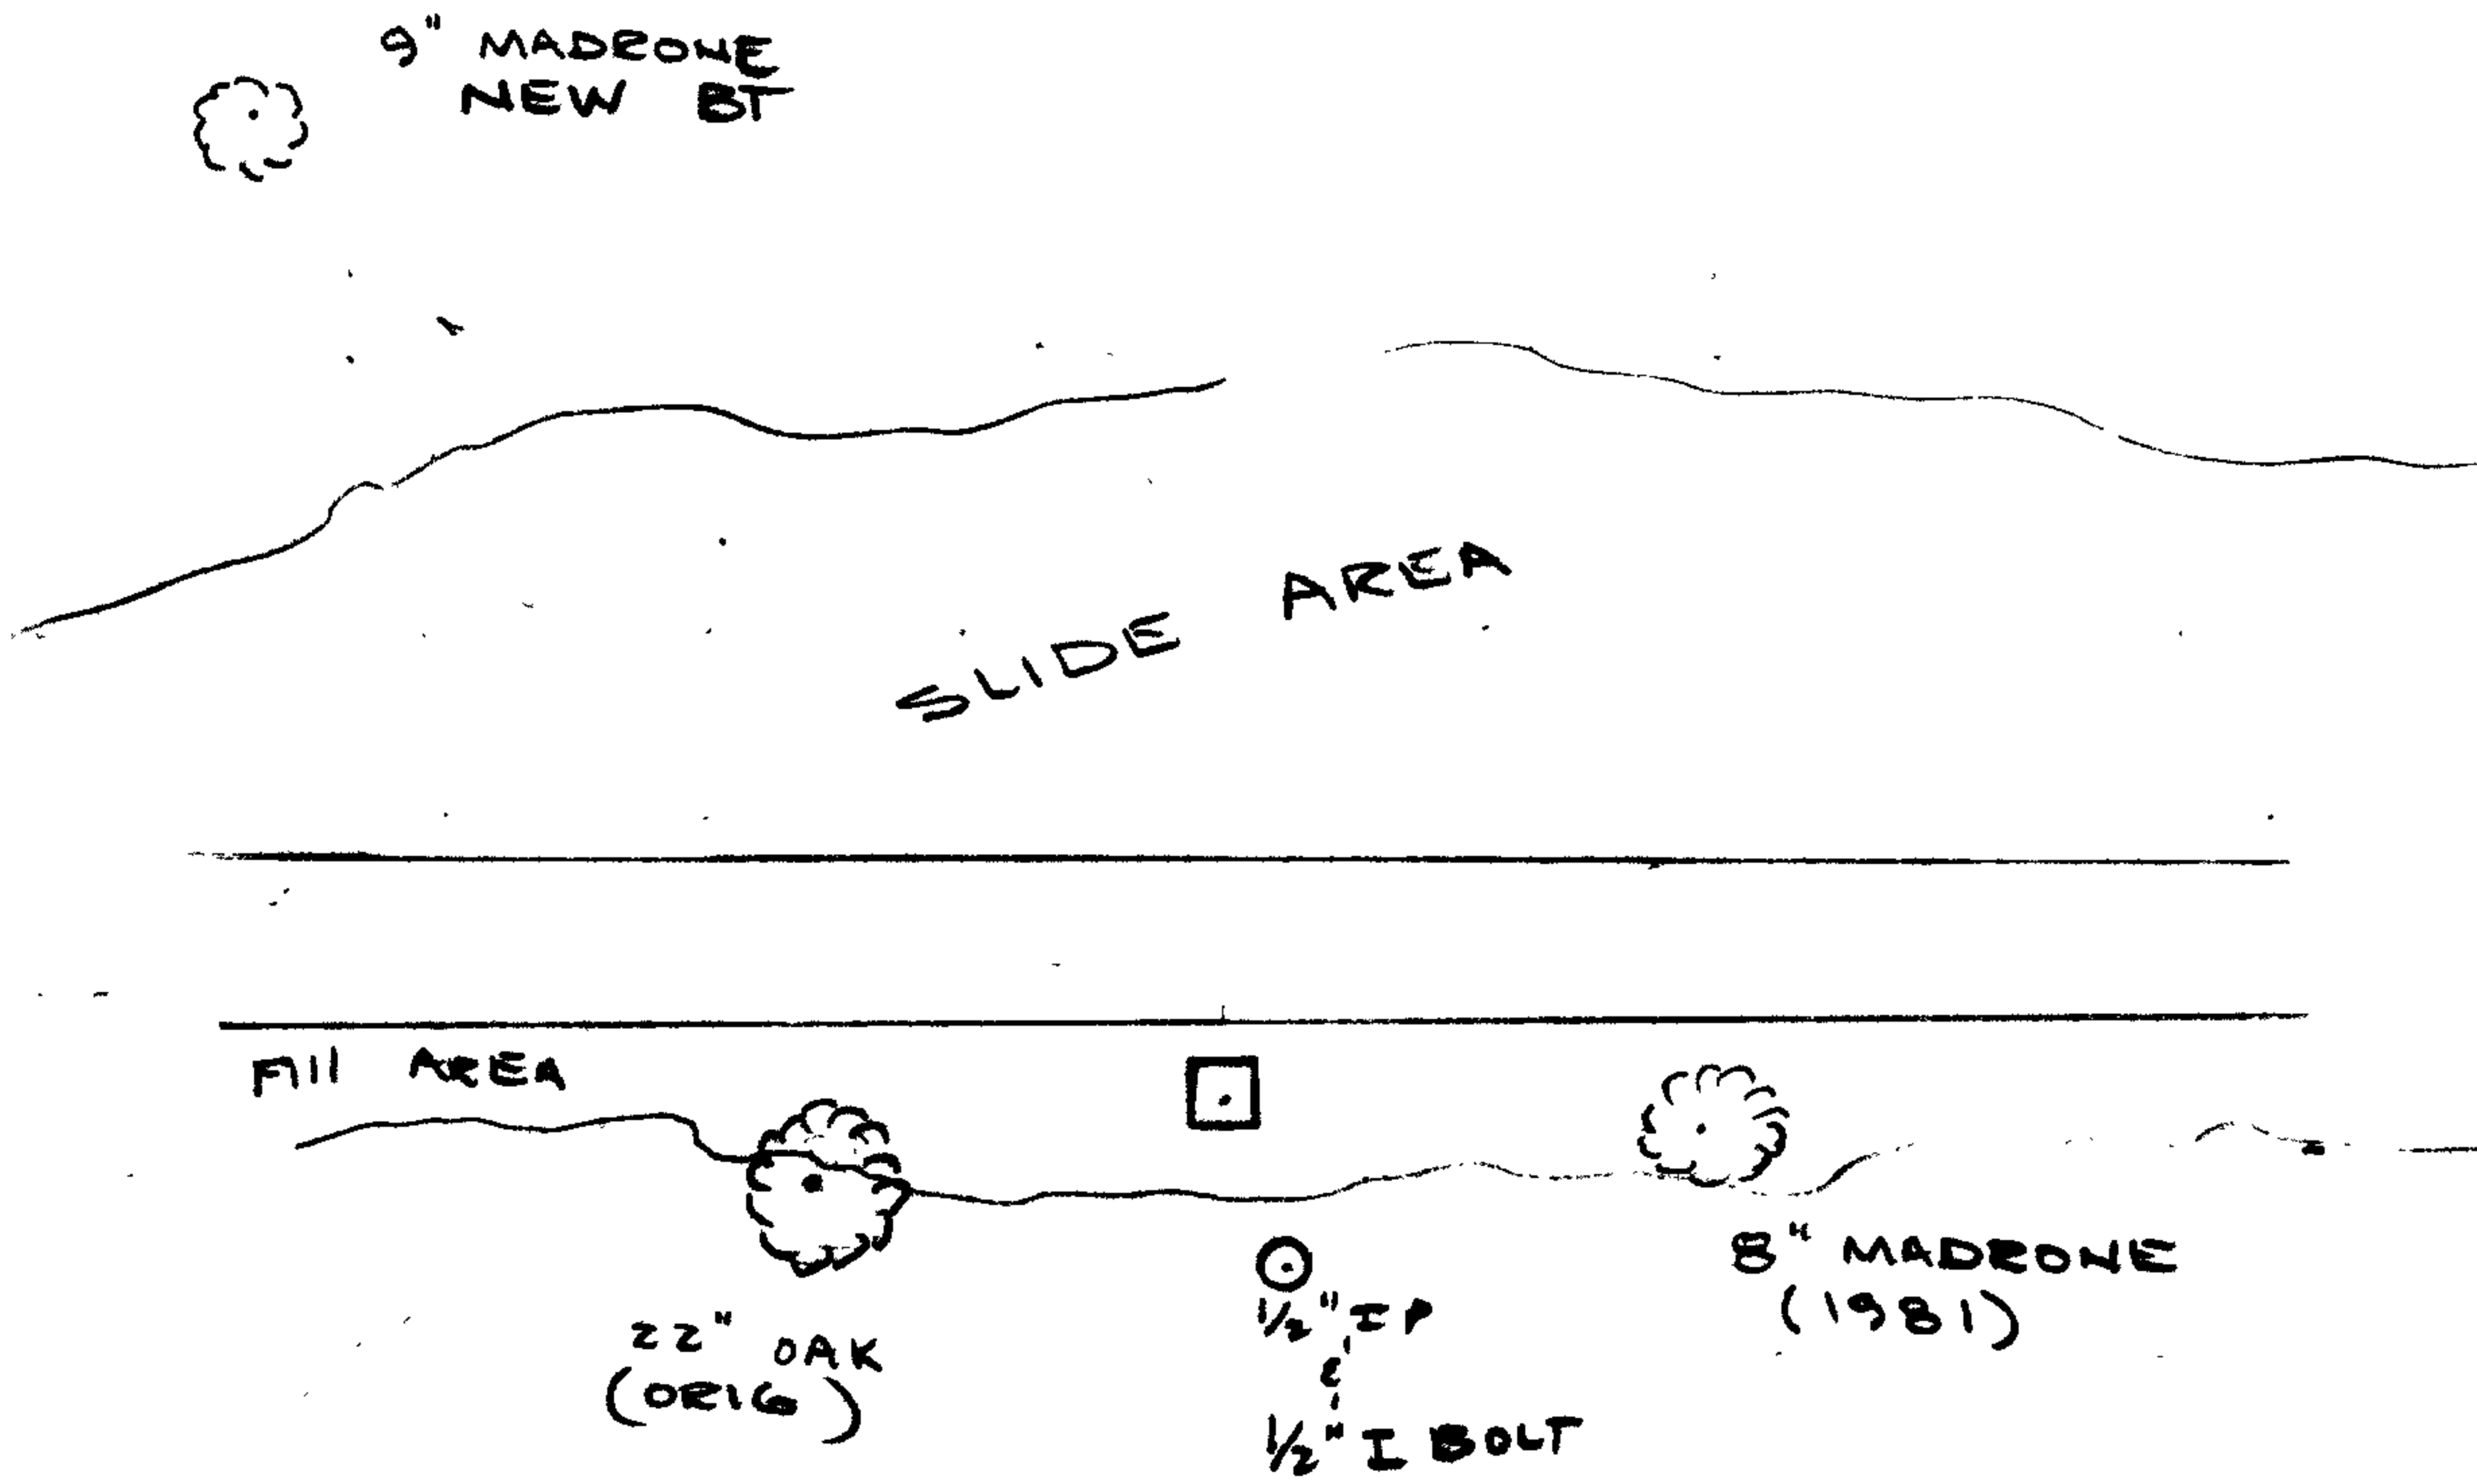

Comp. Declin. 19° EAST
Agency DOUGLAS Co. SURV. DEPT.
Party Chief LARRY E. MONREAN
Notekeeper Jerry E. Monrean
Witnesses J.M. POWELL
7-11-83

Surveyor's Seal

REGISTERED
PROFESSIONAL
LAND SURVEYOR

Jerry E. Monrean

OREGON
JULY 13, 1979
LARRY E. MONREAN
#1830