

OREGON CORNER RESTORATION FORM

Township 31 S Range 4 W Section 28

County DOUGLAS Date 8-19-83

Corner Designation

C 1/4 S 28

- Condition Report Only
- Not Found
- Renewed
- Unrecorded
- Surveyed In
- Referenced Out

Previous Renewals/Surveys, etc. 1972 BLM SURVEY

Monument(s) Found: (Condition and Source)


1972 BLM MONUMENT, A 2 1/2" IRON PIPE WITH BRASS CAP, FIRMLY SET PROTRUDES 3" ABOVE GROUND

Accessories Found:

A 22" NOW A 24" DIAMETER WINDFALL D. FIR WITH WELL HEALED BLAZE BEARS N 73° E 82 FEET TO ROOT HOLE.

A 81" DIAM. FIR NOW A STUMP DISTURBED BY FIRE TRAIL CONSTRUCTION BEARS S 18° W 382 FEET (REG. S 16° W 372 FEET).

Monument Detail

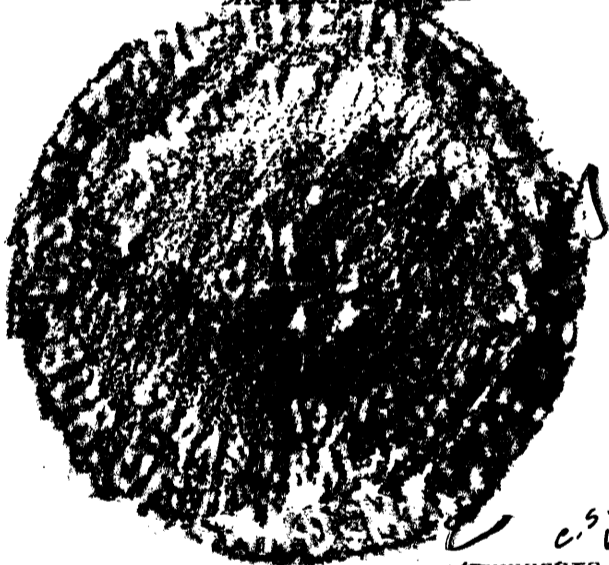


c.s. 6/2/9

Monument Set (procedure and description)

NONE

Sketch

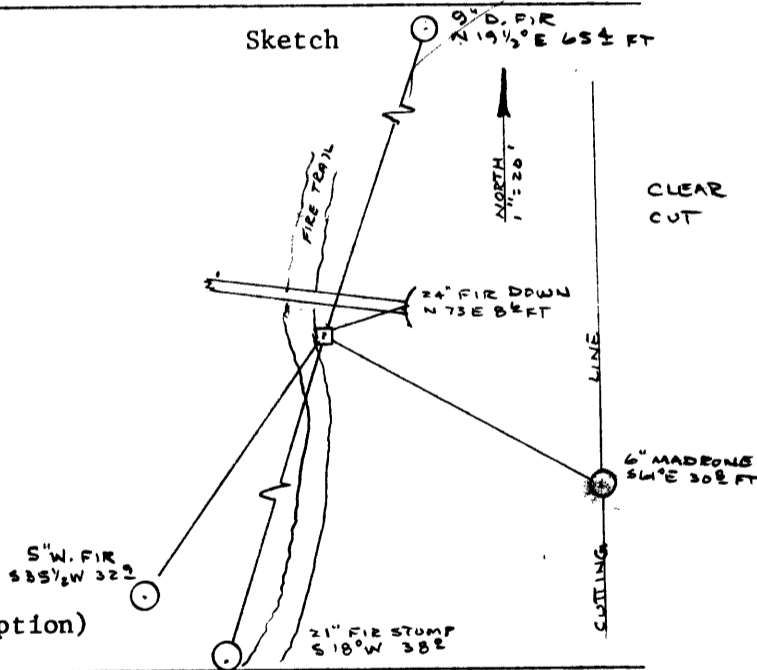

New Accessories

6" DIA. MADRONE DOUBLE BLAZED AND SCRIBED "C 1/4 S 28 CS BT" BEARS S 61° E 302 FEET
5" DIA W. FIR DOUBLE BLAZED AND SCRIBED "C 1/4 S 28 CS BT" BEARS S 35 1/2° W 322 FEET.
9" DIA. D. FIR DOUBLE BLAZED AND SCRIBED "C 1/4 S 28 CS BT" BEARS N 19 1/2° E 65 1/2 FEET.

Location & Comments

MONUMENT IS LOCATED ALONG EAST EDGE OF FIRE TRAIL AND ABOUT 28 FEET WEST OF N-S CUTTING LINE (CLEAR CUT ON EAST)

Compass Declination 19° E
 Firm/Agency DOUG. CO. SURV. OFF.
 Address RM 205 JUSTICE BLDG., PSEB., ORE.
 Party Chief LARRY E. MONREAN
 Notes " " "
 Witness JIM POWELL, P.W. SMITH

Surveyor's Seal

REGISTERED PROFESSIONAL LAND SURVEYOR

Larry E. Monrean
 OREGON
 JULY 13, 1979
 LARRY E. MONREAN
 #1830

#174 ✓

GREEN 6/2/9 25