

CERTIFIED RECORD OF LAND CORNER MONUMENTATION


History of original corner establishment:

Corner established in 1902 by Homer D. Angell, Deputy Surveyor.

A basalt stone, 12 x 10 x 6 ins., 8 ins. in ground for 1/4 Sec. Cor., marked 1/4 on N. face.

A fir, 12"d, S60°W, 60 Lks, marked 1/4 S15 BT.

A fir, 40"d, N9°W, 87 Lks, marked 1/4 S10 BT.

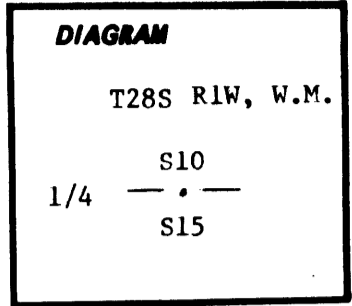

FILED
RECEIVED *JL*

AUG 18 1983

COUNTY SURVEYOR
DOUGLAS COUNTY, ORE.

Description of corner evidence found:

12" x 10" x 6" stone set 8" in the ground with marks "1/4" faintly visible on north face.

From which remaining original BT:

A 40" D. fir snag, N9°W, 58² Ft. with scribe marks "1/4S" visible on decayed blaze.

[Faint handwritten notes]

Description of monument and accessories established to perpetuate the original location of this corner:

At position of corner stone, I set a 2½" x 30" iron post with 2½" brass cap, 16" in the ground with a 3 Ft. diameter mound of stone up to brass cap. Brass cap is marked as shown:


Original corner stone is buried alongside.

From which I marked new BT's:

A 10" D. fir, S14°W, 15⁷ Ft., scribed "1/4 S15 BT" on a single blaze.

A 12" D. fir, N51°W, 12⁶ Ft., scribed "1/4 S10 BT" on a single blaze.

Magnetic declination was 18°E.

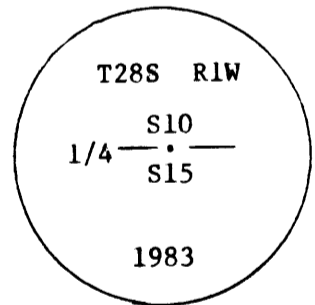

**REGISTERED
PROFESSIONAL
LAND SURVEYOR**

Maurice E. Farr

**OREGON
SEPT. 23, 1977
MAURICE E. FARR
1181**

Office of..... Surveyor..... County of..... Douglas.....

State of... Oregon....., I hereby certify that the within instrument was filed in this office

for record on the 18 day of August, 1983

F. L. Ingram by Virginia A. Laugen

(COUNTY OFFICIAL)

(DEPUTY)

Virginia A. Laugen

Form R6-7100-57 (9/71)

☆ GPO—798-276

#38 ✓

File No. 62/10-1