

GOVERNMENT CORNER RESTORATION FORM

Township 25S Range 1 & 2E Sec. 13&24, County DOUGLAS  
18&19  
State OREGON Date MAY 10, 1983 No. \_\_\_\_\_

Corner Designation

SECTION CORNER TO SECTIONS 13 & 24, T25S R1E  
& 18 & 19, T25S R2E.


\_\_\_\_ Condition Report Only  
\_\_\_\_ Not Found  
 Renewed  
\_\_\_\_ Unrecorded  
\_\_\_\_ Surveyed In  
\_\_\_\_ Referenced Out

Previous Renewals

MONUMENT DETAIL

Monument(s) Found: (Condition and Source)

2nd IRON POST, FIRMLY SET, PROJECTING 6" ABOVE  
GROUND, LEANING WESTERLY WITH BRASS CAP MARKED AS  
SHOWN. SET BY G.L.O. IN 1927. USED THE POINT WHERE  
THE I.P. COMES OUT OF THE GROUND AS THE CORNER  
POINT.

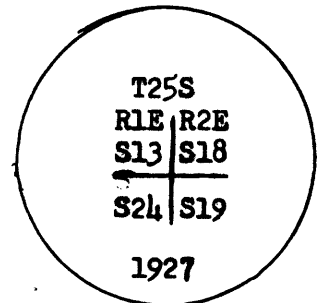

Accessories Found:

REMAINING ORIGINAL BTs:

- A 26" D. FIR STUMP, N31°E, 31.9 FT. (REC. 32.3 FT.) WITH HEALED BLAZE.
- A 1 1/4" D. FIR, S28°E, 9.9 FT. WITH HEALED BLAZE.
- A ROOTHOLE, N38°W, 51.5 FT. WITH 1 1/4" D. FIR LOG ALONGSIDE WITH FRAGMENTARY SCRIBE MARKS VISIBLE ON PARTIALLY HEALED BLAZE.

#7-25-2EV  
#45-T.25-1E ✓

G. S. File No. 62/10-2

