

GOVERNMENT CORNER RESTORATION FORM

Township 25S Range 2E Sec. 15 & 22 County DOUGLAS

State OREGON Date Oct. 31, 1983 No. _____

Corner Designation

$\frac{1}{4}$ corner to sec. 15 & 22.


- _____ Condition Report Only
- _____ Not Found
- Renewed
- _____ Unrecorded
- _____ Surveyed In
- _____ Referenced Out

Previous Renewals

Monument(s) Found: (Condition and Source)

1" D. I.P. 36" LONG WITH BRASS CAP MARKED AS
SHOWN, LYING ON GROUND, SET BY G.L.O. IN 1928.

MONUMENT DETAIL

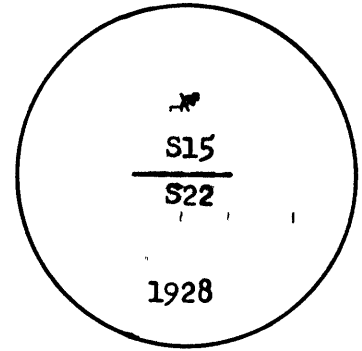

Accessories Found:

ORIGINAL BTE:

A- 24" HEMLOCK STUMP, 3 1/4" W, 6.4 FT. (REC. S21" W, 4.6 FT.) WITH SCRIBE MARKS "1/2 2 T"
VISIBLE ON PARTIALLY HEALED BLAZE (BLAZE FACING N 1/4" E FOR A SW BT).

A- 30" HEMLOCK STUMP, NO 6" W, 66.0 FT., WITH SCRIBE MARKS "1/2 S BT" VISIBLE ON PARTIALLY
HEALED BLAZE.

#9 ✓

C. & E. File No. 62/10-4

C

RENEWAL

Monument Set (Procedure and Description)

Monument Detail

DISTANCE-DISTANCE FROM THE CENTER OF THE BTs WOULD NOT INTERSECT; AND FROM THE FACES OF THE BTs WOULD NOT MATCH THE BLAZED FACES. AT RECORD BEARING & DISTANCE FROM THE ORIGINAL NW BT AND FROM THE DIRECTION OF THE FACE ON THE ORIGINAL SW (REC. SE) BT, I RESET I.P. 30" IN THE GROUND IN A 3 FT. D. MOUND OF STONE. I STAMP "RESET 1983 CS" ON BRASS CAP.

New Accessories

NEW BTs MARKED:


- A- 5" HEMLOCK, N53°E, 13.0 FT., SCRIBED "15 CS BT" ON SINGLE BLAZE.
- A- 12'x20'x8' HIGH ROCK OUTCROP, S42°W, 55.2 FT., MARKED "X BO" ON HIGHEST POINT (ALONG NORTH EDGE).

Sketch of Monument, Accessories, and General Area

Location & Comments

CORNER IS IN USFS CLEARCUT 25-2-15-1, APPROXIMATELY 130 FT. EAST AND 200 FT. NORTH OF REYNOLDS CREEK.

Comp. Declin. 18 1/2°E
 Agency U.S. FOREST SERVICE
 Party Chief JIM LANDRUM, L.S. 2024
 Notekeeper LEONARD HERZSTEIN
 Witnesses LEONARD HERZSTEIN

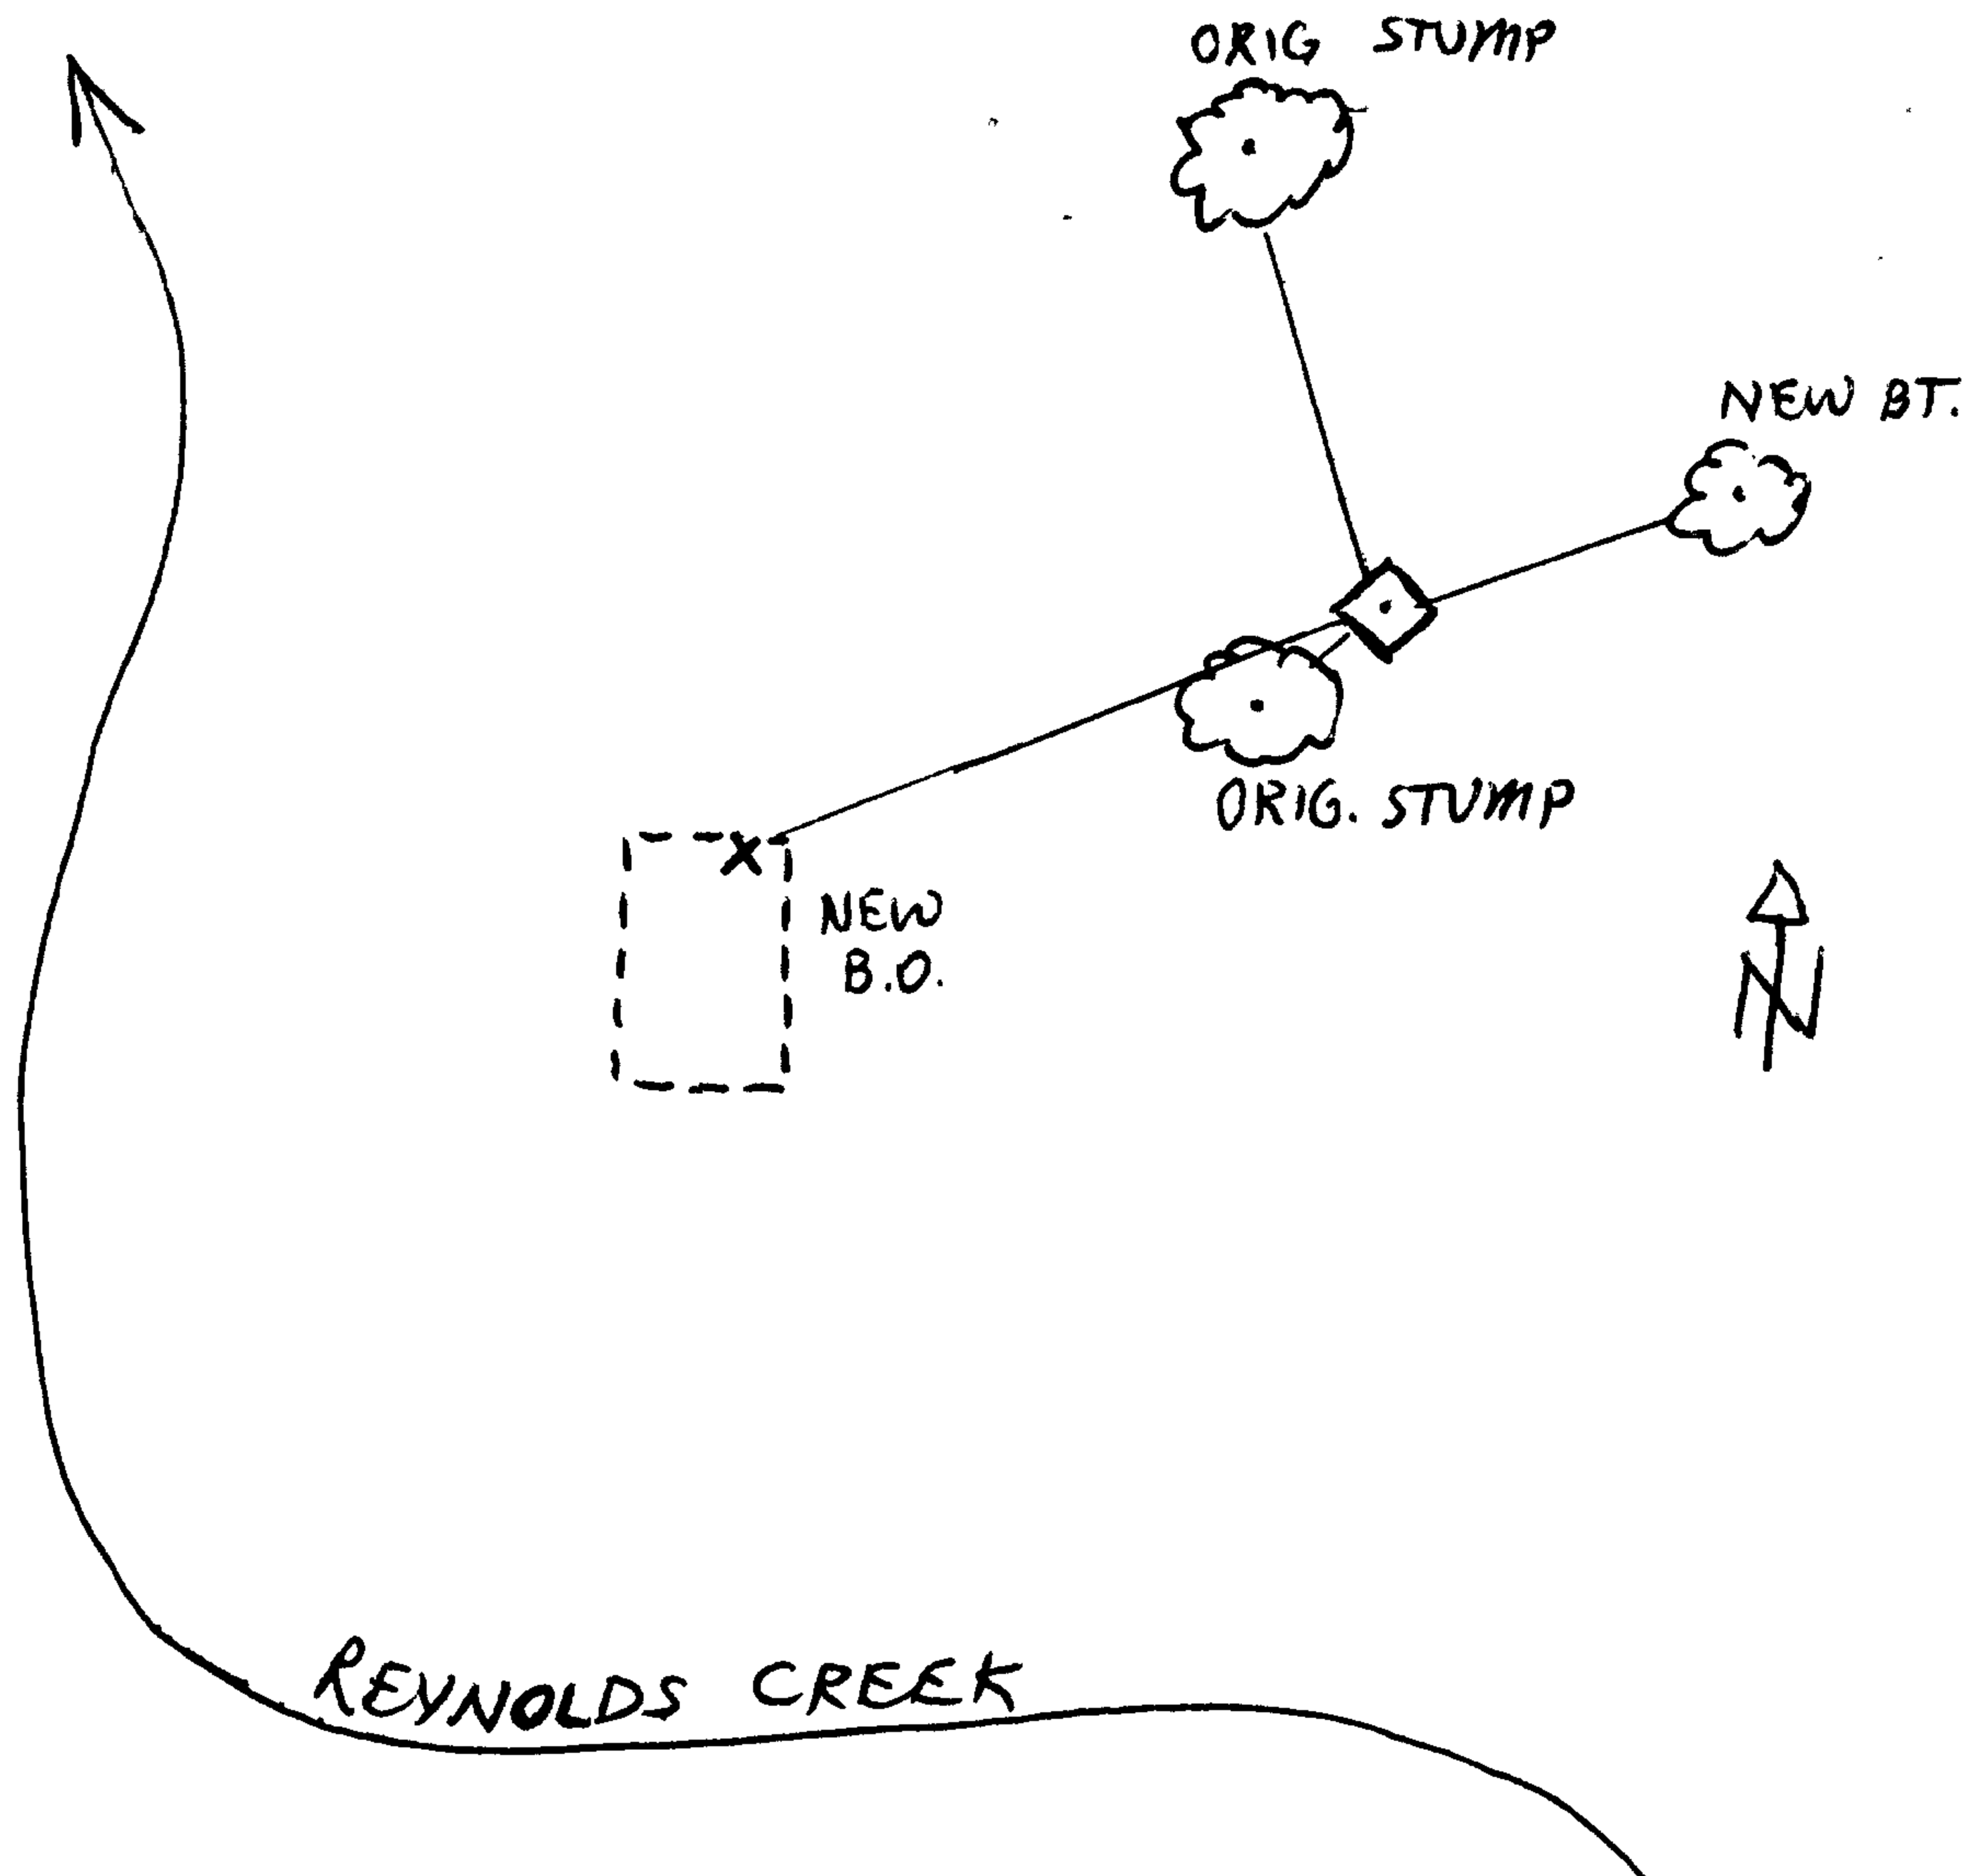

Surveyor's Seal
 REGISTERED
 PROFESSIONAL
 LAND SURVEYOR

Jim Landrum

OREGON
 FEBRUARY 4, 1983
 JAMES N. LANDRUM
 2024