

GOVERNMENT CORNER RESTORATION FORM

Township 29S Range 1W Sec. 31 County DOUGLAS

State OREGON Date JUNE 7, 1983 No. _____

Corner Designation


CENTER QUARTER CORNER OF SECTION 31,
T29S-1W.

- Condition Report Only
- Not Found
- Renewed
- Unrecorded
- Surveyed In
- Referenced Out

Previous Renewals # ///

MONUMENT DETAIL

Monument(s) Found: (Condition and Source)
2" IRON POST, FIRMLY SET, PROJECTING
6" ABOVE A 2 FT. MOUND OF STONE WITH
BRASS CAP MARKED AS SHOWN, SET BY
BRUCE A. SHANER, L.S. 430, IN 1973.

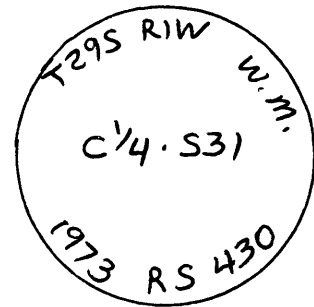

Accessories Found:

BTS. MARKED BY SHANER IN 1973:

A 14" J. CEDAR, S 32° E, 16⁸ FT. WITH SCRIBE MARKS "C 1/4 S31 BT" AND

A 1 1/2" d BRASS WASHER STAMPED "RS 430", VISIBLE ON PARTIALLY
HEALED DOUBLE BLAZE.

A 16" D. FIR STUMP, N 81° W, 50⁰ FT. WITH SCRIBE MARKS "1/4 S31 BT"

AND A 1 1/2" d. BRASS WASHER STAMPED "RS 430", VISIBLE ON PARTIALLY
HEALED DOUBLE BLAZE.

A 12" Now 14" →

#15 X

G. L. E. No. 62/10-5
C

