

GOVERNMENT CORNER RESTORATION FORM

Township 29S Range 1W Sec. 31 County DOUGLAS

State OREGON Date JUNE 8, 1983 No. \_\_\_\_\_

Corner Designation


CENTER WEST 1/16 CORNER OF SECTION 31,  
T29S, R1W.

- \_\_\_\_\_ Condition Report Only
- \_\_\_\_\_ Not Found
- Renewed
- \_\_\_\_\_ Unrecorded
- \_\_\_\_\_ Surveyed In
- \_\_\_\_\_ Referenced Out

Previous Renewals M49-43 <sup>PROPORTIONED</sup> By SHANER

Monument(s) Found: (Condition and Source)  
2" IRON POST, FIRMLY SET, PROJECTING  
12" ABOVE GROUND WITH BRASS CAP  
MARKED AS SHOWN, SET BY BRUCE A.  
SHANER, L.S. 430, IN 1973.

MONUMENT DETAIL

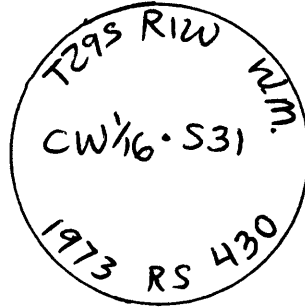

Accessories Found:

BTS MARKED BY SHANER IN 1973:  
A 18" D. FIR STUMP, N28°E, 50± FT., WITH SCRIBE MARKS "CW 1/16 S31 BT"  
AND A 1 1/2" d. BRASS WASHER STAMPED "RS 430" VISIBLE ON PARTIALLY  
HEAVED DOUBLE BLAZE.  
A 8" W. FIR SNAG, S76°W 14± FT., WITH SCRIBE MARKS "CW 1/16 S31 BT"  
~~AND A 1 1/2" d. BRASS WASHER STAMPED "RS 430" VISIBLE ON~~  
PARTIALLY HEAVED DOUBLE BLAZE.

RENEWAL

Monument Set (Procedure and Description)

Monument Detail

I ADDED A 2 FT. DIAMETER MOUND OF STONE. IRON POST NOW PROJECTS 6".

New Accessories

I ~~RE~~ MARKED NEW BTS:  
A 14" W. FIR, S28 1/2° W, 196 FT., SCRIBED "CW 1/16 S31 CS BT" ON A SINGLE BLAZE.  
A 13" W. FIR, N33° W, 304 FT., SCRIBED "CW S31 1/16 CS BT" ON A SINGLE BLAZE.

Sketch of Monument, Accessories, and General Area

Location & Comments

CORNER IS AT NE CORNER OF STANDING TIMBER AND AT SE CORNER OF USFS CLEAR CUT # 29-1W-31-3 APPROXIMATELY 350 FT. EAST OF USFS ROAD # 2810

Comp. Declin. 19 1/2° E  
Agency DOUGLAS CO. SURVEYOR'S OFFICE  
Party Chief JIM LANDRUM, L.S. 2024  
Notekeeper LEONARD HERZSTEIN  
Witnesses LEONARD HERZSTEIN

REGISTERED Surveyor's Seal  
PROFESSIONAL LAND SURVEYOR

*Jim Landrum*  
OREGON  
FEBRUARY 4, 1983  
JAMES N. LANDRUM  
2024