

GOVERNMENT CORNER RESTORATION FORM

Township 29S Range 1W Sec. 31 County DOUGLAS

State OREGON Date JUNE 7, 1983 No. _____

Corner Designation


CENTER EAST 1/16 CORNER OF SECTION 31,
T29S - R1W.

- Condition Report Only
- Not Found
- Renewed
- Unrecorded
- Surveyed In
- Referenced Out

Previous Renewals M 49-43 REPAIRED BY SHANER

MONUMENT DETAIL

Monument(s) Found: (Condition and Source)
2" IRON POST, FIRMLY SET, PROJECTING
6" ABOVE THE GROUND, WITH BRASS CAP
MARKED AS SHOWN, SET BY BRUCE A.
SHANER, L.S. 430, IN 1973.

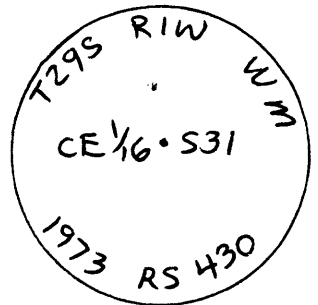

Accessories Found:

BTs MARKED BY SHANER IN 1973:
A 20" I. CEDAR STUMP, S38°W, 25 1/2 FT. WITH SCRIBE MARKS "BT" VISIBLE
ON PARTIALLY HEALED BLAZE AND A 1 1/2" BRASS WASHER, STAMPED "RS 430",
NAILED TO BASE OF BLAZE.
A 16" W. FIR, N51°W, 15 1/2 FT. WITH HEALED DOUBLE BLAZE.

#147 X

G. & E. No. 12/10-7c

