

GOVERNMENT CORNER RESTORATION FORM

Township 30 Range 1W Sec. 5 County DOUGLAS
 State OREGON Date JUNE 9, 1983 No. _____

Corner Designation


____ Condition Report Only
 ____ Not Found
 Renewed
 ____ Unrecorded
 ____ Surveyed In
 ____ Referenced Out

1, 97, 112-T29-1W

Previous Renewals: 6, 125, 132-T30-1W

MONUMENT DETAIL

Monument(s) Found: (Condition and Source)
2" IRON POST, FIRMLY SET, PROJECTING
8" ABOVE ~~THE GROUND~~ WITH BRASS 2 FT. MOUND OF STONE ^{LEH} 8-2-83
CAP MARKED AS SHOWN, SET BY
J.A. HOFFBUHR, L.S. 222, IN 1970.
ORIGINAL STONE SET ALONGSIDE WITH
NO MARKS VISIBLE. 1 1/4" IRON BOLT,
27" LONG (REN.#6) LAYS ALONGSIDE.

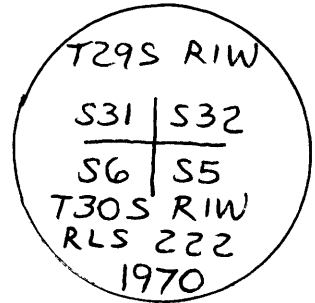

Accessories Found:

ORIGINAL BTS: (Rec 32.9)
A ROOTHOLE, N88°E, 363 FT. WITH 30" MADRONE LOG ALONGSIDE
WITH A ROTTED BLAZE.
A ROOTHOLE, S38°E, 329 FT. WITH 22" W. FIR LOG ALONGSIDE
WITH A ROTTED BLAZE.
A 34" D. FIR STUMP, N61°W, 256 FT. (REC. 251 FT.) WITH HEALED
DOUBLE BLAZE.

AND BTS MARKED BY JOHN MARKHAM, P.E. 2880,
IN 1960:
A 16" W. FIR, S11°W, 189 FT., WITH HEALED DOUBLE BLAZE.
A 10" B. OAK, N85°W, 96 FT., WITH HEALED BLAZE.

AND BT MARKED BY BRUCE A. SHANER, L.S. 430, IN 1973:
A 10" D. FIR, N12 1/2°E, 458 FT., WITH HEALED DOUBLE BLAZE.

*219 T30-1W
 #143 T29-1W

G.L. No. 62/10-8
 C

