

GOVERNMENT CORNER RESTORATION FORM

Township 30S Range 1W Sec. 5 County DOUGLAS

State OREGON Date JUNE 20, 1983 No. \_\_\_\_\_

Corner Designation


QUARTER CORNER TO SECTION 32, T29S-R1W  
AND SECTION 5, T30S-R1W.

- Condition Report Only
- Not Found
- Renewed
- Unrecorded
- Surveyed In
- Referenced Out

Previous Renewals 127T30-1 #100 T29-1

MONUMENT DETAIL

Monument(s) Found: (Condition and Source)  
2" IRON POST, FIRMLY SET, PROJECTING 6" ABOVE THE GROUND WITH A 2 1/2" BRASS ROCK TABLET LAYING ON TOP MARKED AS SHOWN (WELDS BROKE OFF), SET BY J.A. HOFFBUHR, L.S. 222, IN 1970. ORIGINAL STONE SET ALONGSIDE I.P. WITH NO MARKS VISIBLE.

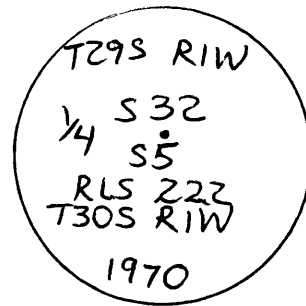

Accessories Found:

REMAINS OF ORIGINAL BTS:  
A ROOTHOLE, S34°E, 25 1/2 FT. (REC. S34°W) WITH 30" D. FIR LOG ALONGSIDE WITH HEAVED BLAZE.  
A ROOTHOLE, N57°W, 10 1/2 FT. WITH A 30" D. FIR STUMP ALONGSIDE WITH HEAVED BLAZE.

AND BTS MARKED BY HOFFBUHR IN 1970:  
A 8" D. FIR, N70°4'E, 36 3/4 FT. WITH SCRIBE MARKS VISIBLE ON SINGLE BLAZE.  
A 9" W. FIR, S64°W, 14 1/2 FT. WITH HEAVED DOUBLE BLAZE.

#218 T30-1 ✓  
#111 T29-1 ✓

S. File No. 62/10-9c

RENEWAL

Monument Set (Procedure and Description)

I CEMENTED ROCK TABLET TO IRON POST.

Monument Detail

New Accessories

NONE

Sketch of Monument, Accessories, and General Area

Location & Comments

Comp. Declin. 20°E  
Agency DOUGLAS CO. SURVEYOR'S OFFICE  
Party Chief JIM LANDRUM, L.S. 2024  
Notekeeper LEONARD HERZSTEIN  
Witnesses LEONARD HERZSTEIN

REGISTERED  
PROFESSIONAL  
LAND SURVEYOR

*Jim Landrum*

OREGON  
FEBRUARY 4, 1983  
JAMES N. LANDRUM  
2024

OK  
JEM  
Seal