

GOVERNMENT CORNER RESTORATION FORM

Township 30S Range 1W Sec. 7 County DOUGLAS  
 State OREGON Date JUNE 16, 1983 No. \_\_\_\_\_

Corner Designation

QUARTER CORNER TO SECTION 7  
 T30S, R1W, ONLY.

\_\_\_\_ Condition Report Only  
 \_\_\_\_ Not Found  
 Renewed  
 \_\_\_\_ Unrecorded  
 \_\_\_\_ Surveyed In  
 \_\_\_\_ Referenced Out


Previous Renewals 36 T30-1 # 97 T30-2

MONUMENT DETAIL

Monument(s) Found: (Condition and Source)

30" NW  
ORIGINAL 36" D. FIR CORNER TREE WITH  
NO SCRIBE MARKS VISIBLE ON  
PREVIOUSLY OPENED BLAZE ON WEST  
SIDE AND A HEALED BLAZE ON  
EAST SIDE.

REFERENCE MONUMENT.

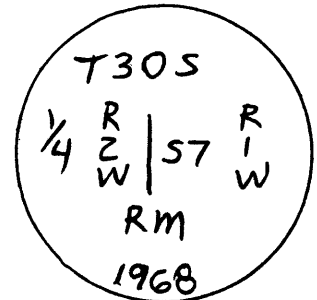

Accessories Found:

ORIGINAL BTS:  
A 22" P. PINE SNAG, N7°E, 23.8 FT., WITH HEALED BLAZE.  
A 12" B. OAK, S85°E, 20.5 FT., WITH HEALED BLAZE  
AND A REFERENCE MONUMENT SET BY JOHN POWELL, DEPUTY  
DOUGLAS COUNTY SURVEYOR, IN 1968:  
A 1 1/4" IRON POST, FIRMLY SET, PROJECTING 6" ABOVE THE GROUND,  
WITH BRASS CAP MARKED AS ABOVE, BEARS EAST, 12 FT.  
THE 1/4 CORNER OF SECTION 12 ONLY, T30S, R2W WHICH IS A BRASS CAP,  
BEARS SOUTH, 33° FT.

#217 T30-1 ✓  
 #216 T30-2 ✓

C. L. B. No. 6210-10 C

RENEWAL

Monument Set (Procedure and Description)

Monument Detail

NONE

New Accessories

I ADD MARKS "RM" ABOVE THE DATE TO THE BRASS CAP.  
I MARK A NEW BT:  
A 9" D. FIR, N50°E, 74° FT., SCRIBED "1/4 57 CS BT" ON A SINGLE BLAZE.

Sketch of Monument, Accessories, and General Area

Location & Comments

Comp. Declin. 20°E  
Agency DOUGLAS CO. SURVEYOR'S OFFICE  
Party Chief JIM LANDRUM, L.S. 2024  
Notekeeper LEONARD HERZSTEIN  
Witnesses LEONARD HERZSTEIN

ok  
JLM

REGISTERED Surveyor's Seal  
PROFESSIONAL  
LAND SURVEYOR

*Jim Landrum*

OREGON  
FEBRUARY 4, 1983  
JAMES N. LANDRUM  
2024