

GOVERNMENT CORNER RESTORATION FORM

Township 31S Range 1W Sec. 17 County DOUGLAS

State OREGON Date JUNE 21, 1983 No. \_\_\_\_\_

Corner Designation

1/4 CORNER TO SECTIONS 16 & 17, T31S, R1W.


- Condition Report Only
- Not Found
- Renewed
- Unrecorded
- Surveyed In
- Referenced Out

Previous Renewals 16

Monument(s) Found: (Condition and Source)

1 1/4" IRON POST, FIRMLY SET, PROJECTING  
12" ABOVE A 3FT. DIAMETER MOUND OF  
STONE, SET BY JOHN POWELL, DEPUTY  
COUNTY SURVEYOR, IN 1966.

MONUMENT DETAIL

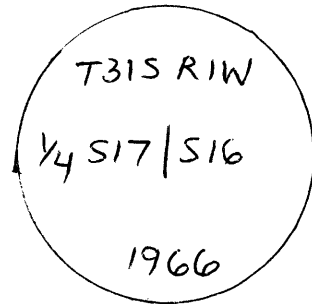

Accessories Found:

REMAINING ORIGINAL BT:  
AN 18" B. OAK, N15°E, 238 FT. (REC: W. OAK, 23 1/2 FT. TO FACE) WITH  
HEALED BLAZE, AND RESCRIBED BY POWELL IN 1966 WITH A  
HEALED BLAZE.

AND BT MARKED BY POWELL IN 1966:  
A 8" D. FIR STUMP, N27°W, 24 1/2 FT. WITH A HEALED BLAZE.

#200 X

S. File No. 6210-11 C

