

GOVERNMENT CORNER RESTORATION FORM

Township 30S Range 2W Sec. 12 County DOUGLAS

State OREGON Date JUNE 21, 1983 No. _____

Corner Designation

SECTION CORNER TO SECTIONS 11 & 12 ONLY,
T30S, RTW. R2W

- Condition Report Only
- Not Found
- Renewed
- Unrecorded
- Surveyed In
- Referenced Out

Previous Renewals 36

MONUMENT DETAIL

Monument(s) Found: (Condition and Source)

1" IRON PIPE, FIRMLY SET, PROJECTING
22" ABOVE THE GROUND, SET BY JOHN
MARKHAM, P.E. 2880,
IN 1959. ORIGINAL CORNER STONE 6" X
4" X 8" ON TOP OF THE GROUND, ALONG-
SIDE IRON PIPE, WITH NO MARKS VISIBLE.
I USED IRON PIPE AS CORNER POINT, AS
IT IS THE ONLY SOLID POINT IN THE
GROUND.

Accessories Found:

REMAINING ORIGINAL BT:
A ROOT HOLE, N41°E, 27 1/2 FT. WITH 20" MADRONE LOG ALONGSIDE WITH
DECAYED BLAZE.

AND BTS MARKED BY MARKHAM IN 1959:
A 12" D. FIR STUMP, S4°W, 19 1/2 FT. WITH HEALED BLAZE.
A 11" D. FIR STUMP, S80°W, 8° FT. WITH HEALED BLAZE.
A 14" MADRONE SNAG, N52°W, 39° FT. WITH SCRIBE MARKS
"S11 R W" VISIBLE ON PREVIOUSLY OPENED BLAZE.
A 12" D. FIR STUMP, N5°W, 33 1/2 FT. WITH HEALED BLAZE.

SECTION CORNER TO SECTIONS 13 & 14 ONLY, BEARS S67 1/2°W, 119° FT.

#247X

G. & E. File No. 62/10-12


C

RENEWAL

Monument Set (Procedure and Description)

I REMOVE 1" X 40" IRON PIPE AND IN ITS PLACE I SET A 2" IRON POST, 30" LONG, 1 1/2" TO BEDROCK AND BUILT A 2 FT. DIAMETER MOUND OF STONE TO WITHIN 6" OF BRASS CAP, WITH BRASS CAP MARKED AS SHOWN. IRON PIPE AND ORIGINAL STONE ARE BURIED ALONGSIDE.

Monument Detail

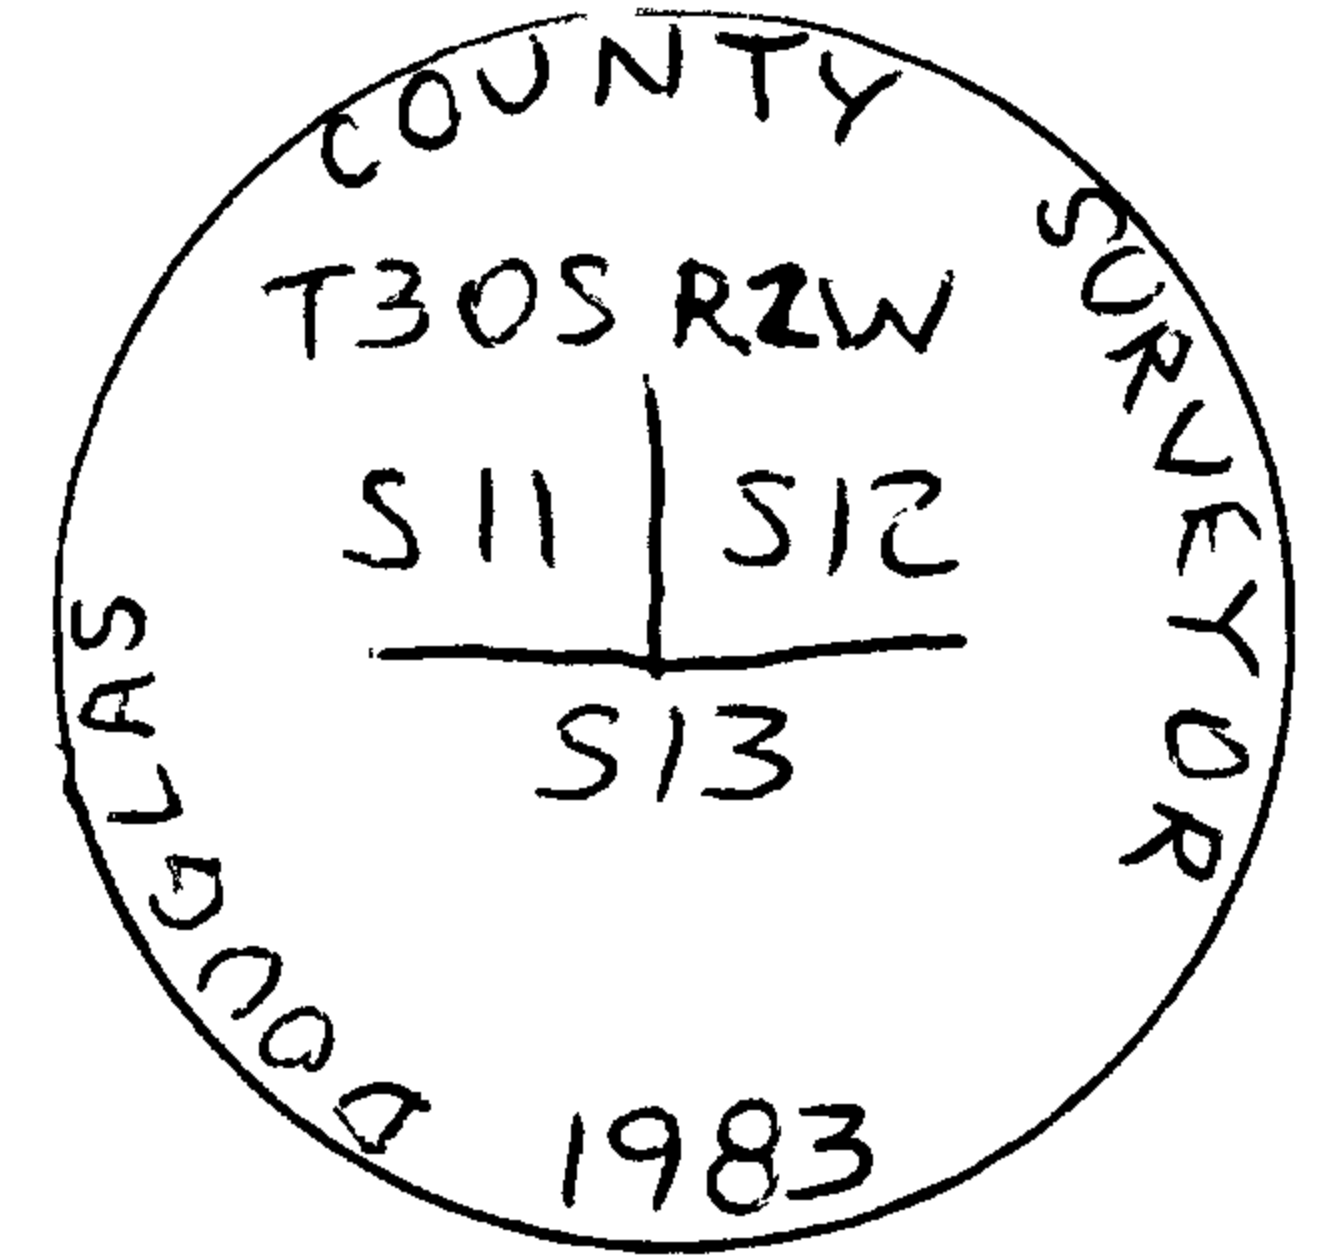

New Accessories

I MARK NEW BTS:
A 7" D. FIR, N73°E, 35 1/2 FT., SCRIBED "T30S R2W S12 CS BT" ON A SINGLE BLAZE.
A 9" D. FIR, N43°W, 41 1/2 FT., SCRIBED "T30S R2W S11 CS BT" ON A SINGLE BLAZE.

Sketch of Monument, Accessories, and General Area

Location & Comments

STEEL FENCE POST WITH US FS SIGNS # 54-2 & 54-4 ATTACHED, BEARS EAST, 1 1/2 FT., CAUSING LOCAL ATTRACTION.

Comp. Declin. 08 1/2° E
Agency DOUGLAS CO. SURVEYOR'S OFFICE
Party Chief JIM LANDRUM, DEPUTY
Notekeeper LEONARD HERZSTEIN
Witnesses LEONARD HERZSTEIN

REGISTERED Surveyor's Seal
PROFESSIONAL
LAND SURVEYOR

Jim Landrum

OREGON
FEBRUARY 4, 1983
JAMES N. LANDRUM
2024