

GOVERNMENT CORNER RESTORATION FORM

Township 30S Range 2W Sec. 13 County DOUGLAS

State OREGON Date JUNE 21, 1983 No. _____

Corner Designation

SECTION CORNER TO SECTIONS 13 & 14 ONLY,
T30S, R2W.

- _____ Condition Report Only
- _____ Not Found
- Renewed
- _____ Unrecorded
- _____ Surveyed In
- _____ Referenced Out

Previous Renewals 37

MONUMENT DETAIL

Monument(s) Found:	(Condition and Source)
ORIGINAL CORNER STONE 5" X 8" PROJECTING 4" ABOVE GROUND, FIRMLY SET, WITH "+" ON TOP. 1" IRON ROD WITH PIECE OF IRON WELDED ON NORTHERLY SIDE, FIRMLY SET, PROJECTING 10" ABOVE THE GROUND, SET BY JOHN MARKHAM, P.E. 2880. IN 1959, BEARS N60°W, 03 FT. FROM THE "+". I USED "+" ON ORIGINAL STONE AS CORNER POINT, AS IT DOESNT APPEAR TO HAVE BEEN REMOVED BY MARKHAM.	

Accessories Found:

- REMAINS OF ORIGINAL BT:
- A MADRONE ROOTCROWN, SIZE INDETERMINATE, S76 1/2°E, 105 FT.
- AND BITS MARKED BY MARKHAM IN 1959:
- A 14" MADRONE SNAG, N11°E, 108 FT. WITH SCRIBE MARKS "S11 BT" VISIBLE ON PARTIALLY HEALED DOUBLE BLAZE.
 - A 12" D. FIR, N33°E, 93 FT. WITH HEALED DOUBLE BLAZE.
 - A 36" D. FIR STUMP, S24°E, 210 FT. WITH SCRIBE MARKS "S13" VISIBLE ON PARTIALLY HEALED UPPER BLAZE AND BARK SCRIBES "BT" VISIBLE ON LOWER BARK BLAZE.
 - A 12" MADRONE SNAG, S72°W, 640 FT. WITH HEALED BLAZE.

SECTION CORNER TO SECTIONS 11 & 12 ONLY, BEARS N87 1/2°E, 1190 FT.

#248X


GLENN 12/10-13C

RENEWAL

Monument Set (Procedure and Description)

Monument Detail

I REMOVE 5" X 8" X 14" ORIGINAL CORNER STONE AND IN ITS PLACE I SET A 2" IRON POST, 30" LONG, SET 28" IN THE GROUND. 1" X 37" IRON ROD WAS BURIED INSIDE IRON POST AND THE ORIGINAL CORNER STONE WAS BURIED ALONGSIDE. BRASS CAP ON IRON POST IS MARKED AS SHOWN.

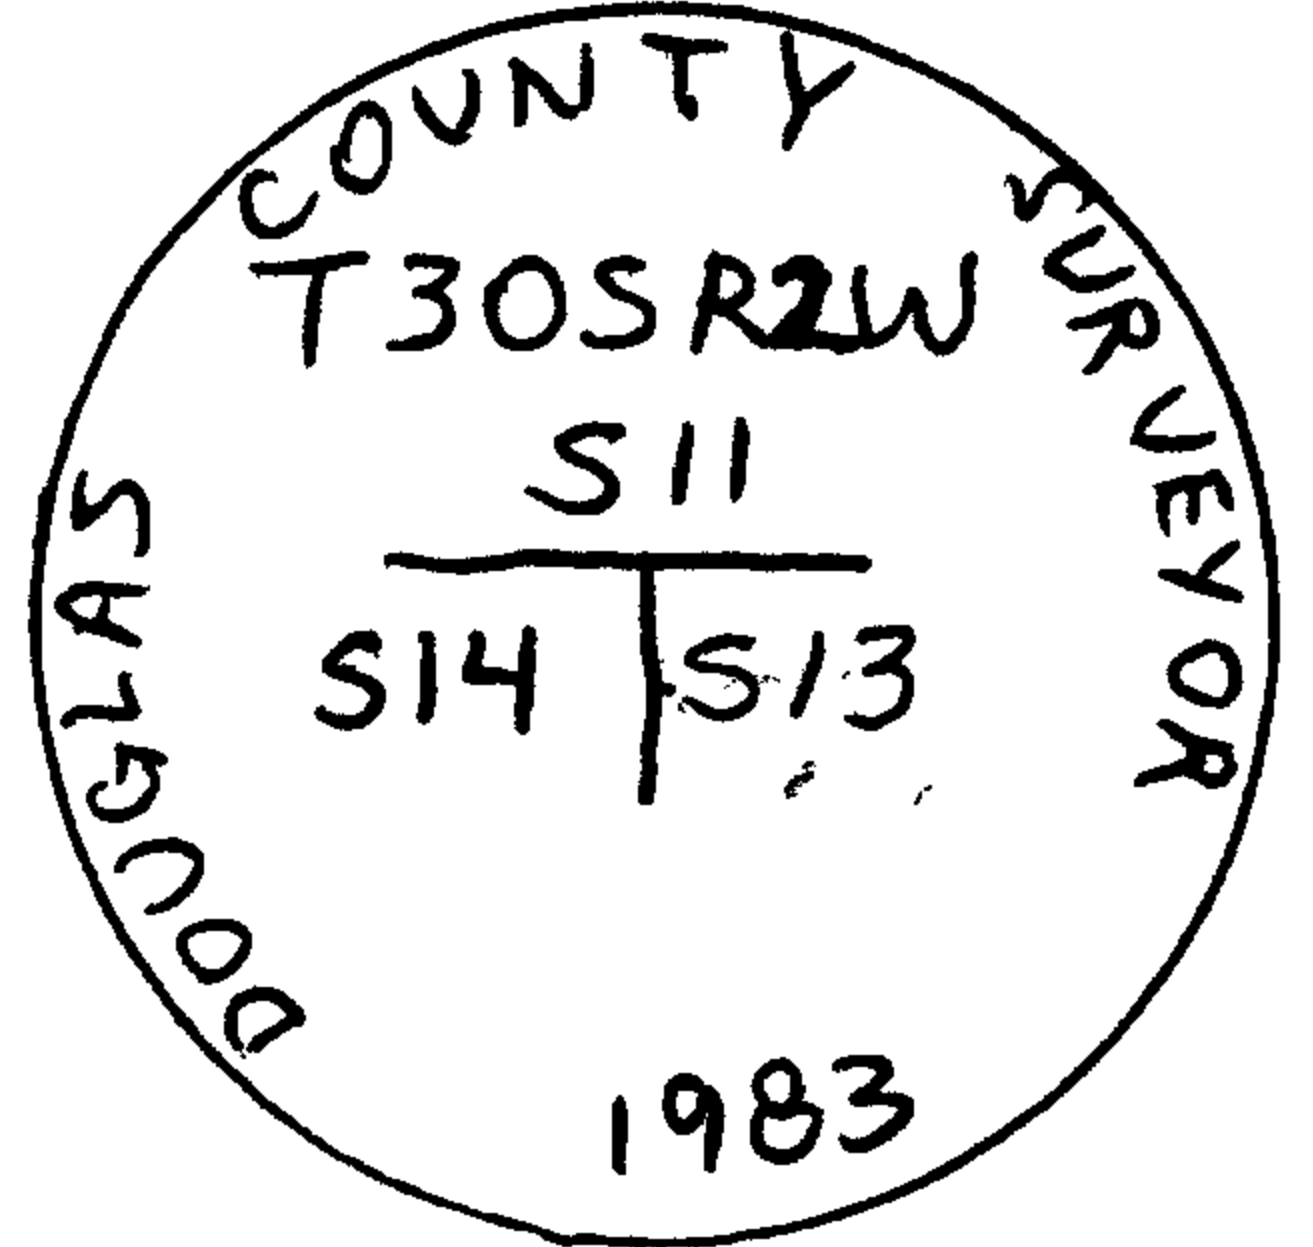

New Accessories

I MARK NEW BTS:
A 12" D. FIR, S10°E, 288 FT., SCRIBED "T30SR2WS13 CS BT" ON A SINGLE BLAZE. BASE OF BLAZE IS 2 FT. ABOVE GROUND.
A 8" D. FIR, S15½°W, 308 FT., SCRIBED "T30SR2WS14 CS BT" ON A SINGLE BLAZE.

Sketch of Monument, Accessories, and General Area

Location & Comments

STEEL FENCE POST SET WITH U.S.F.S. SIGNS # 54-2 & 54-4 ATTACHED BEARS SOUTH, 18 FT. CAUSING THE LOCAL ATTRACTION. SCRIBE MARKS BY MARKHAM ARE MARKED STARTING FROM BOTTOM TO TOP.

Comp. Declin. 15½°E
Agency DOUGLAS CO SURVEYOR'S OFFICE
Party Chief JIM LANDRUM, DEPUTY
Notekeeper LEONARD HERZSTEIN
Witnesses LEONARD HERZSTEIN

REGISTERED Surveyor's Seal
PROFESSIONAL
LAND SURVEYOR

Jim Landrum
OREGON
FEBRUARY 4, 1983
JAMES N. LANDRUM
2024