

GOVERNMENT CORNER RESTORATION FORM

Township 31S Range 1E Sec. 4 & 9 County DOUGLAS

State OREGON Date MAY 18, 1983 No. _____

Corner Designation

QUARTER CORNER TO SECTIONS 4 & 9,
T31S - R1E.


- Condition Report Only
- Not Found
- Renewed
- Unrecorded
- Surveyed In
- Referenced Out

Previous Renewals

Monument(s) Found: (Condition and Source)

1" DIAMETER IRON POST, FIRMLY SET, PROJECTING 3" ABOVE A 2' DIAMETER MOUND OF STONE, WITH BRASS CAP MARKED AS SHOWN, SET BY G.L.O. IN 1923.

MONUMENT DETAIL

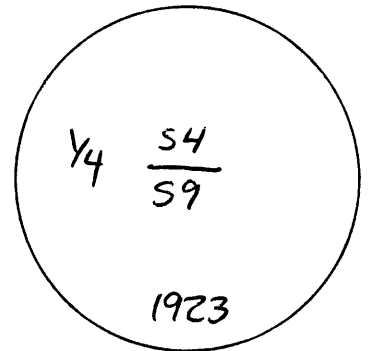

Accessories Found:

REMAINING ORIGINAL BT:
A - FIR SNAG, SIZE INDETERMINATE, N68°W, 7³ FT., WITH NO MARKS VISIBLE.

#2 ✓

GLENNA 6/2/16-17c

